


PLAN	DATE	BY	CHKD
DESIGNED	11/10	NOV	NOV
CHECKED	11/10	NOV	NOV
APPROVED	11/10	NOV	NOV
NO. OF SHEETS	170		
SHEET NO.	111		
DATE CHECKED			
BY			

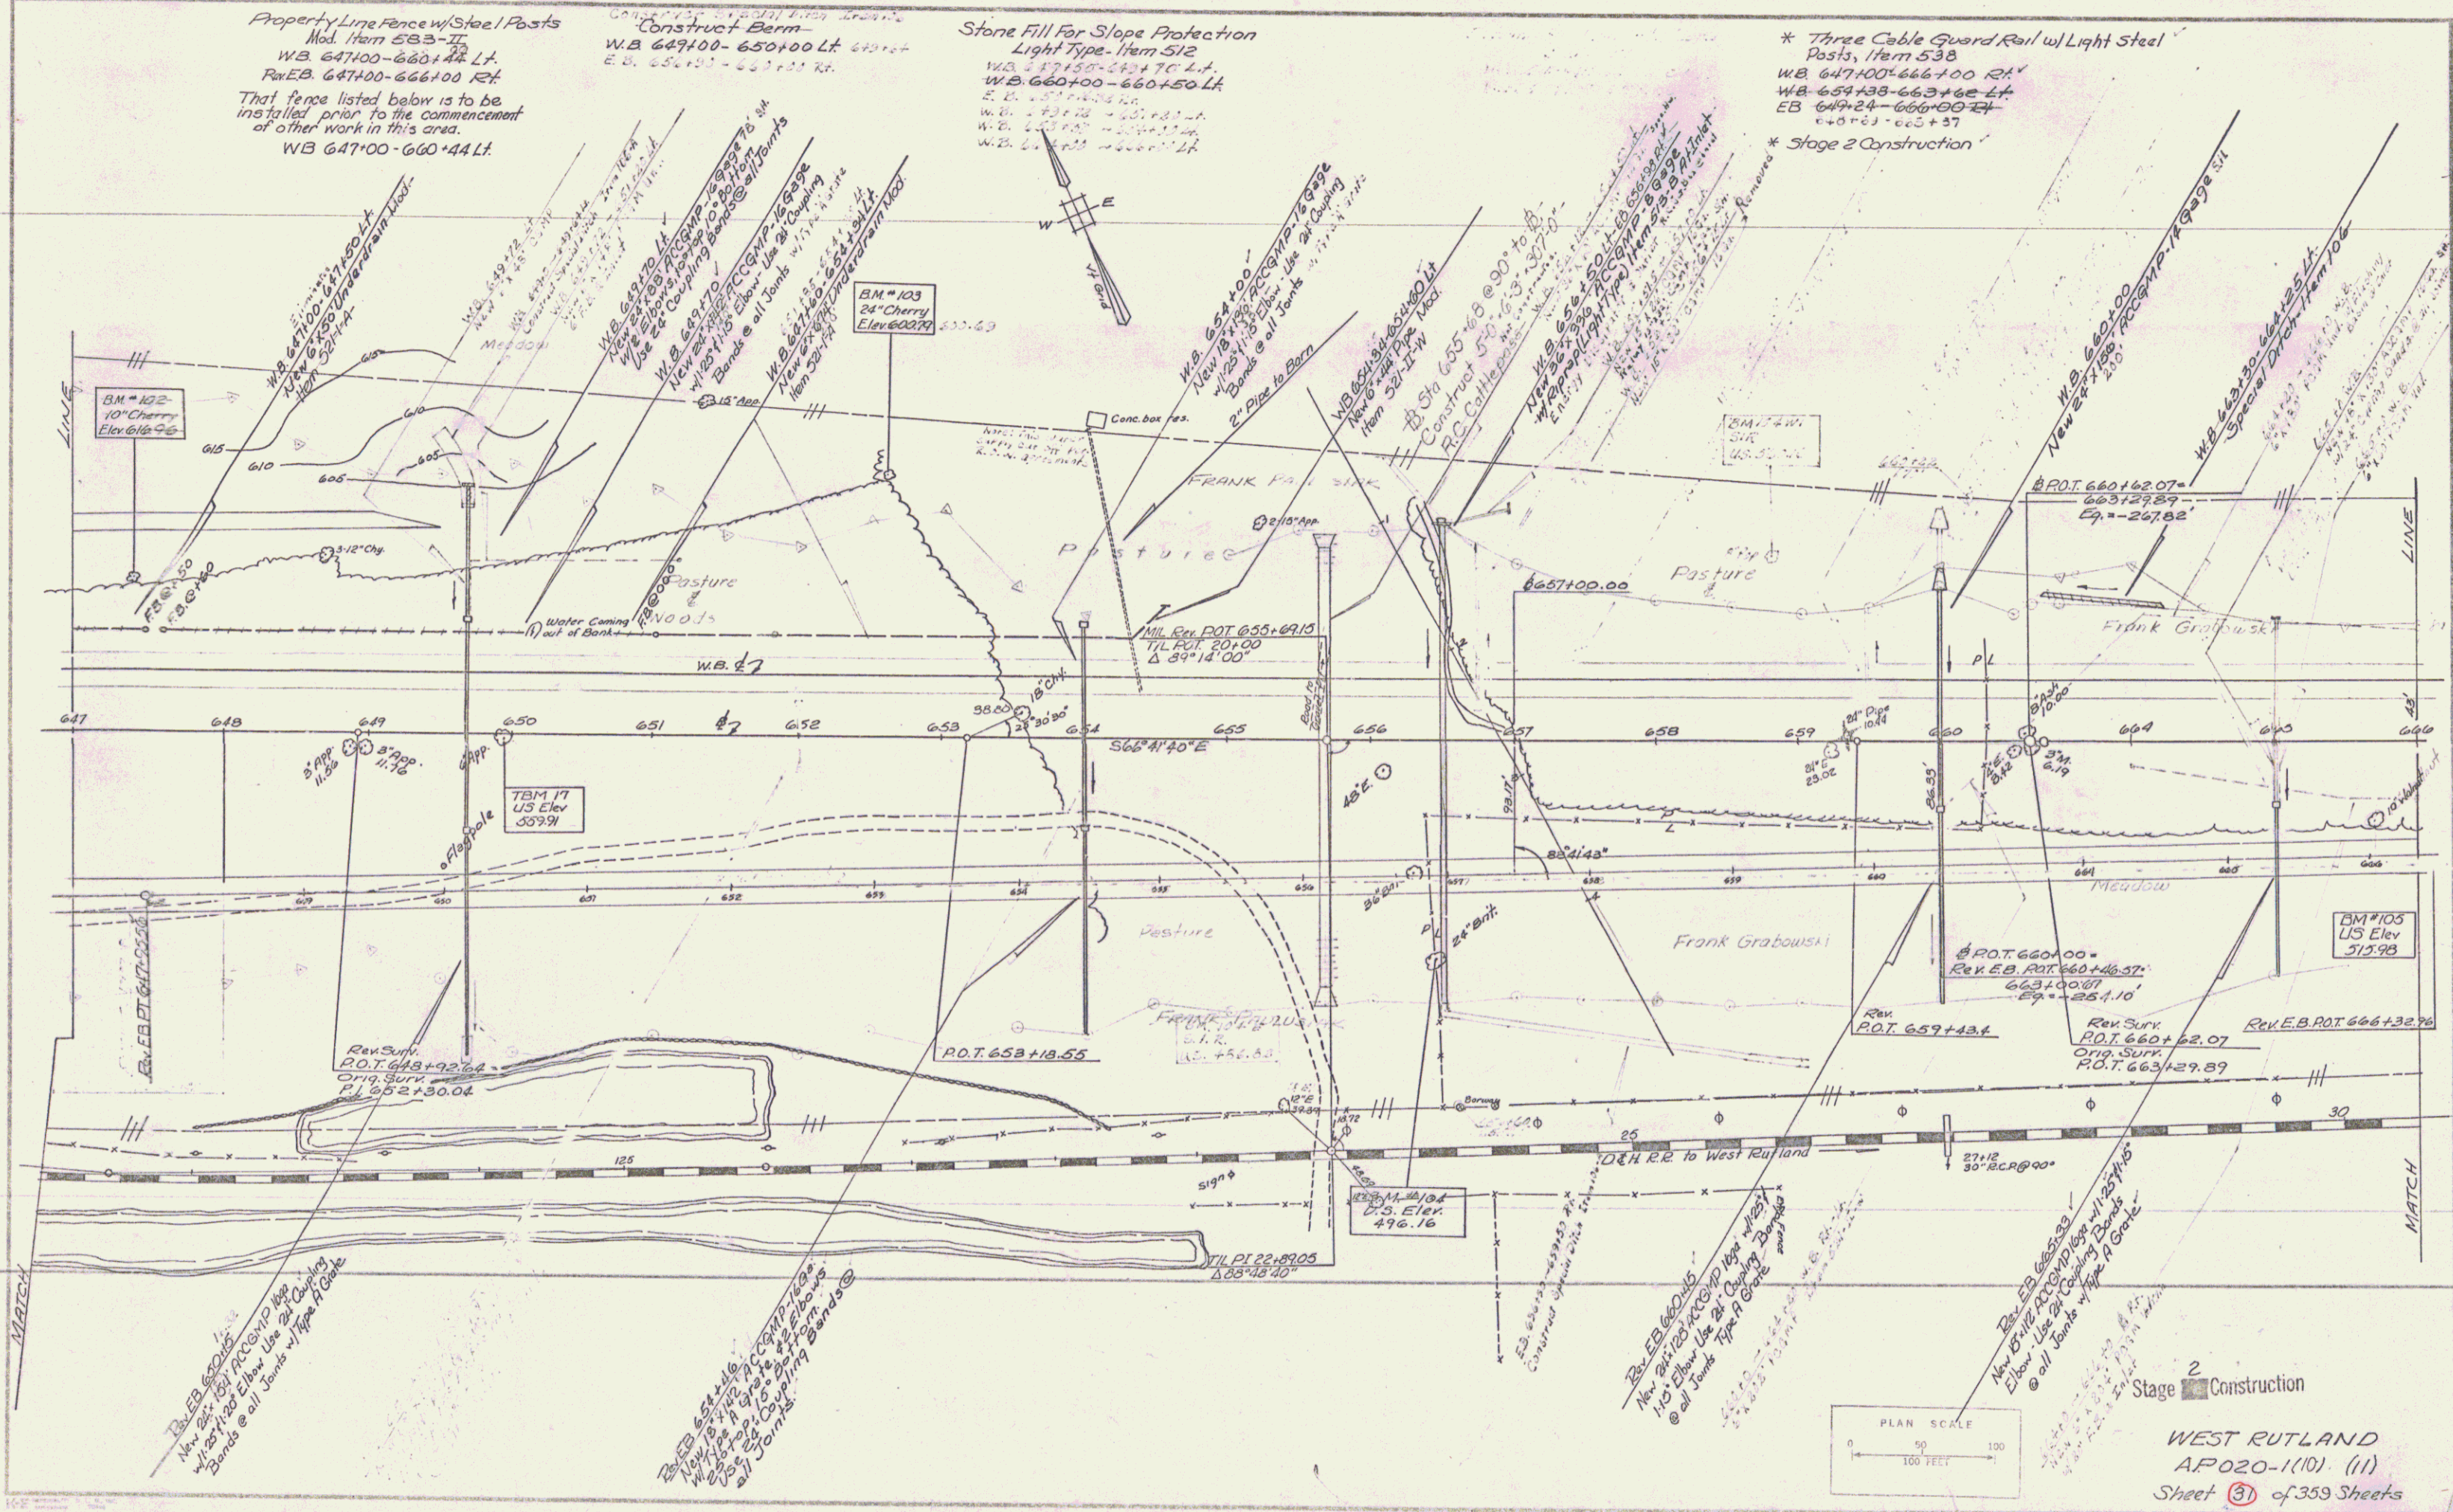

Property Line Fence w/ Steel Posts  
 Mod. Item 533-II  
 W.B. 647100-660+44 Lt.  
 Rev EB. 647100-666+00 RA  
 That fence listed below is to be installed prior to the commencement of other work in this area.  
 W.B. 647100-660+44 Lt.

Construct Berm  
 W.B. 647100-650+00 Lt.  
 E.B. 650+00-653+37 RA

Stone Fill For Slope Protection  
 Light Type - Item 512  
 W.B. 660+00-660+70 Lt.  
 W.B. 660+00-660+50 Lt.  
 E.B. 660+00-660+50 Lt.  
 W.B. 660+00-660+50 Lt.  
 W.B. 660+00-660+50 Lt.

\* Three Cable Guard Rail w/ Light Steel Posts, Item 538  
 W.B. 647100-666+00 RA  
 W.B. 654+33-663+66 Lt.  
 EB 649+24-666+00 RA  
 e-b-63-663+37  
 \* Stage 2 Construction

Stage 2 Construction

WEST RUTLAND  
 AP020-1(10) (11)  
 Sheet 111 of 359 Sheets

Sheet 90 of 170 Sheets