

DRILLING & BLASTING OF SOLID ROCK
SUB GRADE ITEM 115
E.B. 672 - 676 - 681
W.B. 679 - 682


PROPERTY LINE FENCE W/
STEEL POSTS MOD. ITEM 583-11
Rev EB 666+00 - 682+00 Rf
WB 666+00 - 682+00 Lf

STONE PILE FOR SLOPE PROTECTION,
SHORT TYPE, ITEM 512
WB 673+40 - 681+33 Lf

TREATED TIMBER CURB, ITEM 554
*BH. CONC-CURB-
ITEM 555
EB 677+00 - 682+00 Rf
54

*THREE CABLE GUARD RAIL w/ Light Steel Posts
ITEM 538
WB 666+00 - 682+00 Rf
EB 666+00 - 682+00 Rf
6.2+05
* Stage 2 Construction


DRILLING & BLASTING OF SOLID ROCK
ITEM 114
677+25 - 679+50 Rf
679+00 - 680+33 Rf

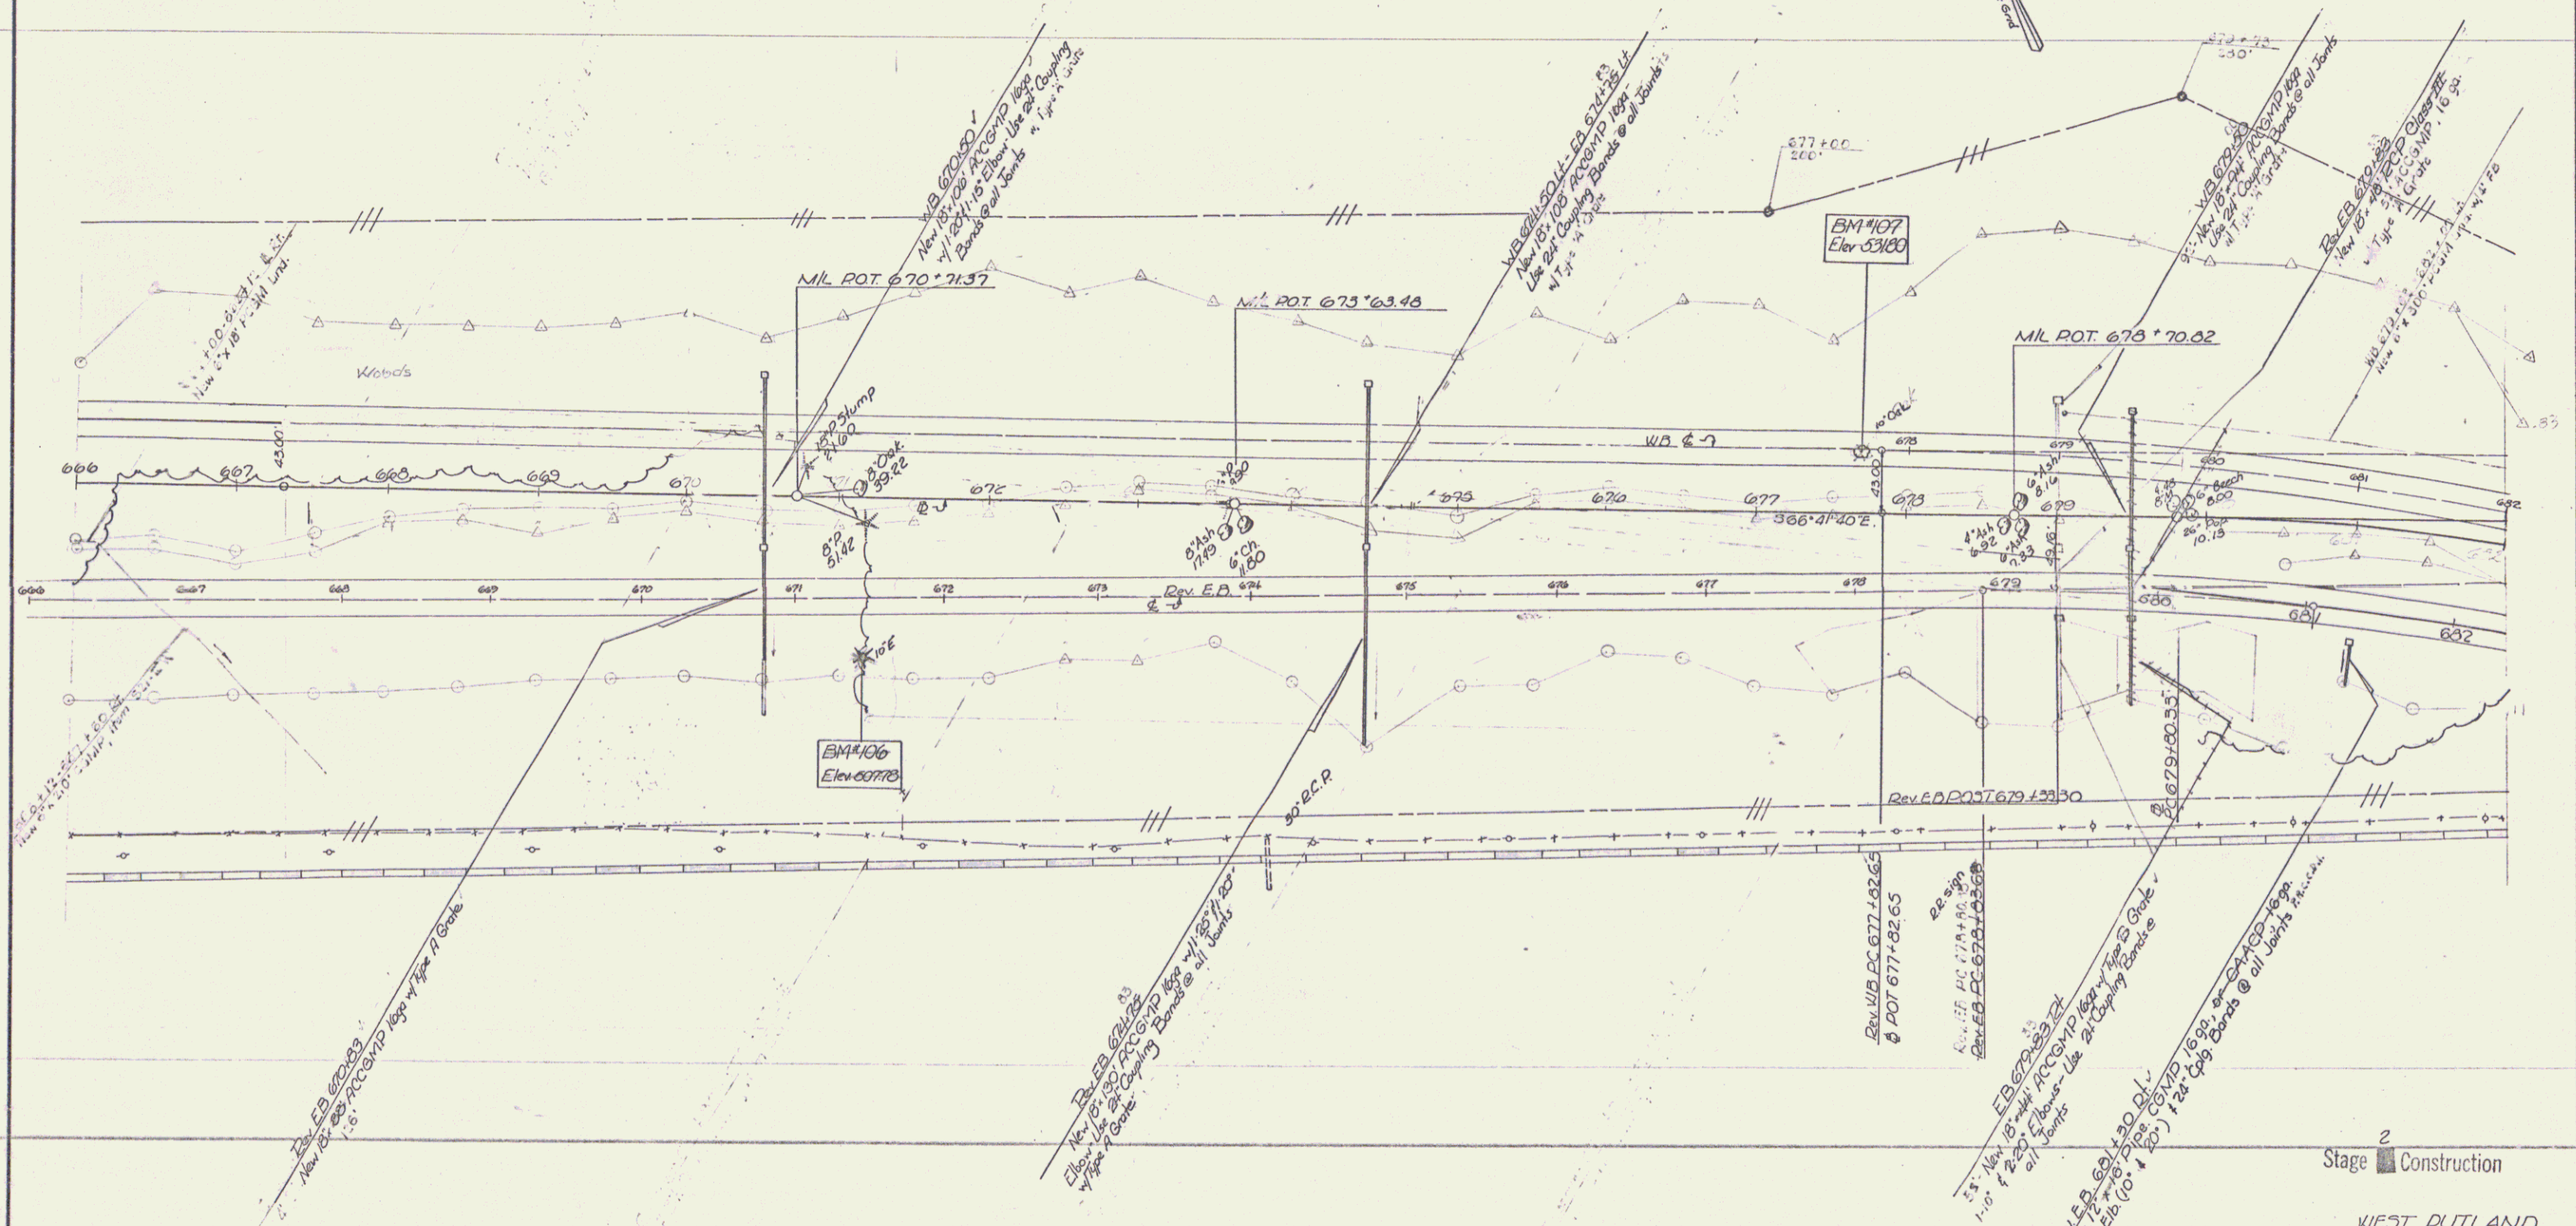

Stage 2 Construction

WEST DUTLAND

SURVEYED BY: _____ DATE: _____
DRAWN BY: _____ DATE: _____
TRACED BY: L. Clark DATE: 11/04

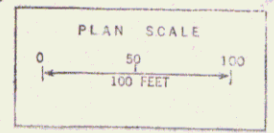

PROJ. AP NO. 020-1(11)
SHEET 33 OF 359

Sheet 92 of 170 Sheets 5