
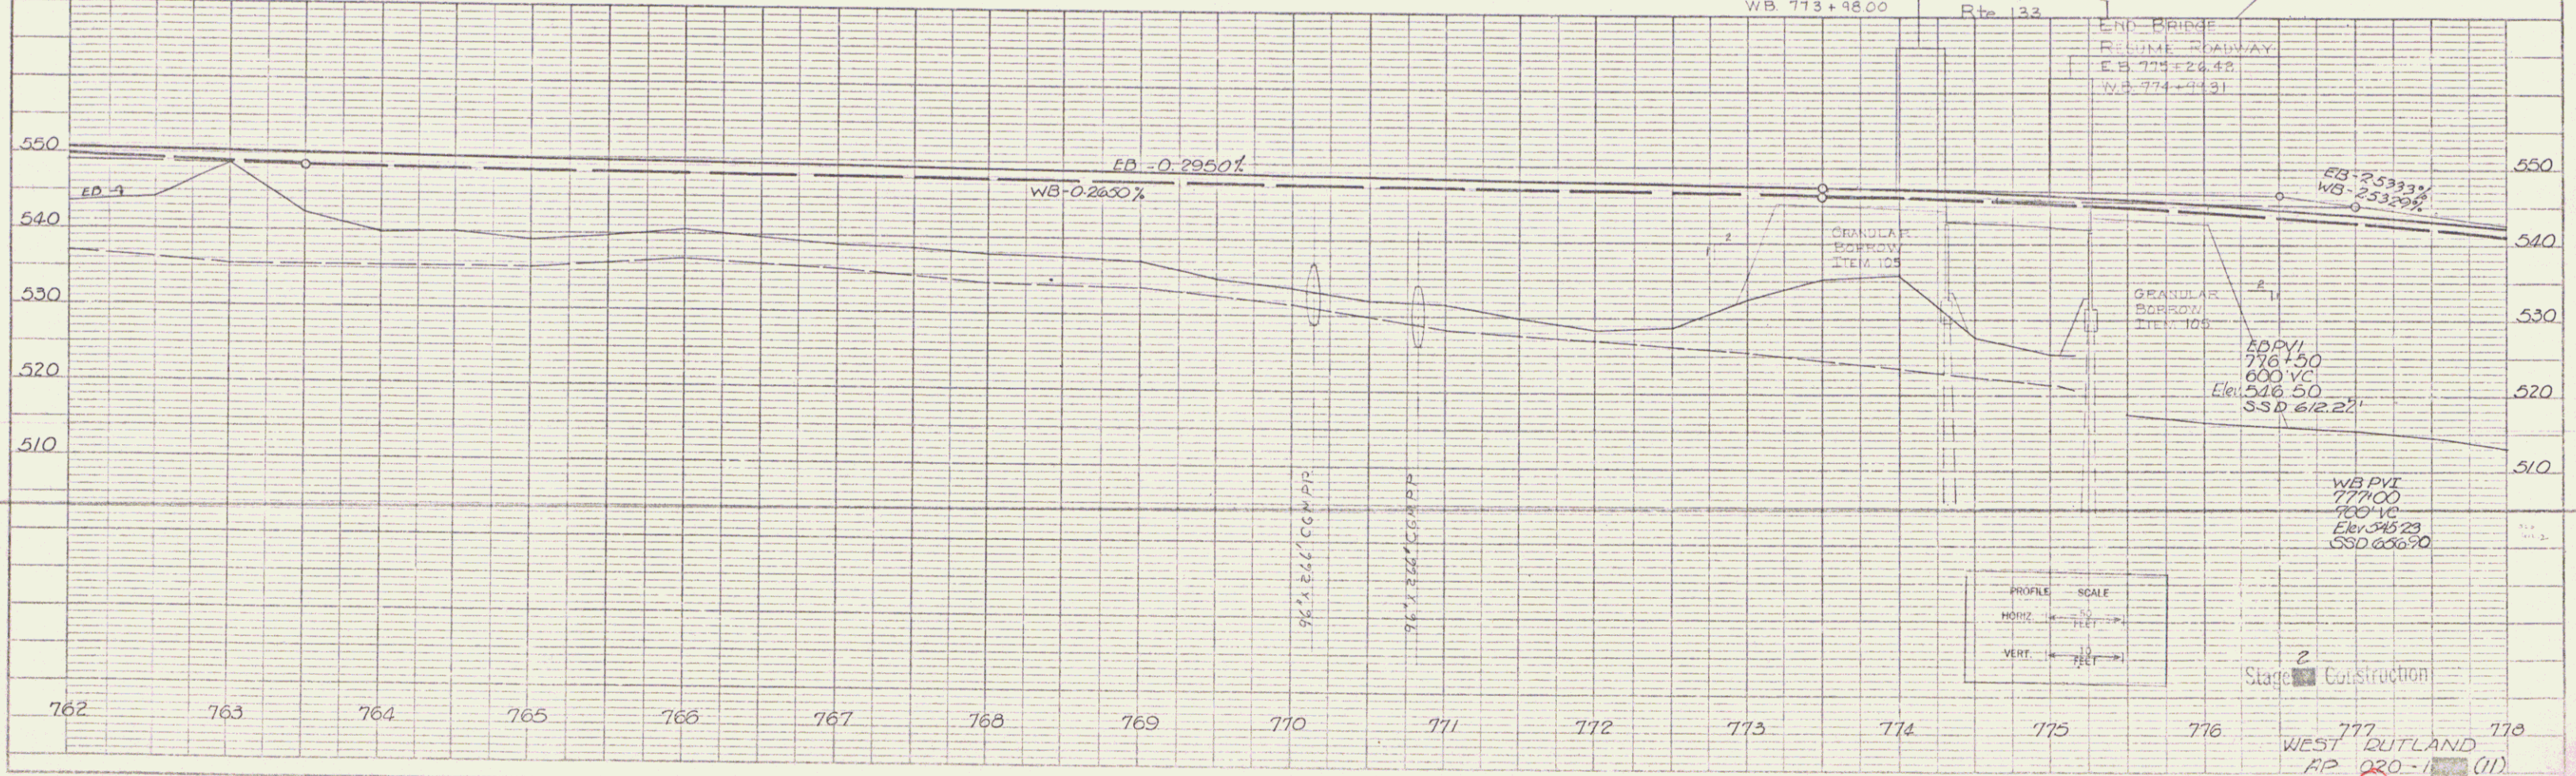


PLAN  
 DATE: 10/1/54  
 DRAWN BY: J. J. [unclear]  
 CHECKED BY: [unclear]  
 NO. 105 of 170 SHEETS

PROFILE  
 DATE: 10/1/54  
 DRAWN BY: J. J. [unclear]  
 CHECKED BY: [unclear]  
 NO. 105 of 170 SHEETS

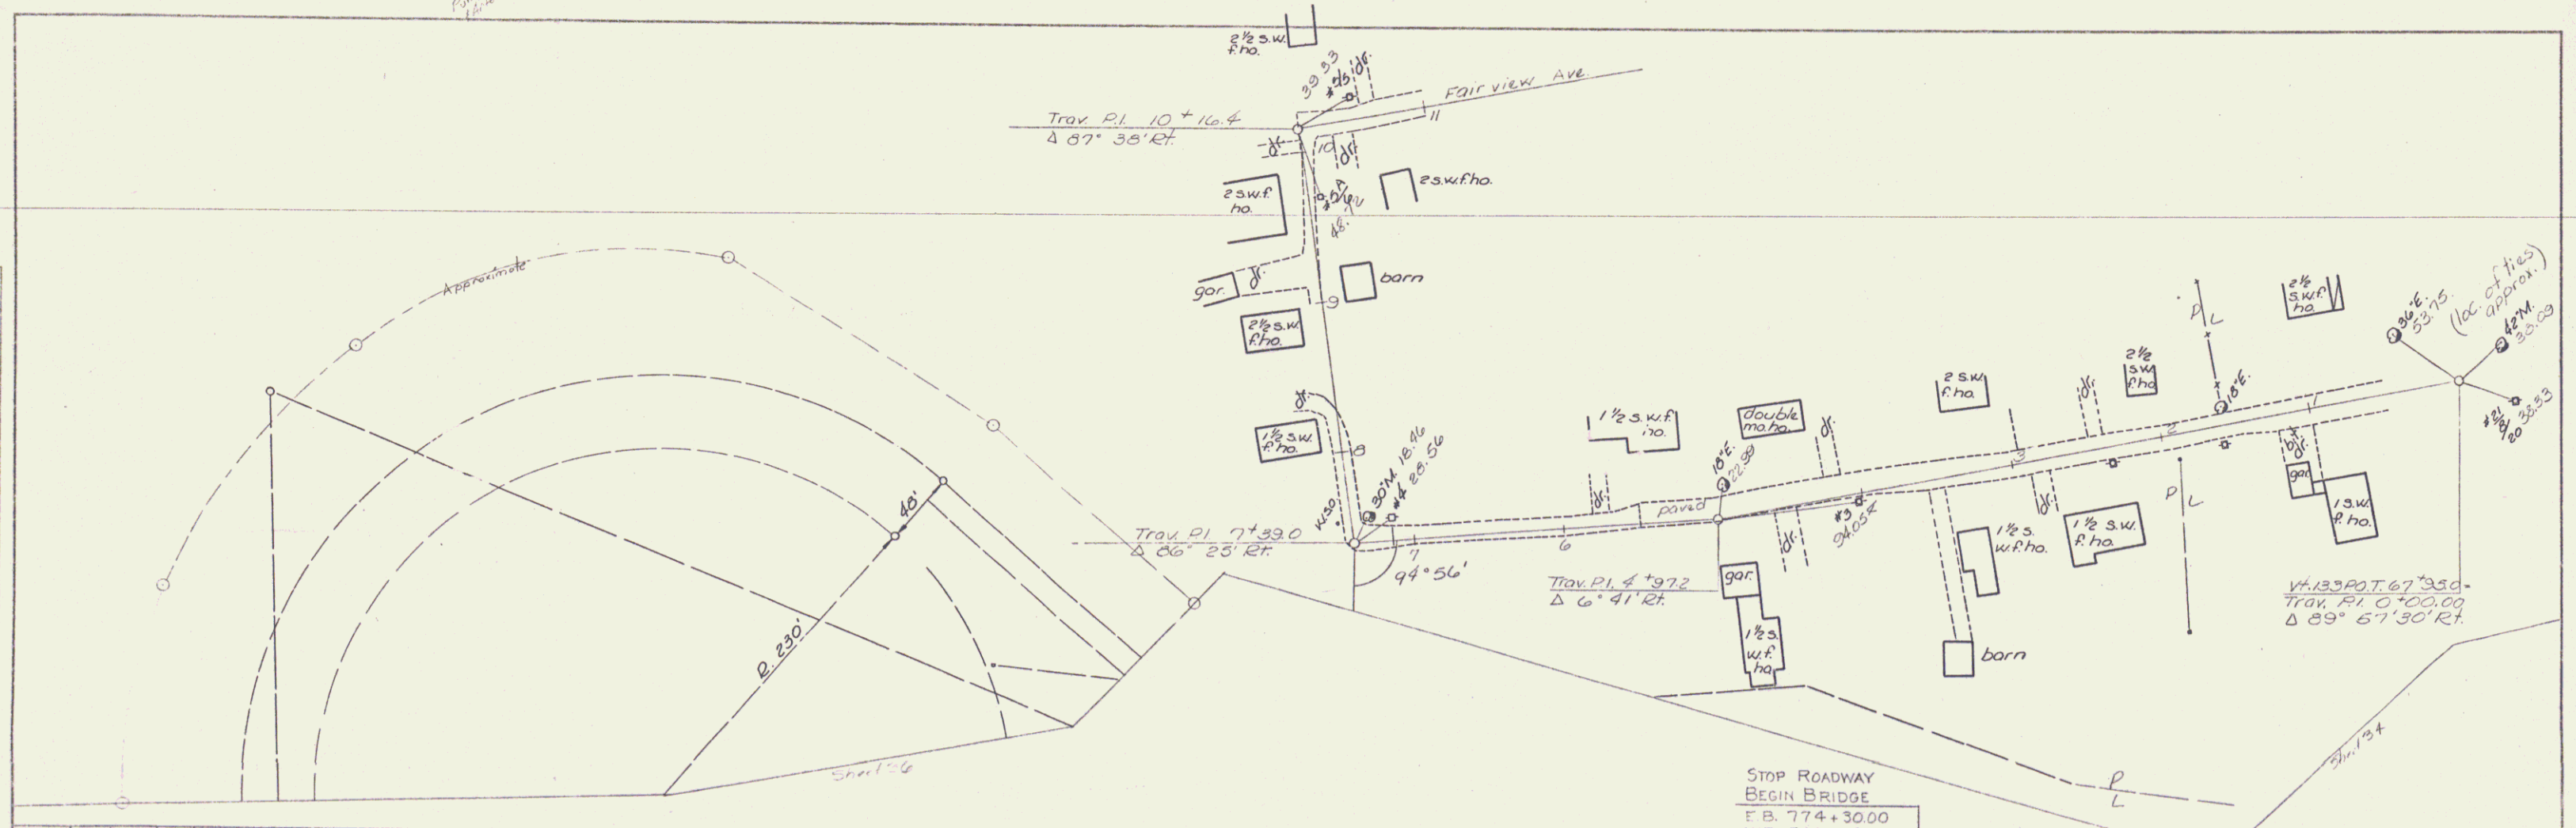

K&E PLAN 1, PLAN PROFILE  
 SCALE 1/4" = 100' HORIZ  
 SCALE 1" = 10' VERT

WEST DUTLAND  
 RP 020-100 (11)  
 Sheet 105 of 170 Sheets