



MUCK EXCAVATION ITEM 117 ✓
EB 75+00-802+00

GRANITE SLOPE EDGING ITEM 536A*
791+00-802+00 Lt Rt Med

PROPERTY LINE FENCE W/ STEEL ✓
POSTS MOD ITEM 583-II
EB 791+00-802+00 RE
WB 791+00-802+00 LT


SPECIAL DITCH, ITEM 103 ✓
796+00-800+00 N<

* STAGE 2 CONSTRUCTION

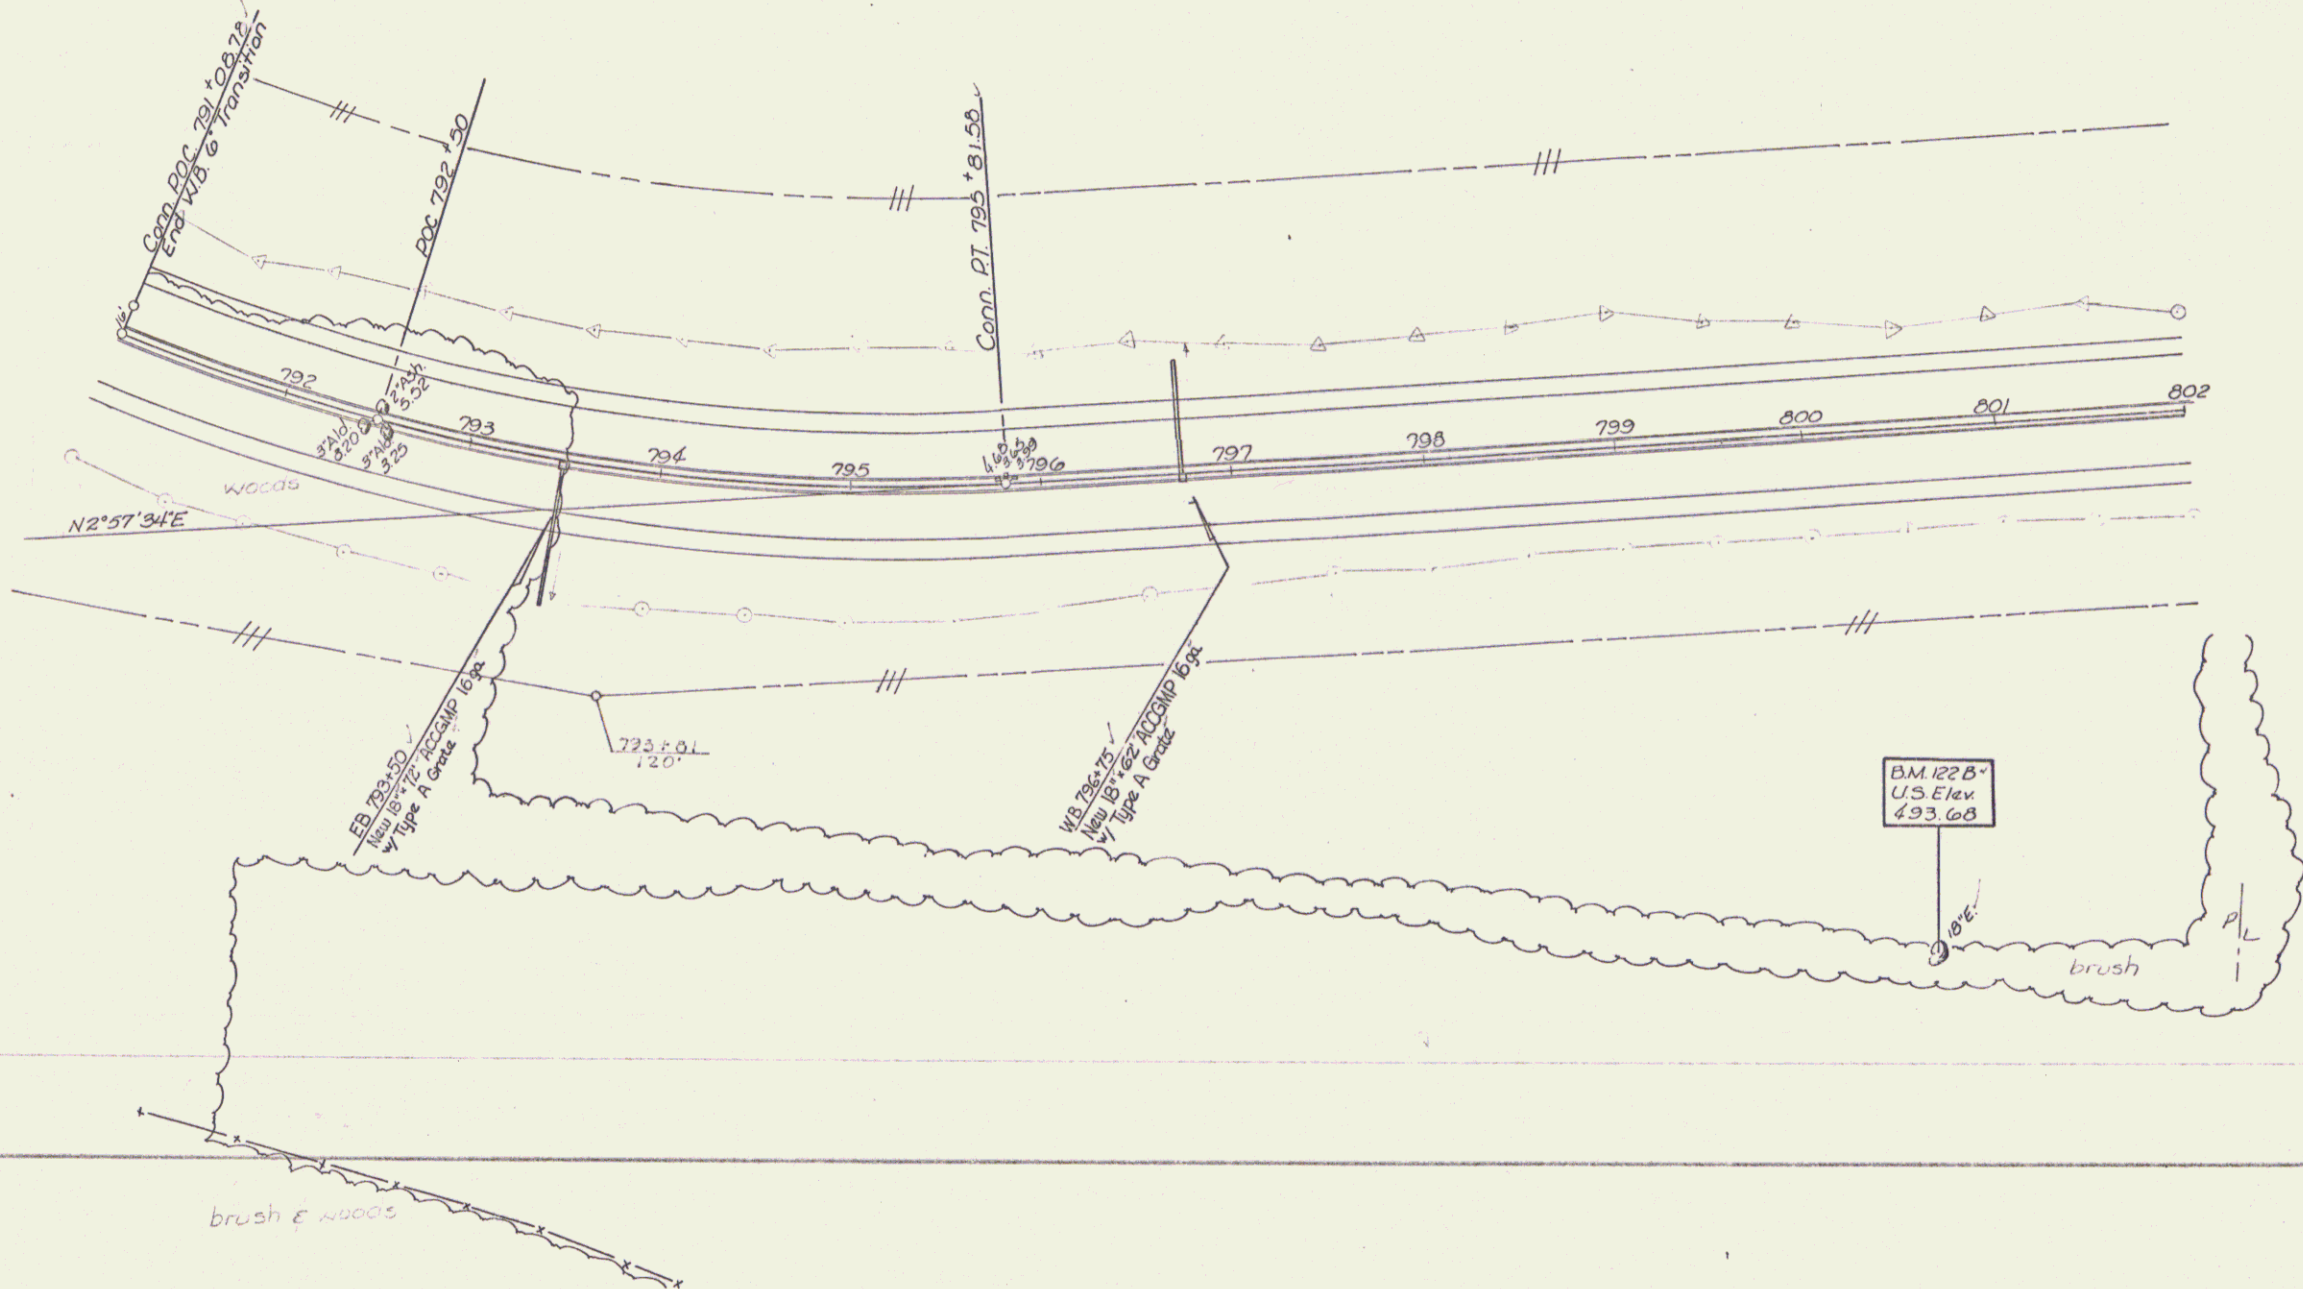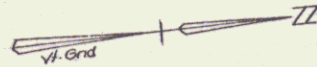

Stage 2 Construction

SURVEYED BY Barres DATE 5/65
DRAWN BY Evans DATE 5/65
TRACED BY L. Clark DATE 6/65
PROJ. AP NO. 020-1 (11)
SHEET 18 OF 359

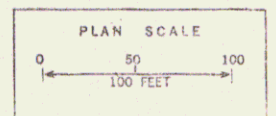

Sheet 107 of 170 Sheets 14