

THREE CABLE GUARD RAIL w/ STEEL POSTS
 397+70-403+00
 397+70-403+00
 Removal & Disposal of Present Guard Rail
 398+00-398+30 RT
 399+00-403+00 RT
 PLANK GUARD RAIL w/PRESERVATIVE TREATMENT
 399+27

Construct Approach
 398+00 RT
 #1A NICHOLAS & ELEANOR LEMTUGOV
 (A 0.02) STA 396+00-398+68
 W.D.O.E. 12/16/58
 RECORDED: MANCHESTER - BK 52 - PG 286 - 12/19/58


PRESENT ROW PURCHASED FROM H.P. WAY BY
 W.D.O.E. 6-23-41 BK 41 PG 206 MANCHESTER L.R.
 APR SUR. STA 391+76-399+71 E

PRESENT ROW ESTABLISHED BY F.A.P. 92 C (I) 1942
 SUR. STA 391+00-409+50 LT & RT.

Δ 1° 49' L.V.
 D 0° 15'
 R 22918.3'
 T 363.3'
 L 726.6'
 E 29'
 Do not Bank

#2A CARL J. & ANNA E. LASSOR
 (A 100) STA 398+58-419+92
 COND. 11/12/58
 RECORDED: MANCHESTER - BK 52 - PG 271/278 - 11/14/58

0.07
 14-57
 PLANK
 14-58

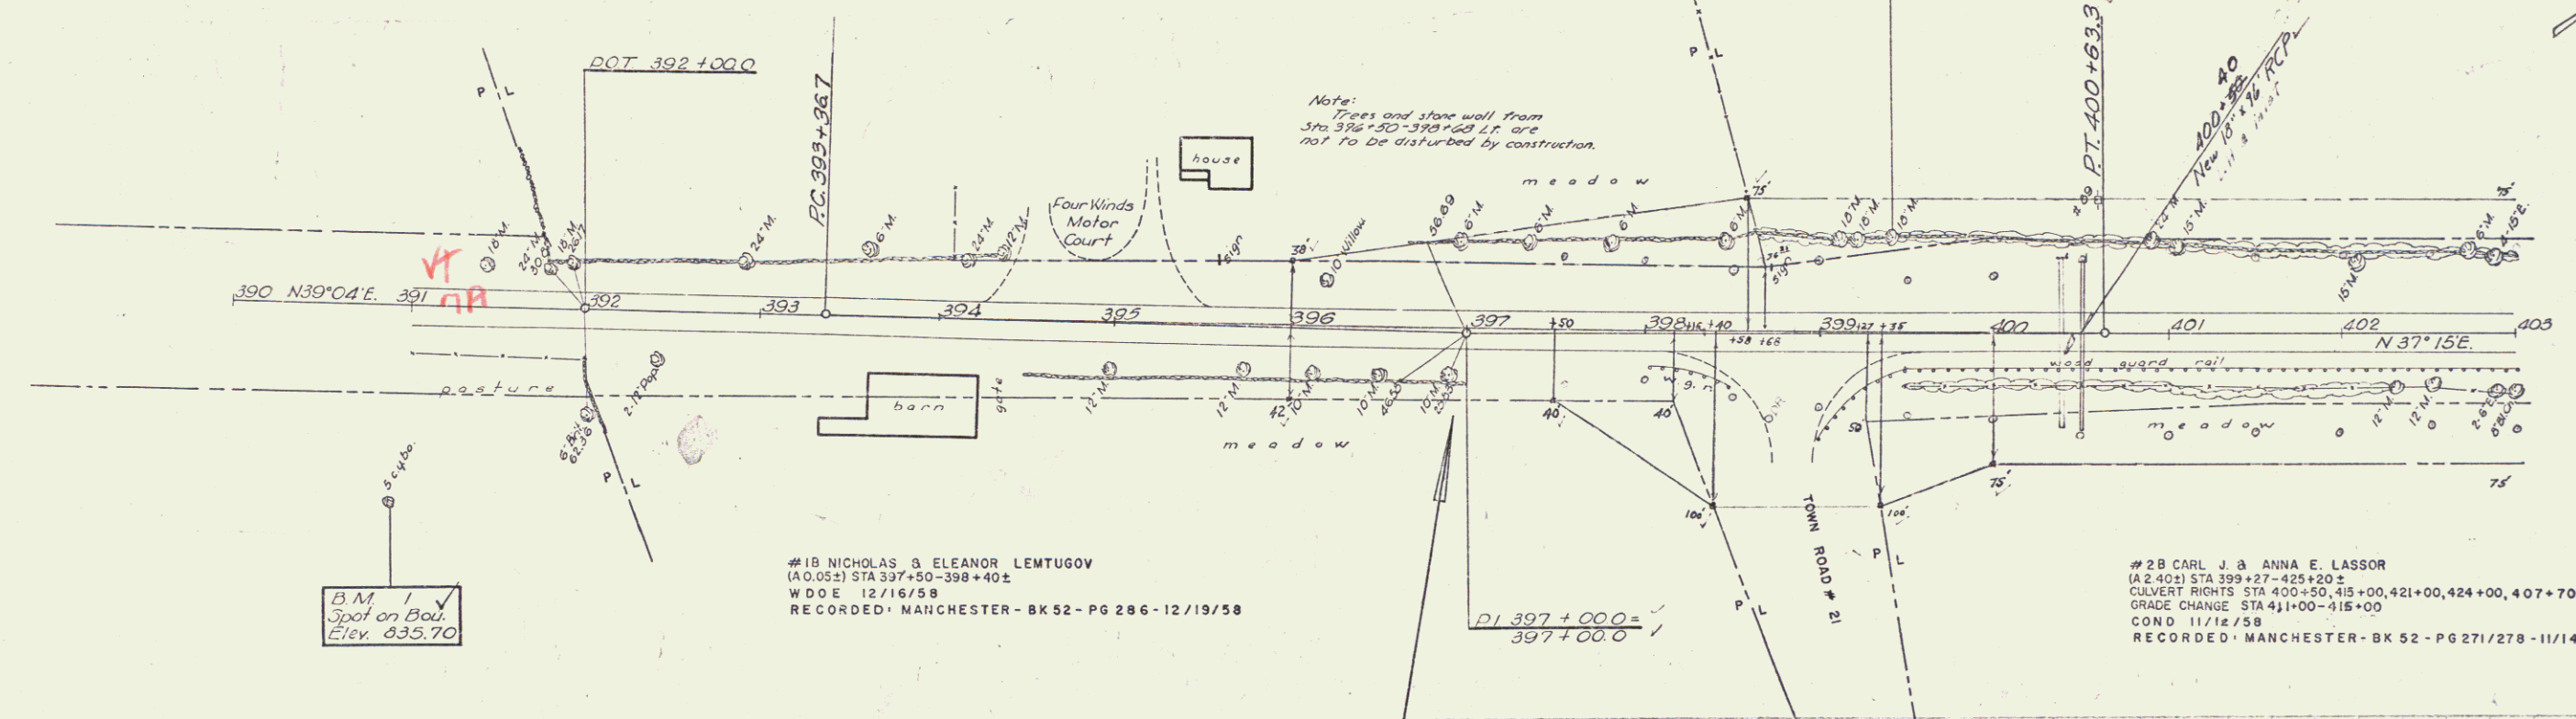

B.M. #1
 Spot on Boulder
 Elev. 835.70


#1B NICHOLAS & ELEANOR LEMTUGOV
 (A 0.02) STA 397+50-398+40
 W.D.O.E. 12/16/58
 RECORDED: MANCHESTER - BK 52 - PG 286 - 12/19/58

PI 397+00.0 =
 397+00.0

#2B CARL J. & ANNA E. LASSOR
 (A 2.00) STA 399+27-425+20
 CULVERT RIGHTS STA 400+50, 415+00, 421+00, 424+00, 407+70
 GRADE CHANGE STA 411+00-415+00
 COND. 11/12/58
 RECORDED: MANCHESTER - BK 52 - PG 271/278 - 11/14/58

STA 397+00
 Begin Appr. Construction

0.07
 14-57
 PLANK
 14-58

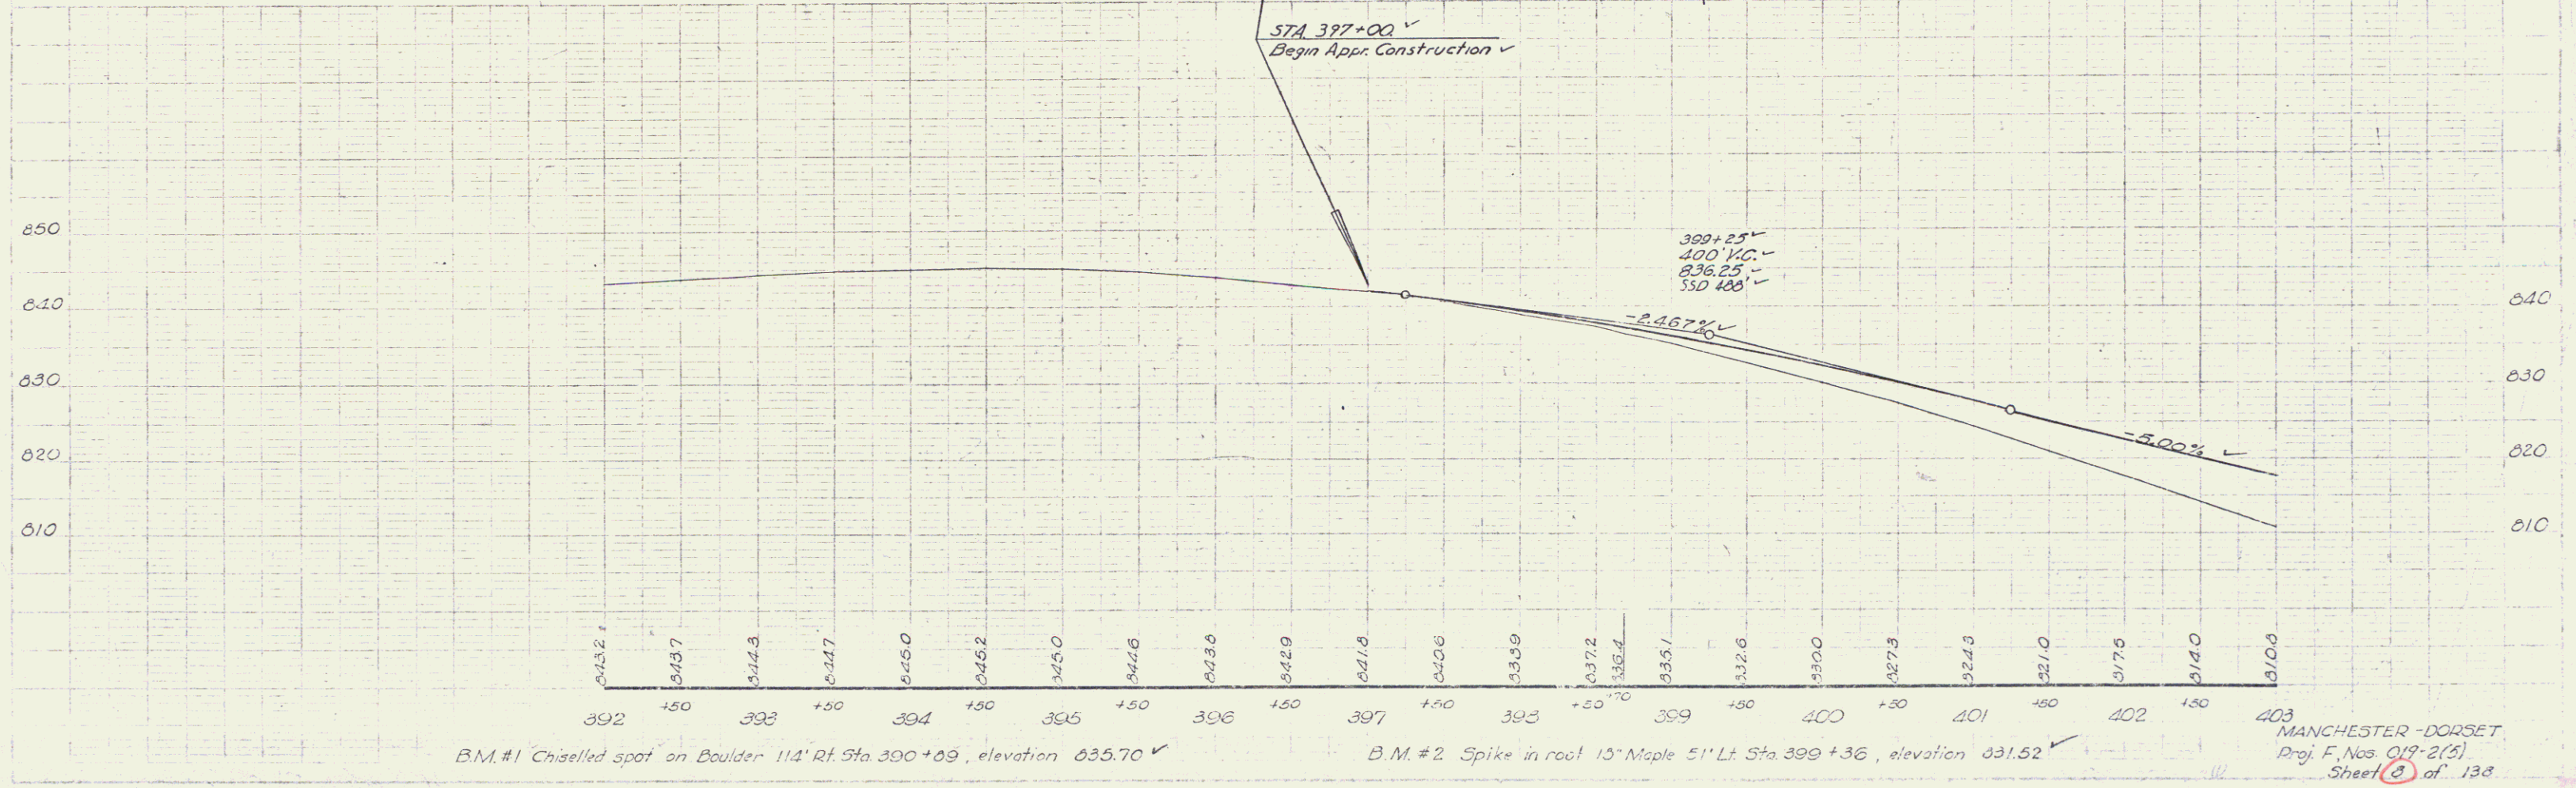

B.M. #1 Chiselled spot on Boulder 114' Rt. Sta. 390+09, elevation 835.70

B.M. #2 Spike in root 15' Maple 51' Lt. Sta. 399+36, elevation 831.52

MANCHESTER - DORSET
 Proj. F. Nos. 019-2(3)
 Sheet 2 of 138

Removal & Dispose of Present Guard Rail
 LT 403+00 - 403+15
 RT 403+00 - 403+30
 403+30 - 403+83

PRESENT R.O.W. PURCHASED FROM C. J. LASSOR BY
 W.D.E. 8/25/41 - BK 41 - PG 207 MANCHESTER
 APP. SUR STA 398+71 - 409+80

B.M. # 3
 Spot on headwall
 Elev. 790.56



Three Cable Guard Rail with Steel Posts Item 543
 403+00 - 403+83 Rt.
 403+00 - 403+22 Lt.
 403+22 - 403+42 Lt.
 403+42 - 403+83 Rt.
 407+80 - 409+04 Lt.
 409+04 - 409+83 Lt.

Construct Drives
 Lt RT
 403+40 - 403+40 V
 404+00 - 403+42
 405+00 - 403+70
 405+75
 411+25



CARL J. & ANNA E. LASSOR

PLANK GUARD RAIL W/ PRESATIVE TREATMENT
 413+30 - 413+70 LT.

TENANT & UNDER CONTRACT TO BUY: HENRY A. & EVELYN M. SENEAL

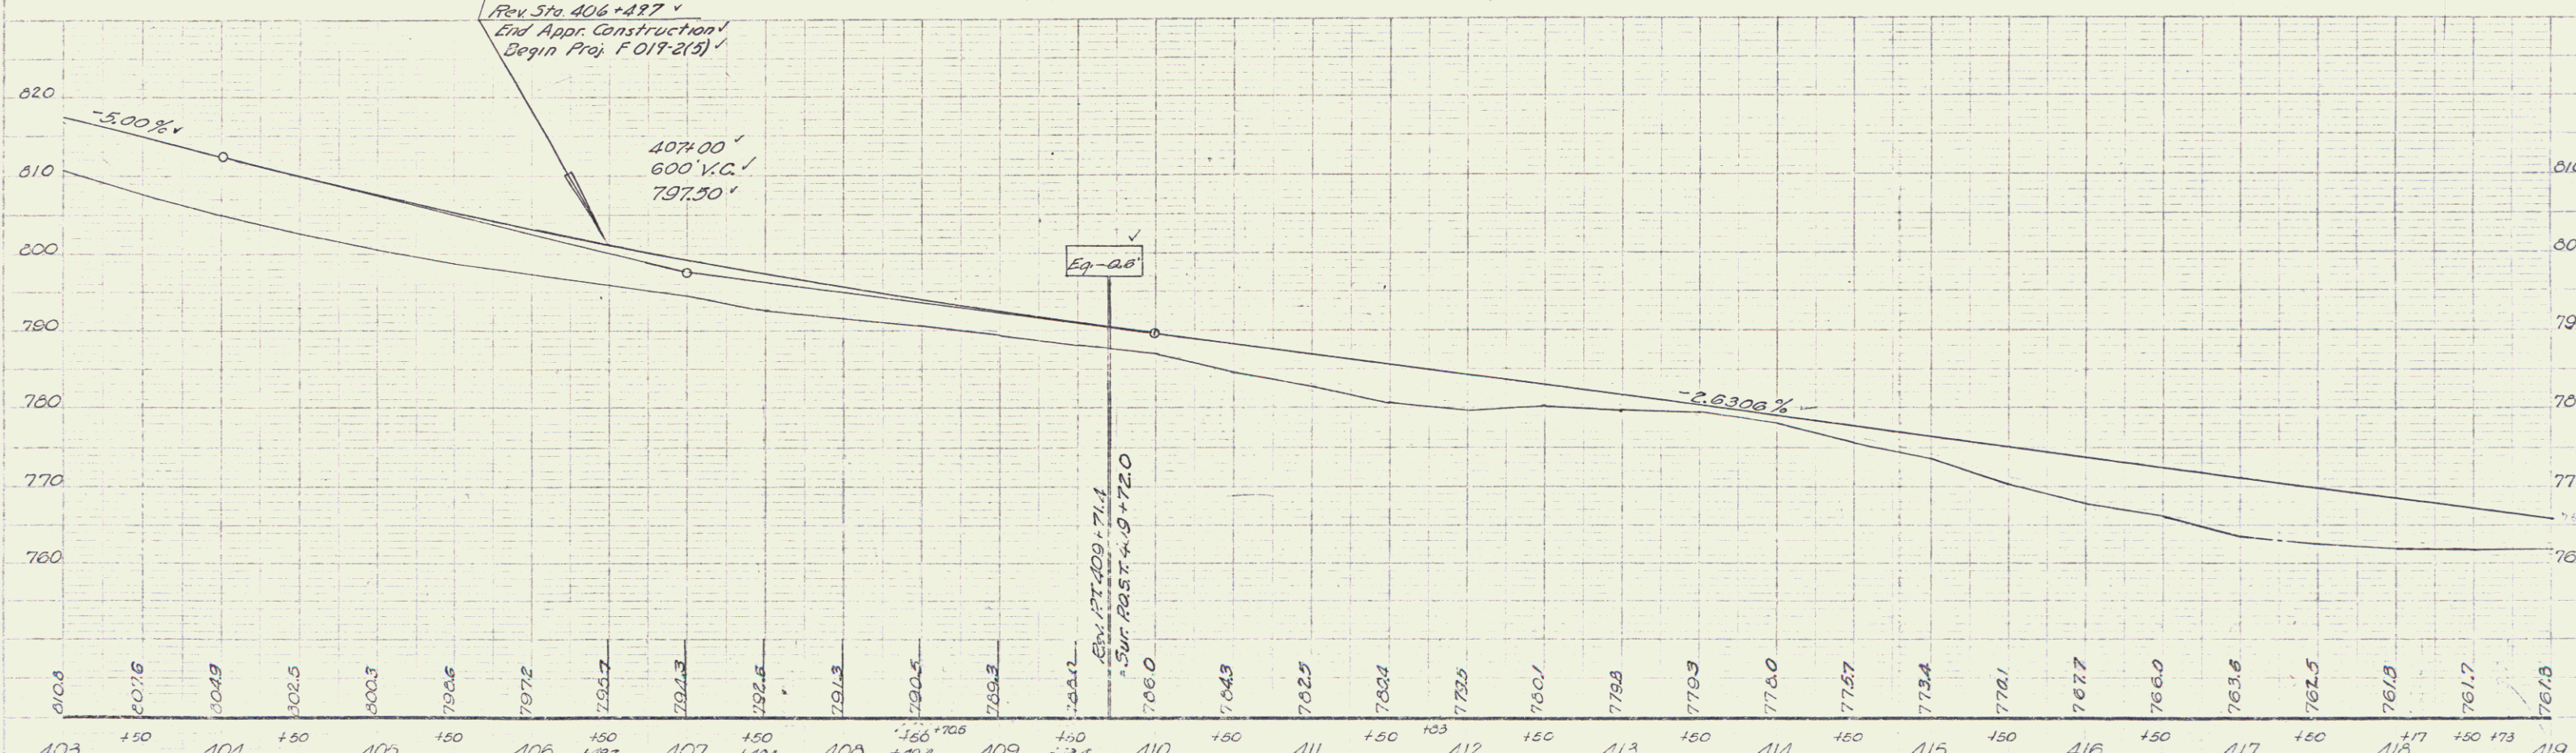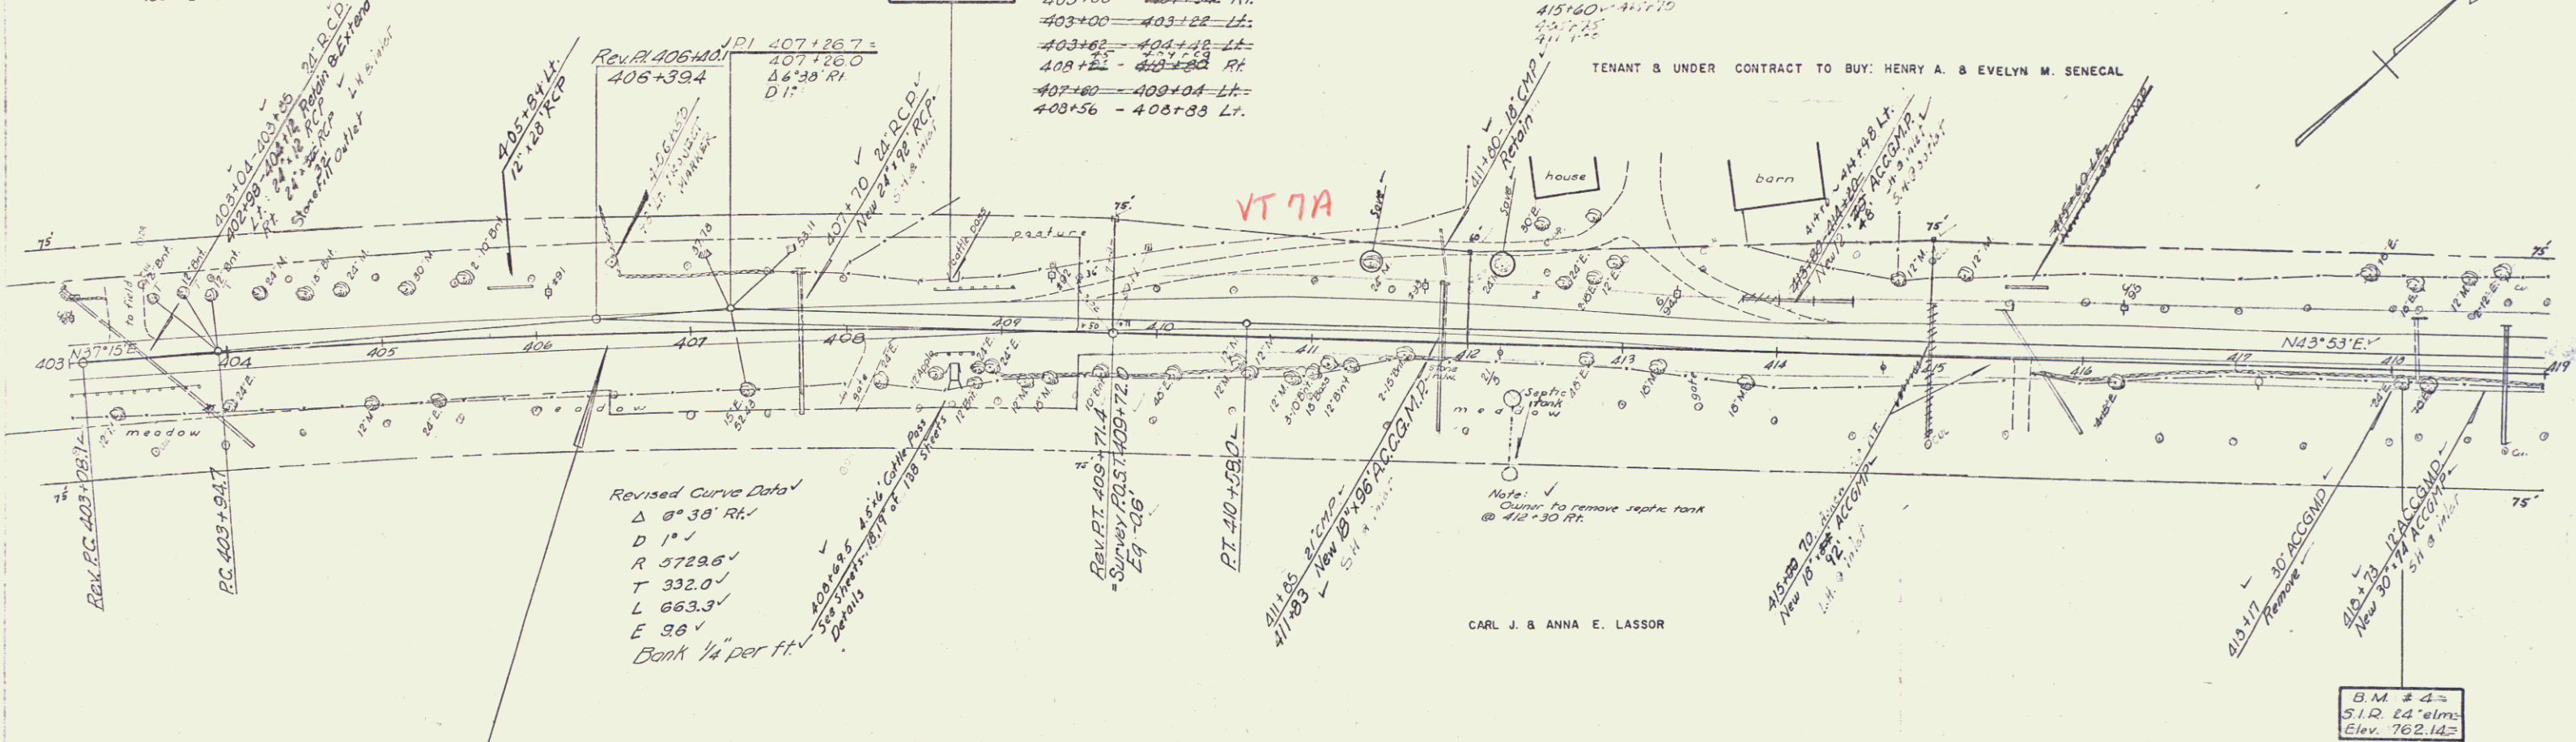

B.M. # 3 Chiselled spot on west headwall cattle pass 24' left sta. 406+85, elevation 790.56
 B.M. # 4 Spike in root 24' elm, 18.5 ft. Rt. Sta. 416+00, elevation 762.14
 MANCHESTER - DORSET
 Proj. E. Nos. 019-2(1)
 Sheet 9 of 132

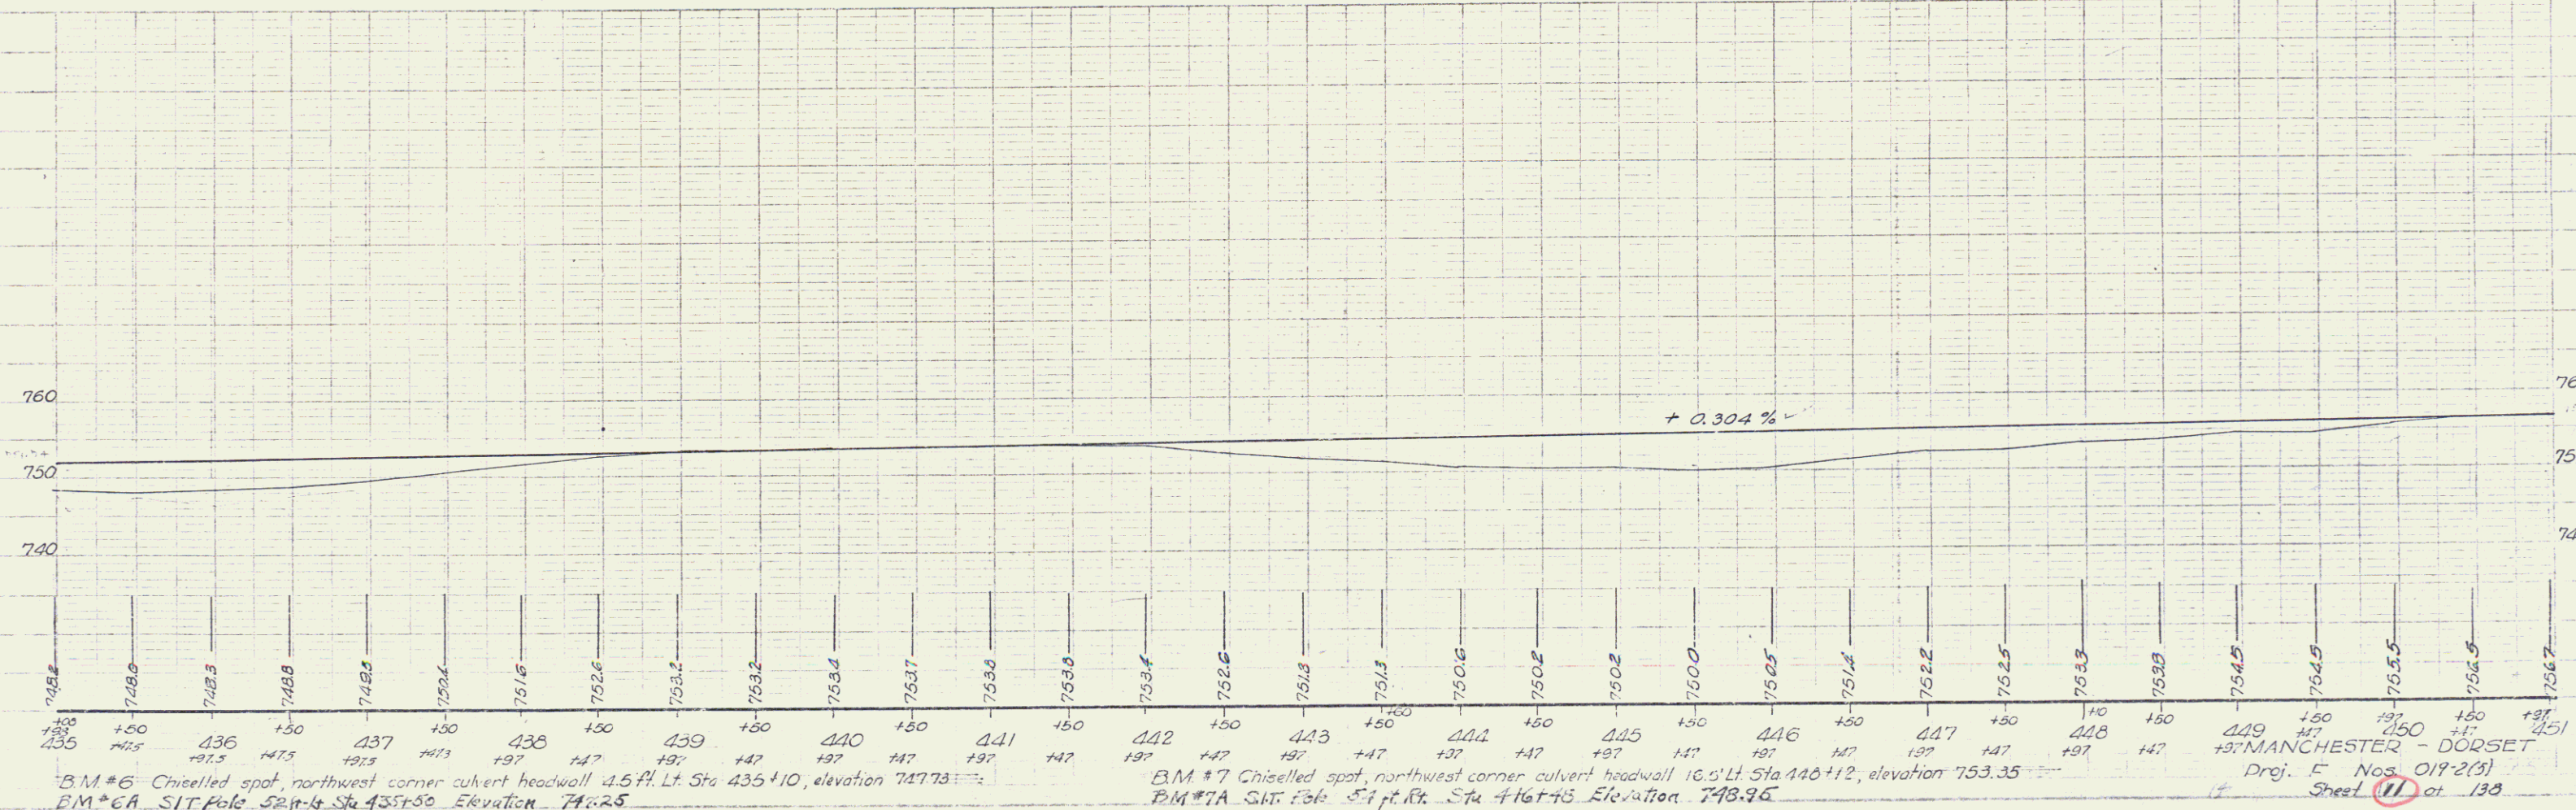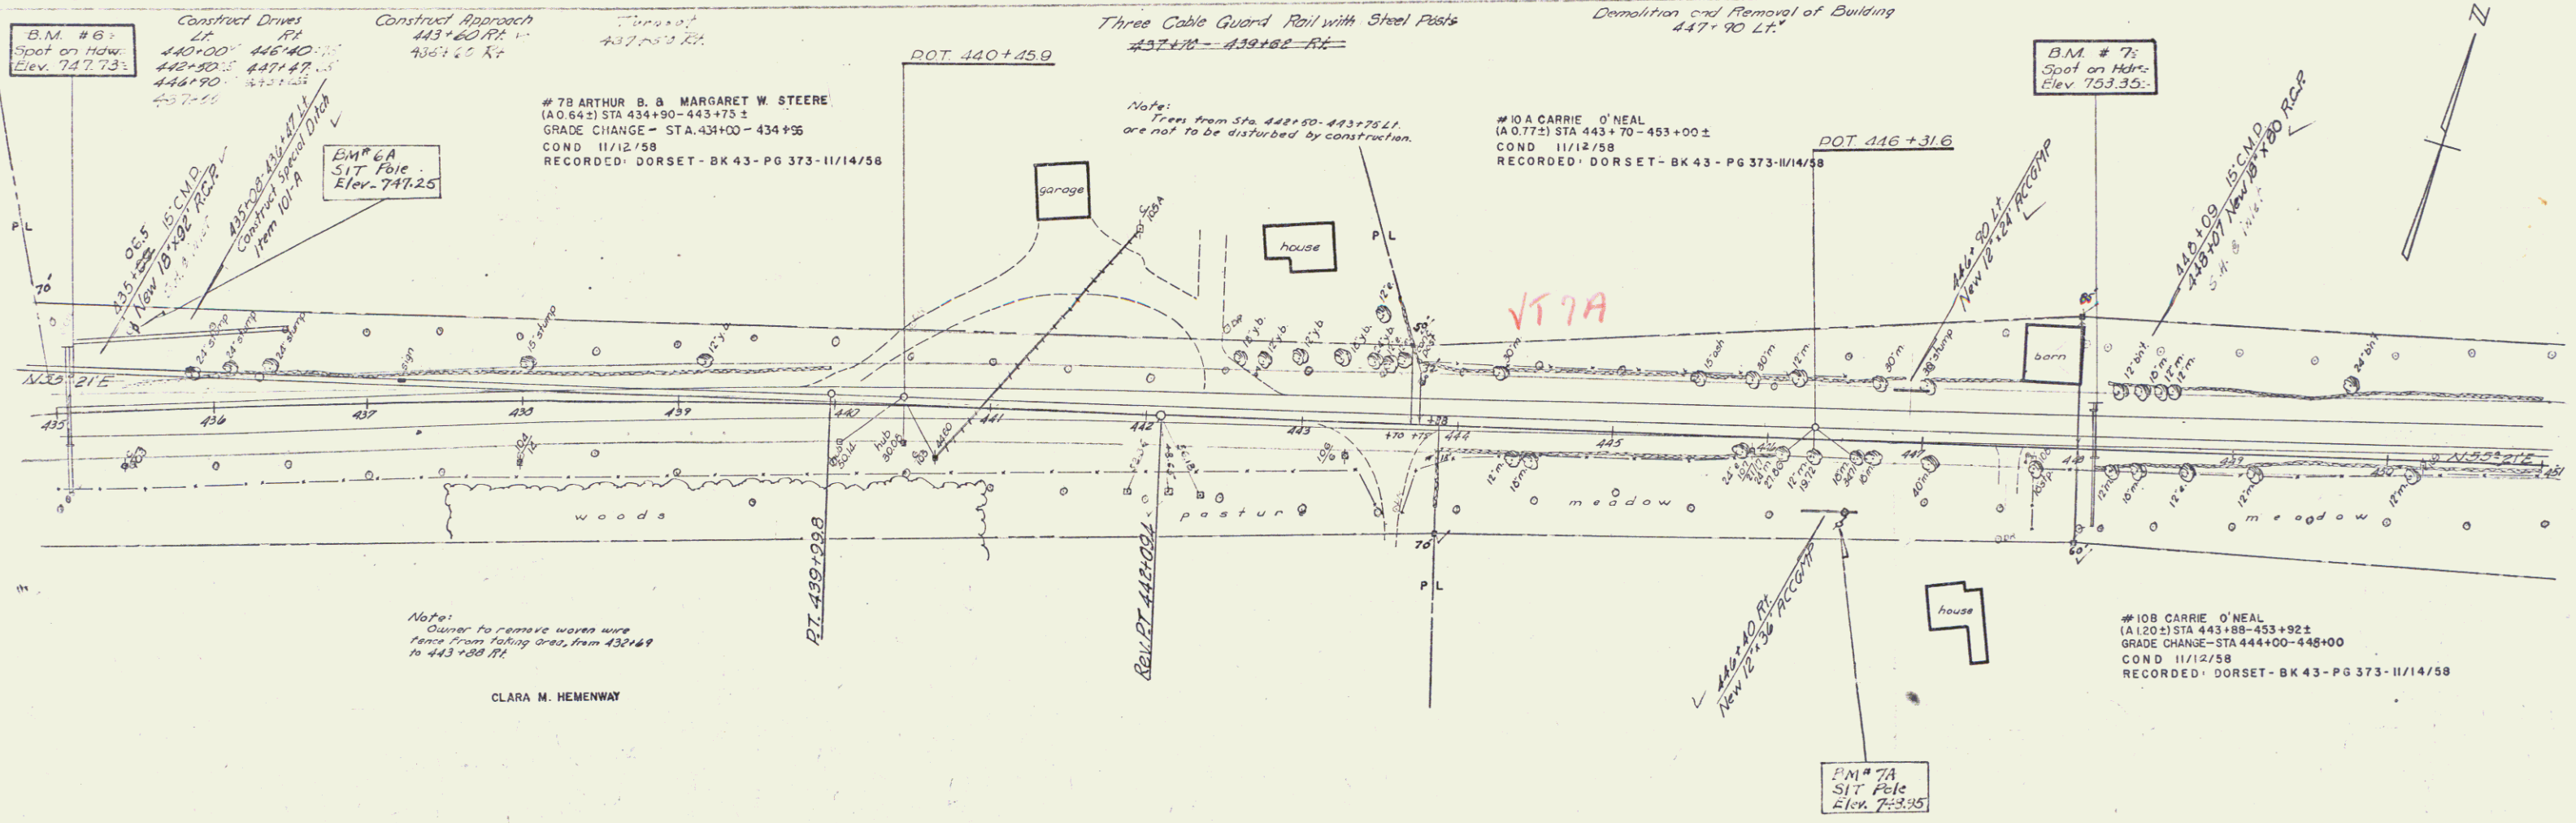

B.M. #6 Chiselled spot, northwest corner culvert headwall 4.5 ft. Lt. Sta 435+10, elevation 747.73
 B.M. #7 Chiselled spot, northwest corner culvert headwall 16.5 ft. Lt. Sta 446+12, elevation 753.35
 B.M. #7A Chiselled spot, northwest corner culvert headwall 16.5 ft. Lt. Sta 446+12, elevation 748.96

0.57
 10.57
 12.57
 14.57
Remove & Disposal of Present Guard Rail
 451+45 - 457+55 LT
 458+20 - 459+00 LT
 463+45 - 464+00 LT-RT
 463+30 - 464+90 LT

Construct Drives
 LT RT
 454+50 - 463+00

B.M. # 8
 Spot on Hdr.
 Elev. 753.48

Three Cable Guard Rail with Steel Posts Item 543
 455+33 - 465+25 RT
 458+33 - 464+25 LT
 465+27 - 467+21 RT & LT



Plank Guard Rail for Barricade
 457+50 LT Item 544

#11A FRANK V. SR. CLARA W. READ
 (A.C. 882) STA 457+71 - 471+67.2
 COND. 11/12/58
 RECORDED: DORSET - BK 43 - PG 373 - 11/14/58

Revised Curve Data
 Δ 20° 33' LT
 D 2° 30'
 R 2282.0
 T 523.1
 L 1142.0
 E 73.0
 Bank 1/4" per ft.

B.M. # 9
 Spot on Br. rail
 Elev. 737.79

POT 467+00

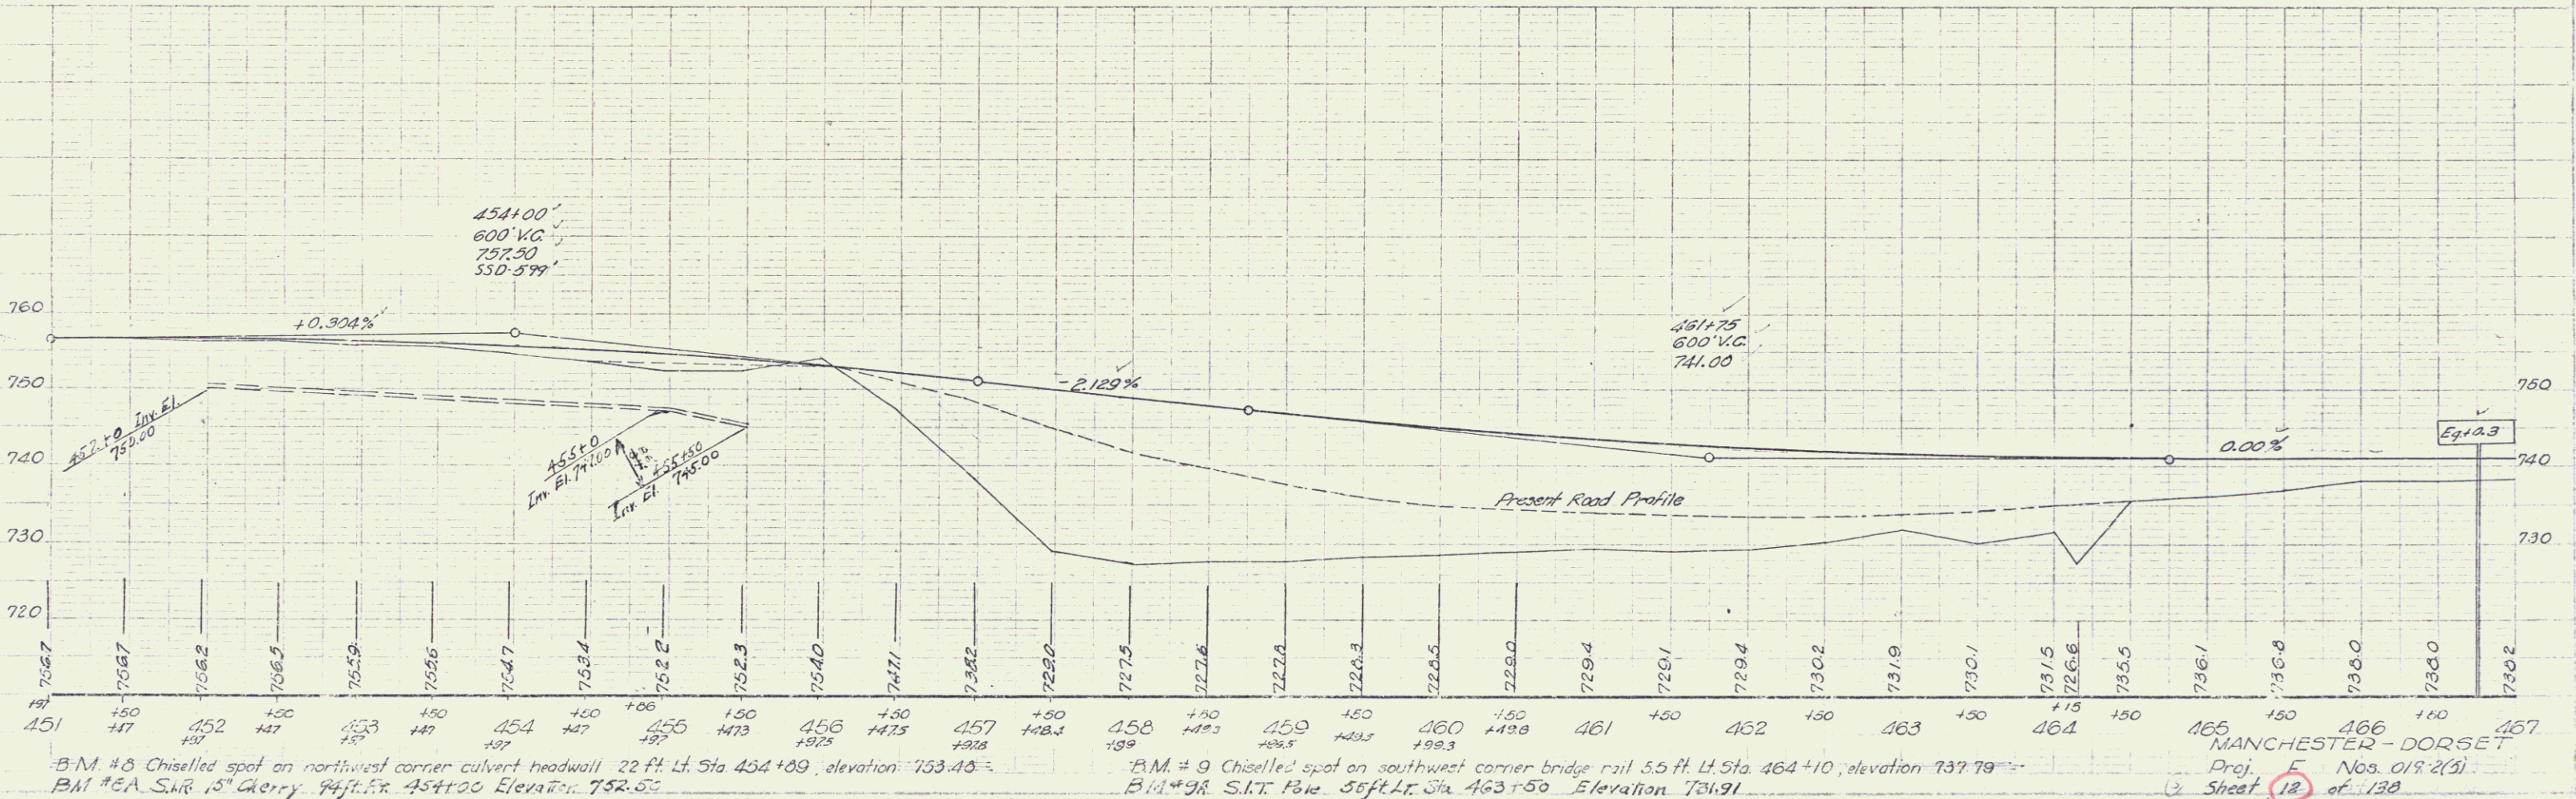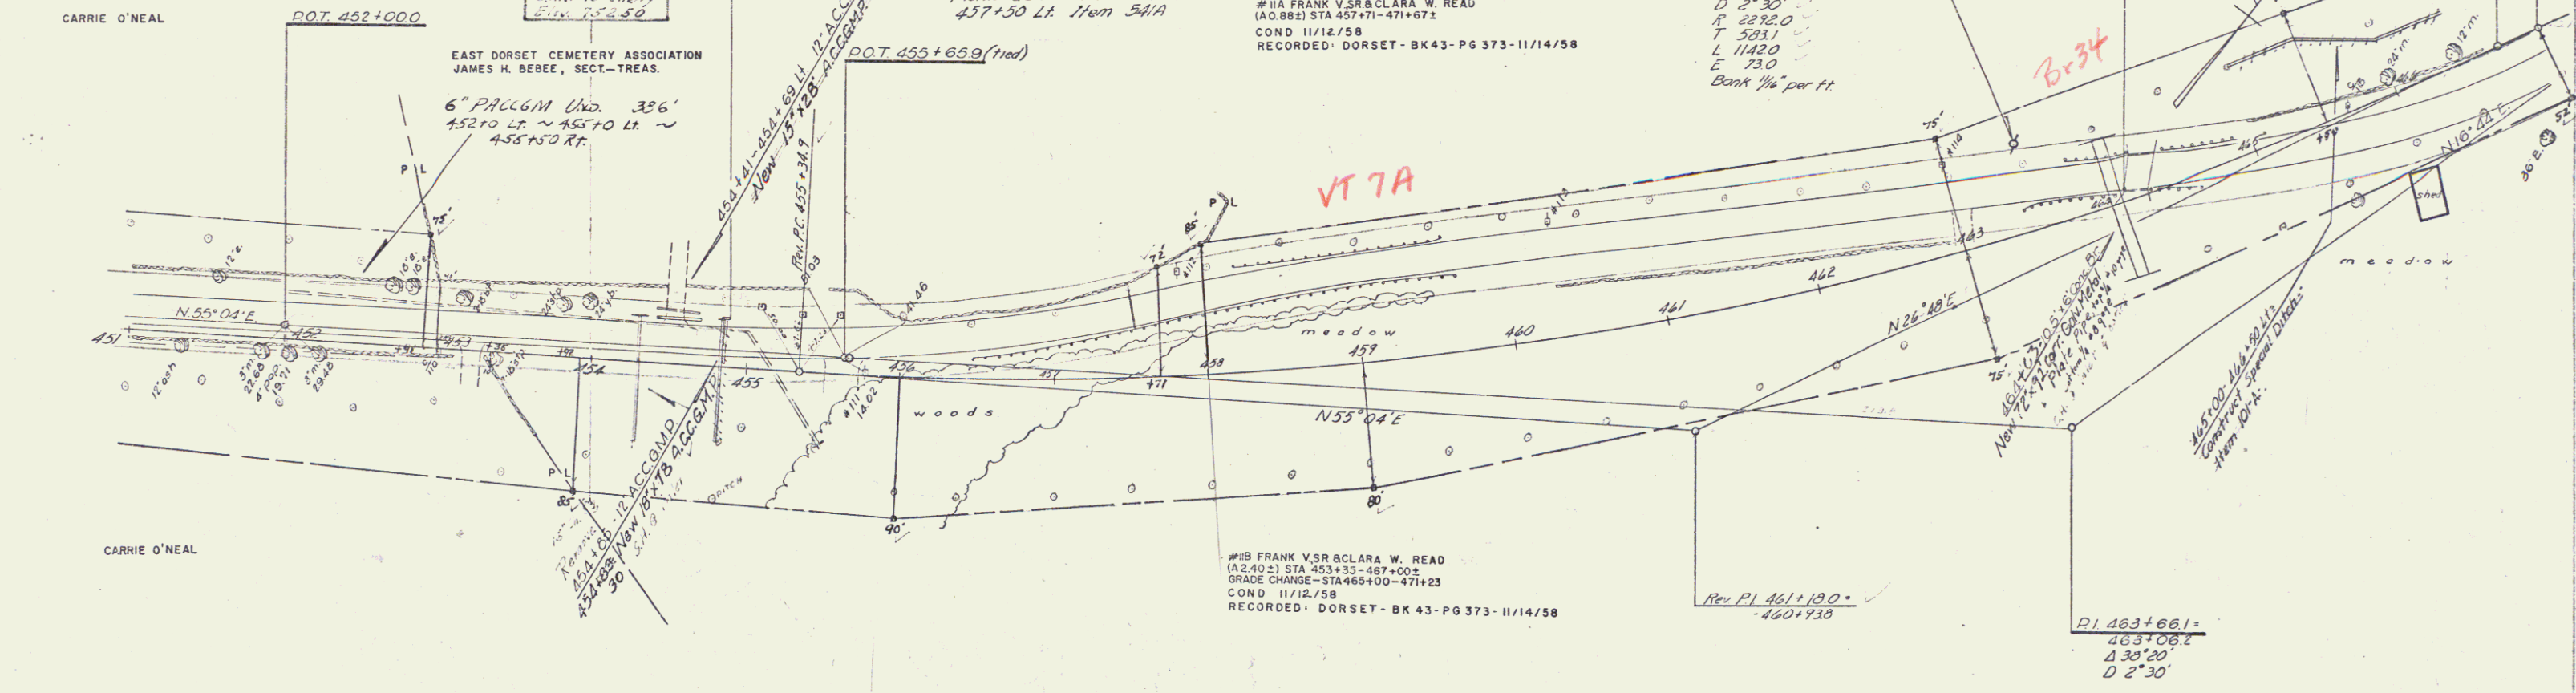

B.M. # 8 Chiselled spot on northwest corner culvert headwall 22 ft. Lt. Sta 454+09, elevation 753.48.
 B.M. # 8A S.R. 15 Cherry 84 ft. Rt. 454+00 Elevation 752.55

B.M. # 9 Chiselled spot on southwest corner bridge rail 5.5 ft. Lt. Sta 464+10, elevation 737.79
 B.M. # 9R S.R. 15 Cherry 36 ft. Lt. Sta 463+50 Elevation 731.91

MANCHESTER - DORSET
 Proj. E Nos. 018-2(3)
 Sheet 12 of 138

0-57
 10-37
 12-57
 1-58
 2-58
 3-58
 4-58
 5-58
 6-58
 7-58
 8-58
 9-58
 10-58
 11-58
 12-58
 1-59
 2-59
 3-59
 4-59
 5-59
 6-59
 7-59
 8-59
 9-59
 10-59
 11-59
 12-59
 1-60
 2-60
 3-60
 4-60
 5-60
 6-60
 7-60
 8-60
 9-60
 10-60
 11-60
 12-60
 1-61
 2-61
 3-61
 4-61
 5-61
 6-61
 7-61
 8-61
 9-61
 10-61
 11-61
 12-61
 1-62
 2-62
 3-62
 4-62
 5-62
 6-62
 7-62
 8-62
 9-62
 10-62
 11-62
 12-62
 1-63
 2-63
 3-63
 4-63
 5-63
 6-63
 7-63
 8-63
 9-63
 10-63
 11-63
 12-63
 1-64
 2-64
 3-64
 4-64
 5-64
 6-64
 7-64
 8-64
 9-64
 10-64
 11-64
 12-64
 1-65
 2-65
 3-65
 4-65
 5-65
 6-65
 7-65
 8-65
 9-65
 10-65
 11-65
 12-65
 1-66
 2-66
 3-66
 4-66
 5-66
 6-66
 7-66
 8-66
 9-66
 10-66
 11-66
 12-66
 1-67
 2-67
 3-67
 4-67
 5-67
 6-67
 7-67
 8-67
 9-67
 10-67
 11-67
 12-67
 1-68
 2-68
 3-68
 4-68
 5-68
 6-68
 7-68
 8-68
 9-68
 10-68
 11-68
 12-68
 1-69
 2-69
 3-69
 4-69
 5-69
 6-69
 7-69
 8-69
 9-69
 10-69
 11-69
 12-69
 1-70
 2-70
 3-70
 4-70
 5-70
 6-70
 7-70
 8-70
 9-70
 10-70
 11-70
 12-70
 1-71
 2-71
 3-71
 4-71
 5-71
 6-71
 7-71
 8-71
 9-71
 10-71
 11-71
 12-71
 1-72
 2-72
 3-72
 4-72
 5-72
 6-72
 7-72
 8-72
 9-72
 10-72
 11-72
 12-72
 1-73
 2-73
 3-73
 4-73
 5-73
 6-73
 7-73
 8-73
 9-73
 10-73
 11-73
 12-73
 1-74
 2-74
 3-74
 4-74
 5-74
 6-74
 7-74
 8-74
 9-74
 10-74
 11-74
 12-74
 1-75
 2-75
 3-75
 4-75
 5-75
 6-75
 7-75
 8-75
 9-75
 10-75
 11-75
 12-75
 1-76
 2-76
 3-76
 4-76
 5-76
 6-76
 7-76
 8-76
 9-76
 10-76
 11-76
 12-76
 1-77
 2-77
 3-77
 4-77
 5-77
 6-77
 7-77
 8-77
 9-77
 10-77
 11-77
 12-77
 1-78
 2-78
 3-78
 4-78
 5-78
 6-78
 7-78
 8-78
 9-78
 10-78
 11-78
 12-78
 1-79
 2-79
 3-79
 4-79
 5-79
 6-79
 7-79
 8-79
 9-79
 10-79
 11-79
 12-79
 1-80
 2-80
 3-80
 4-80
 5-80
 6-80
 7-80
 8-80
 9-80
 10-80
 11-80
 12-80
 1-81
 2-81
 3-81
 4-81
 5-81
 6-81
 7-81
 8-81
 9-81
 10-81
 11-81
 12-81
 1-82
 2-82
 3-82
 4-82
 5-82
 6-82
 7-82
 8-82
 9-82
 10-82
 11-82
 12-82
 1-83
 2-83
 3-83
 4-83
 5-83
 6-83
 7-83
 8-83
 9-83
 10-83
 11-83
 12-83
 1-84
 2-84
 3-84
 4-84
 5-84
 6-84
 7-84
 8-84
 9-84
 10-84
 11-84
 12-84
 1-85
 2-85
 3-85
 4-85
 5-85
 6-85
 7-85
 8-85
 9-85
 10-85
 11-85
 12-85
 1-86
 2-86
 3-86
 4-86
 5-86
 6-86
 7-86
 8-86
 9-86
 10-86
 11-86
 12-86
 1-87
 2-87
 3-87
 4-87
 5-87
 6-87
 7-87
 8-87
 9-87
 10-87
 11-87
 12-87
 1-88
 2-88
 3-88
 4-88
 5-88
 6-88
 7-88
 8-88
 9-88
 10-88
 11-88
 12-88
 1-89
 2-89
 3-89
 4-89
 5-89
 6-89
 7-89
 8-89
 9-89
 10-89
 11-89
 12-89
 1-90
 2-90
 3-90
 4-90
 5-90
 6-90
 7-90
 8-90
 9-90
 10-90
 11-90
 12-90
 1-91
 2-91
 3-91
 4-91
 5-91
 6-91
 7-91
 8-91
 9-91
 10-91
 11-91
 12-91
 1-92
 2-92
 3-92
 4-92
 5-92
 6-92
 7-92
 8-92
 9-92
 10-92
 11-92
 12-92
 1-93
 2-93
 3-93
 4-93
 5-93
 6-93
 7-93
 8-93
 9-93
 10-93
 11-93
 12-93
 1-94
 2-94
 3-94
 4-94
 5-94
 6-94
 7-94
 8-94
 9-94
 10-94
 11-94
 12-94
 1-95
 2-95
 3-95
 4-95
 5-95
 6-95
 7-95
 8-95
 9-95
 10-95
 11-95
 12-95
 1-96
 2-96
 3-96
 4-96
 5-96
 6-96
 7-96
 8-96
 9-96
 10-96
 11-96
 12-96
 1-97
 2-97
 3-97
 4-97
 5-97
 6-97
 7-97
 8-97
 9-97
 10-97
 11-97
 12-97
 1-98
 2-98
 3-98
 4-98
 5-98
 6-98
 7-98
 8-98
 9-98
 10-98
 11-98
 12-98
 1-99
 2-99
 3-99
 4-99
 5-99
 6-99
 7-99
 8-99
 9-99
 10-99
 11-99
 12-99
 1-100
 2-100
 3-100
 4-100
 5-100
 6-100
 7-100
 8-100
 9-100
 10-100
 11-100
 12-100

Excavation + Removal of Road Surface on Discontinued Roadways Item 118 472+00 ~ 481+00 Lt.

Construct Approach 482+13.5 Lt.

Construct Drives Lt Rt 482+50 ~ 487+50 488+22 ~ 491+22

Plank Guard Rail for Barricade 472+26 Lt. Item 541A 481+60

Three Cable Guard Rail with Steel Posts Item 543 482+10 ~ 470+70 Rt

Demolition and Removal of Building 467+25 Lt.

FRANK V. SR. OCLARA W. ROAD

Sta. 471+30.0 Stop Roadway - Begin Bridge

Sta. 471+94.0 End Bridge - Resume Roadway


471+06 ~ 471+30 Lt.

470+83 ~ 471+17 Rt.

471+94 ~ 472+18

LOUIS R. BUFFUM

BEGIN RELINQUISHMENT SEE NOTE SHEET 15 SUBV. STA 476+50 LT.

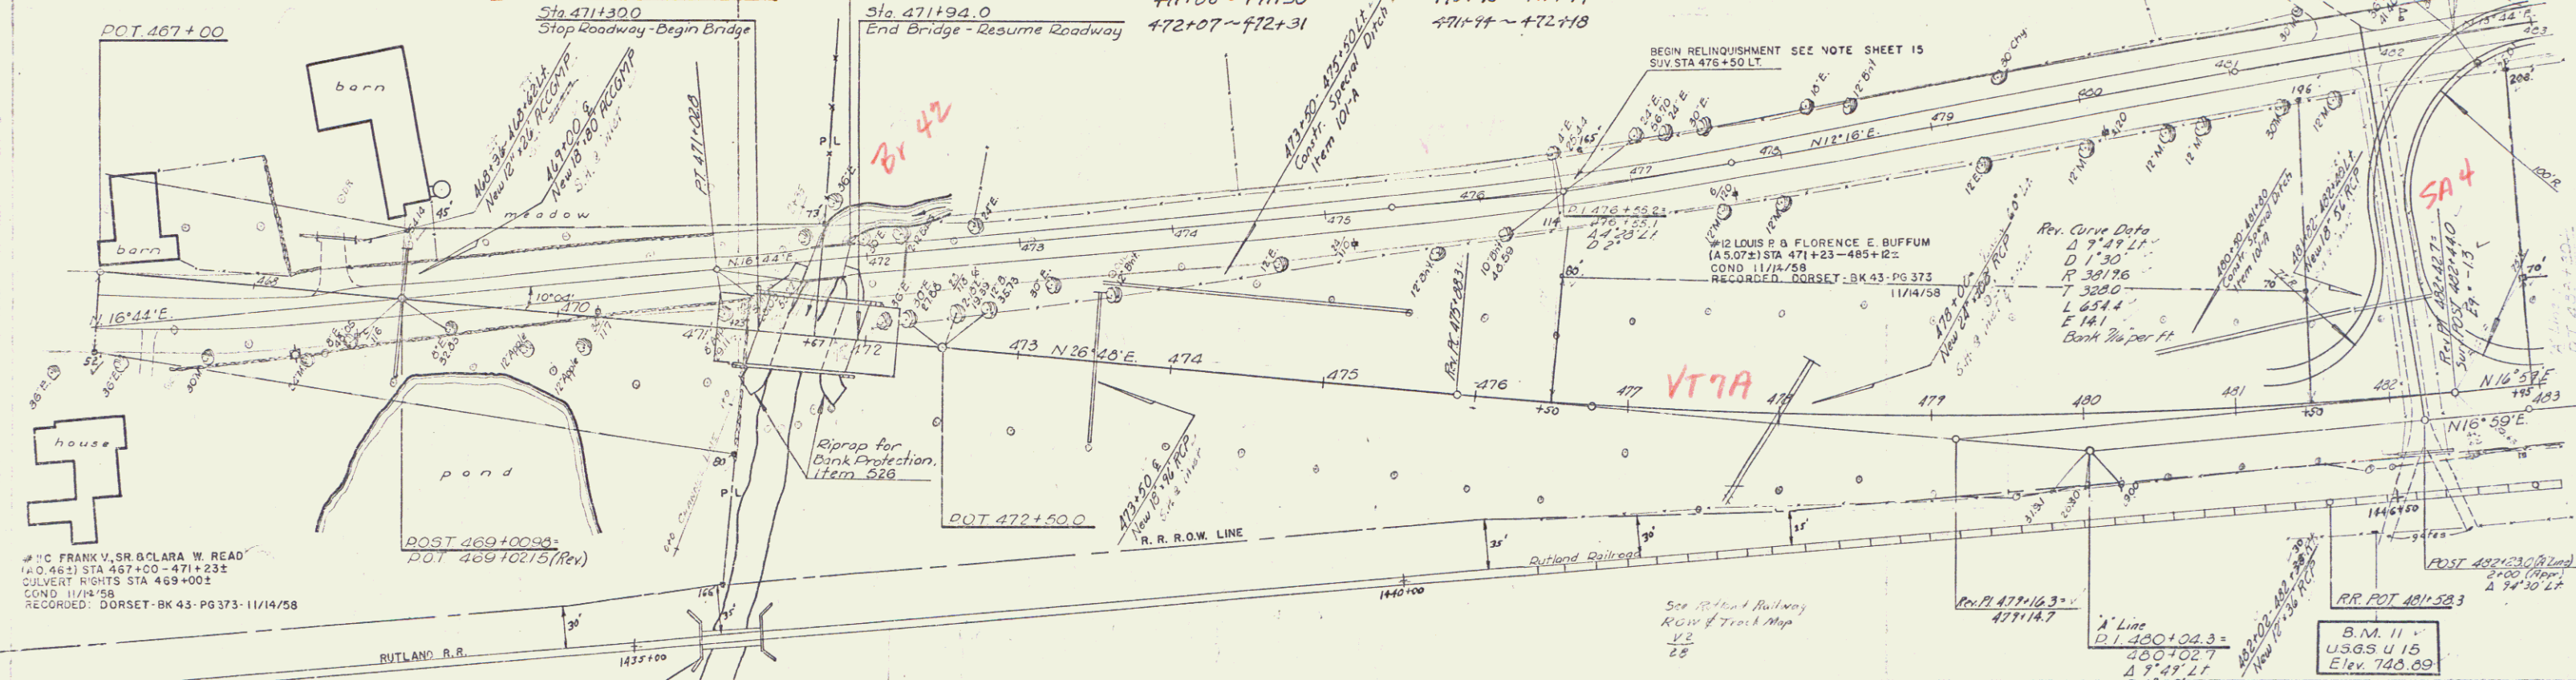


FRANK V. SR. OCLARA W. ROAD (A.D. 461) STA 467+00 ~ 471+232 CULVERT RIGHTS STA 469+002 COND. 11/18/58 RECORDED: DORSET - BK 43 - PG 373 - 11/14/58

POST 469+003 POT 469+0215 (Rev)

POT 472+50.0

Rev. Curve Data
D 9' 49" Lt.
D 1' 30"
R 391'76"
T 388.0
L 454.4
E 14.1
Bank 24 per Ft.


B.M. 11 U.S.G.S. disc 74 ft Rt. 'A' Line Sta 481+09 Elev 742.33

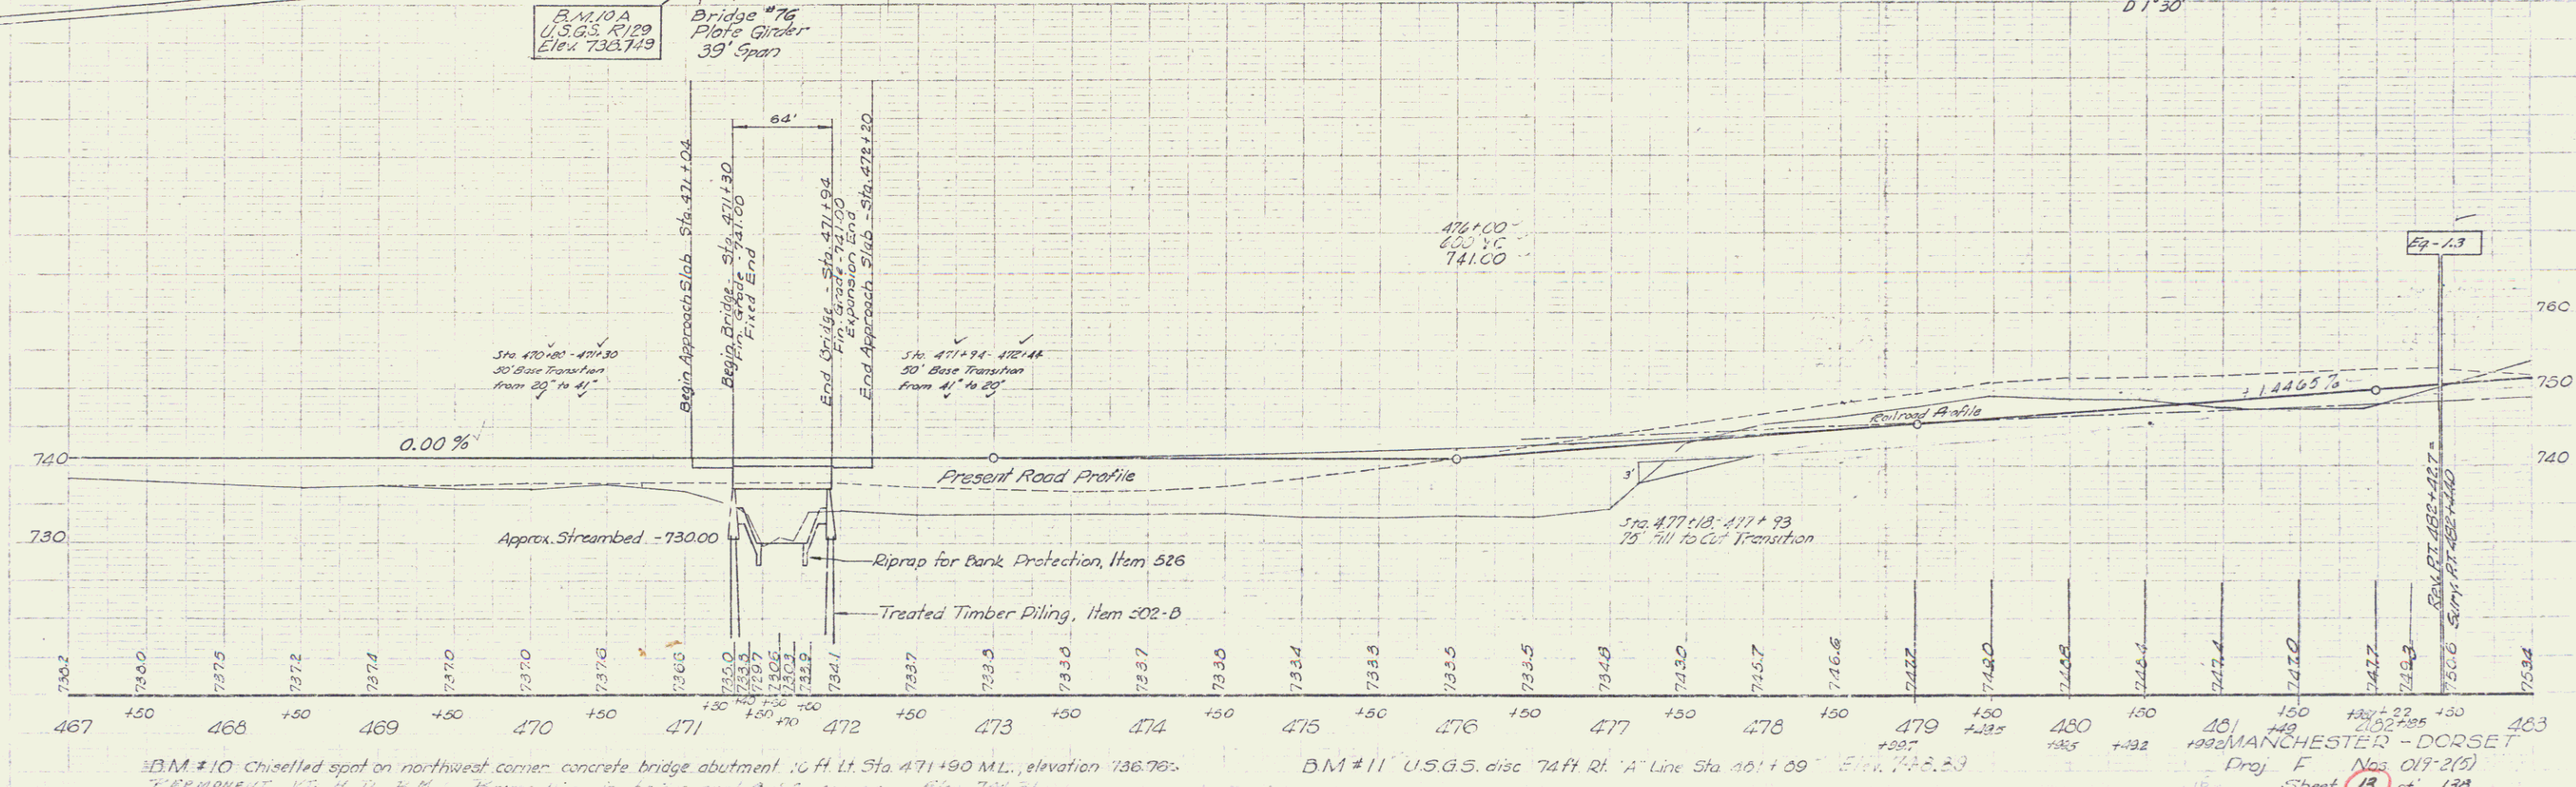

B.M. #10 Chiselled spot on northwest corner concrete bridge abutment. 10 ft Lt. Sta 471+90 M.L. elevation 736.765

B.M. #11 U.S.G.S. disc 74 ft Rt. 'A' Line Sta 481+09 Elev 742.33

MANCHESTER - DORSET Proj. F No. 019-2(5) Sheet 13 of 130

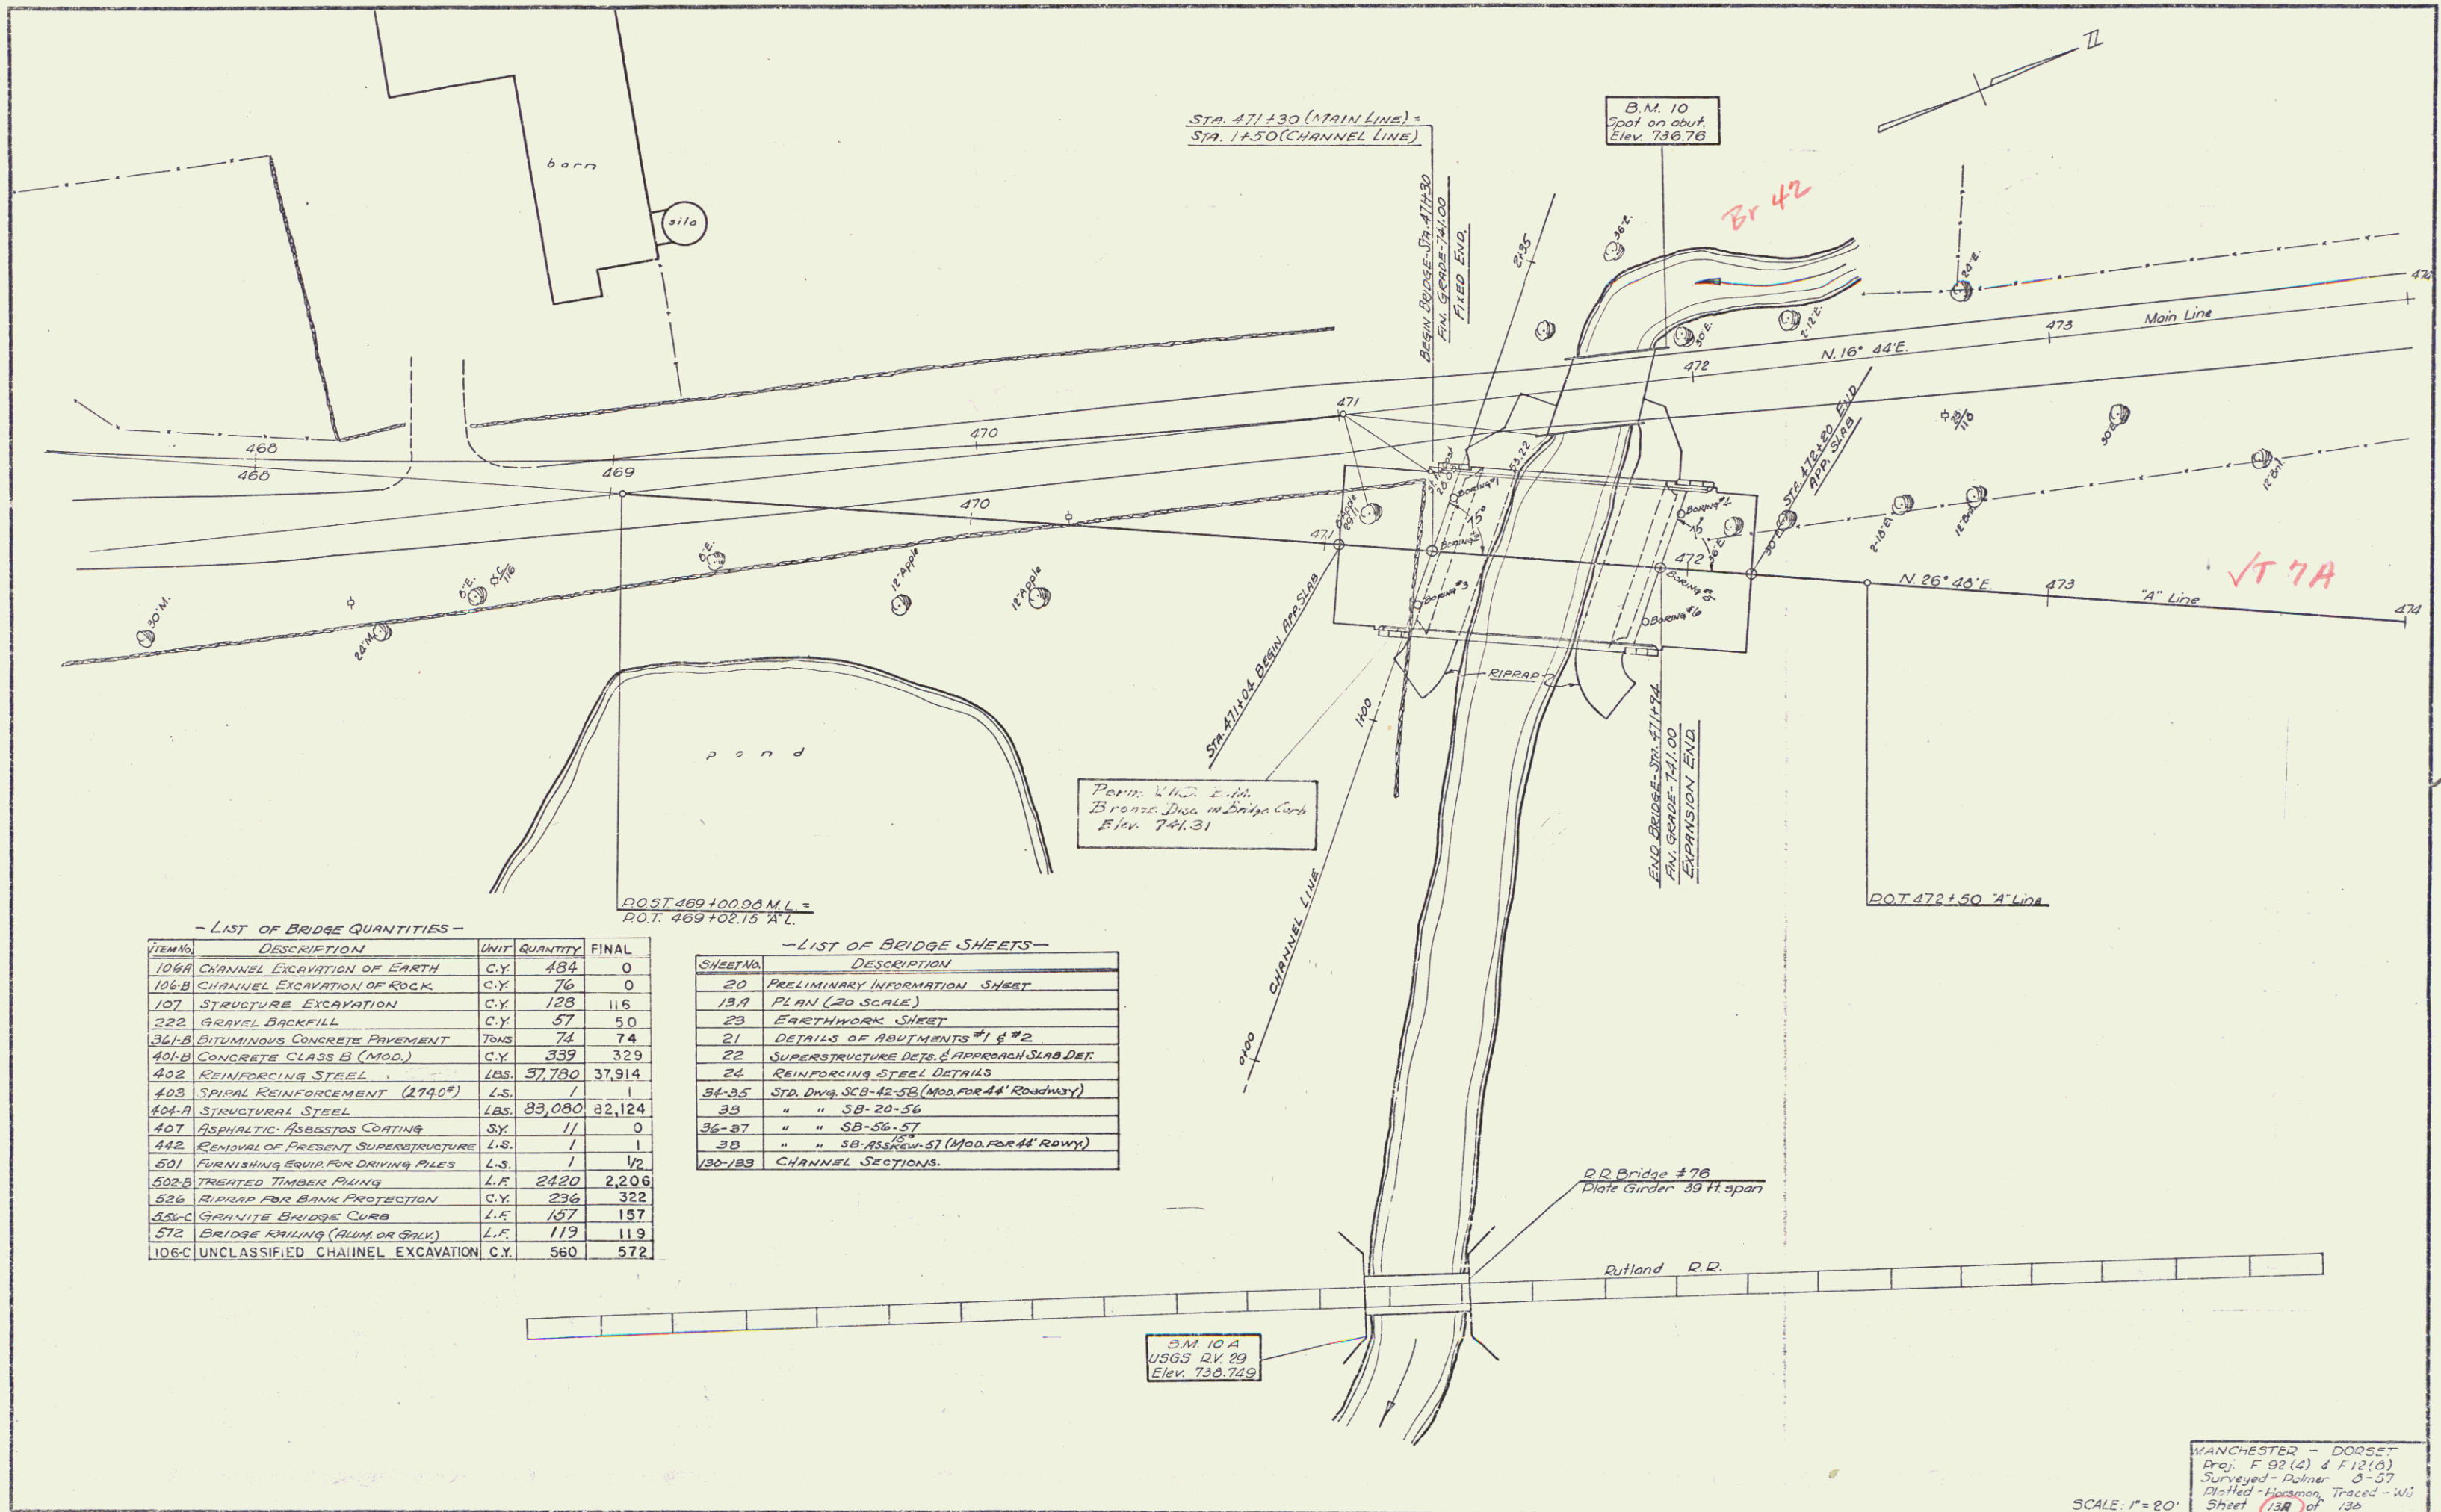

- LIST OF BRIDGE QUANTITIES -

ITEMS	DESCRIPTION	UNIT	QUANTITY	FINAL
106A	CHANNEL EXCAVATION OF EARTH	C.Y.	434	0
106B	CHANNEL EXCAVATION OF ROCK	C.Y.	76	0
107	STRUCTURE EXCAVATION	C.Y.	128	116
322	GRAVEL BACKFILL	C.Y.	57	50
361-B	BITUMINOUS CONCRETE PAVEMENT	TONS	74	74
401-B	CONCRETE CLASS B (MOD.)	C.Y.	339	329
402	REINFORCING STEEL	LBS.	37,780	37,914
403	SPIRAL REINFORCEMENT (274°)	LBS.	1	1
404-A	STRUCTURAL STEEL	LBS.	83,080	82,124
407	ASPHALTIC ASBESTOS COATING	SQ.	11	0
442	REMOVAL OF EXISTENT SUPERSTRUCTURE	L.S.	1	1
501	FURNISHING EQUIP FOR DRIVING PILES	L.S.	1	1/2
502-B	TREATED TIMBER PILING	L.F.	2420	2,206
526	RIPRAP FOR BANK PROTECTION	C.Y.	236	322
528-C	GRANITE BRIDGE CURB	L.F.	157	157
572	BRIDGE RAILING (RAIL OR BALU)	L.F.	119	119
106-C	UNCLASSIFIED CHANNEL EXCAVATION	C.Y.	560	572

- LIST OF BRIDGE SHEETS -


SHEET No.	DESCRIPTION
20	PRELIMINARY INFORMATION SHEET
19-A	PLAN (20 SCALE)
23	EARTHWORK SHEET
21	DETAILS OF ABUTMENTS #1 & #2
22	SUPERSTRUCTURE DETS. & APPROACH SLAB DET.
24	REINFORCING STEEL DETAILS
36-35	STR. DWG. SCB-42-5B (MOD. FOR 44' ROADWAY)
39	" " SB-20-54
36-37	" " SB-56-57
38	" " SB-ASS-57 (MOD. FOR 44' ROADWAY)
130-133	CHANNEL SECTIONS.

DOT 469+00.90 A.L. =
D.O.T. 469+02.15 'A' L.

Perms. W.D. 2-10.
Bronze Disc. in Stone Corp.
Elev. 741.31

MANCHESTER - DORSET
Proj. F 92 (2) & F 12 (2)
Surveyed - Palmer 3-37
Drafted - Harmon, Traced - WJ
Sheet 13A of 136

SCALE: 1" = 20'

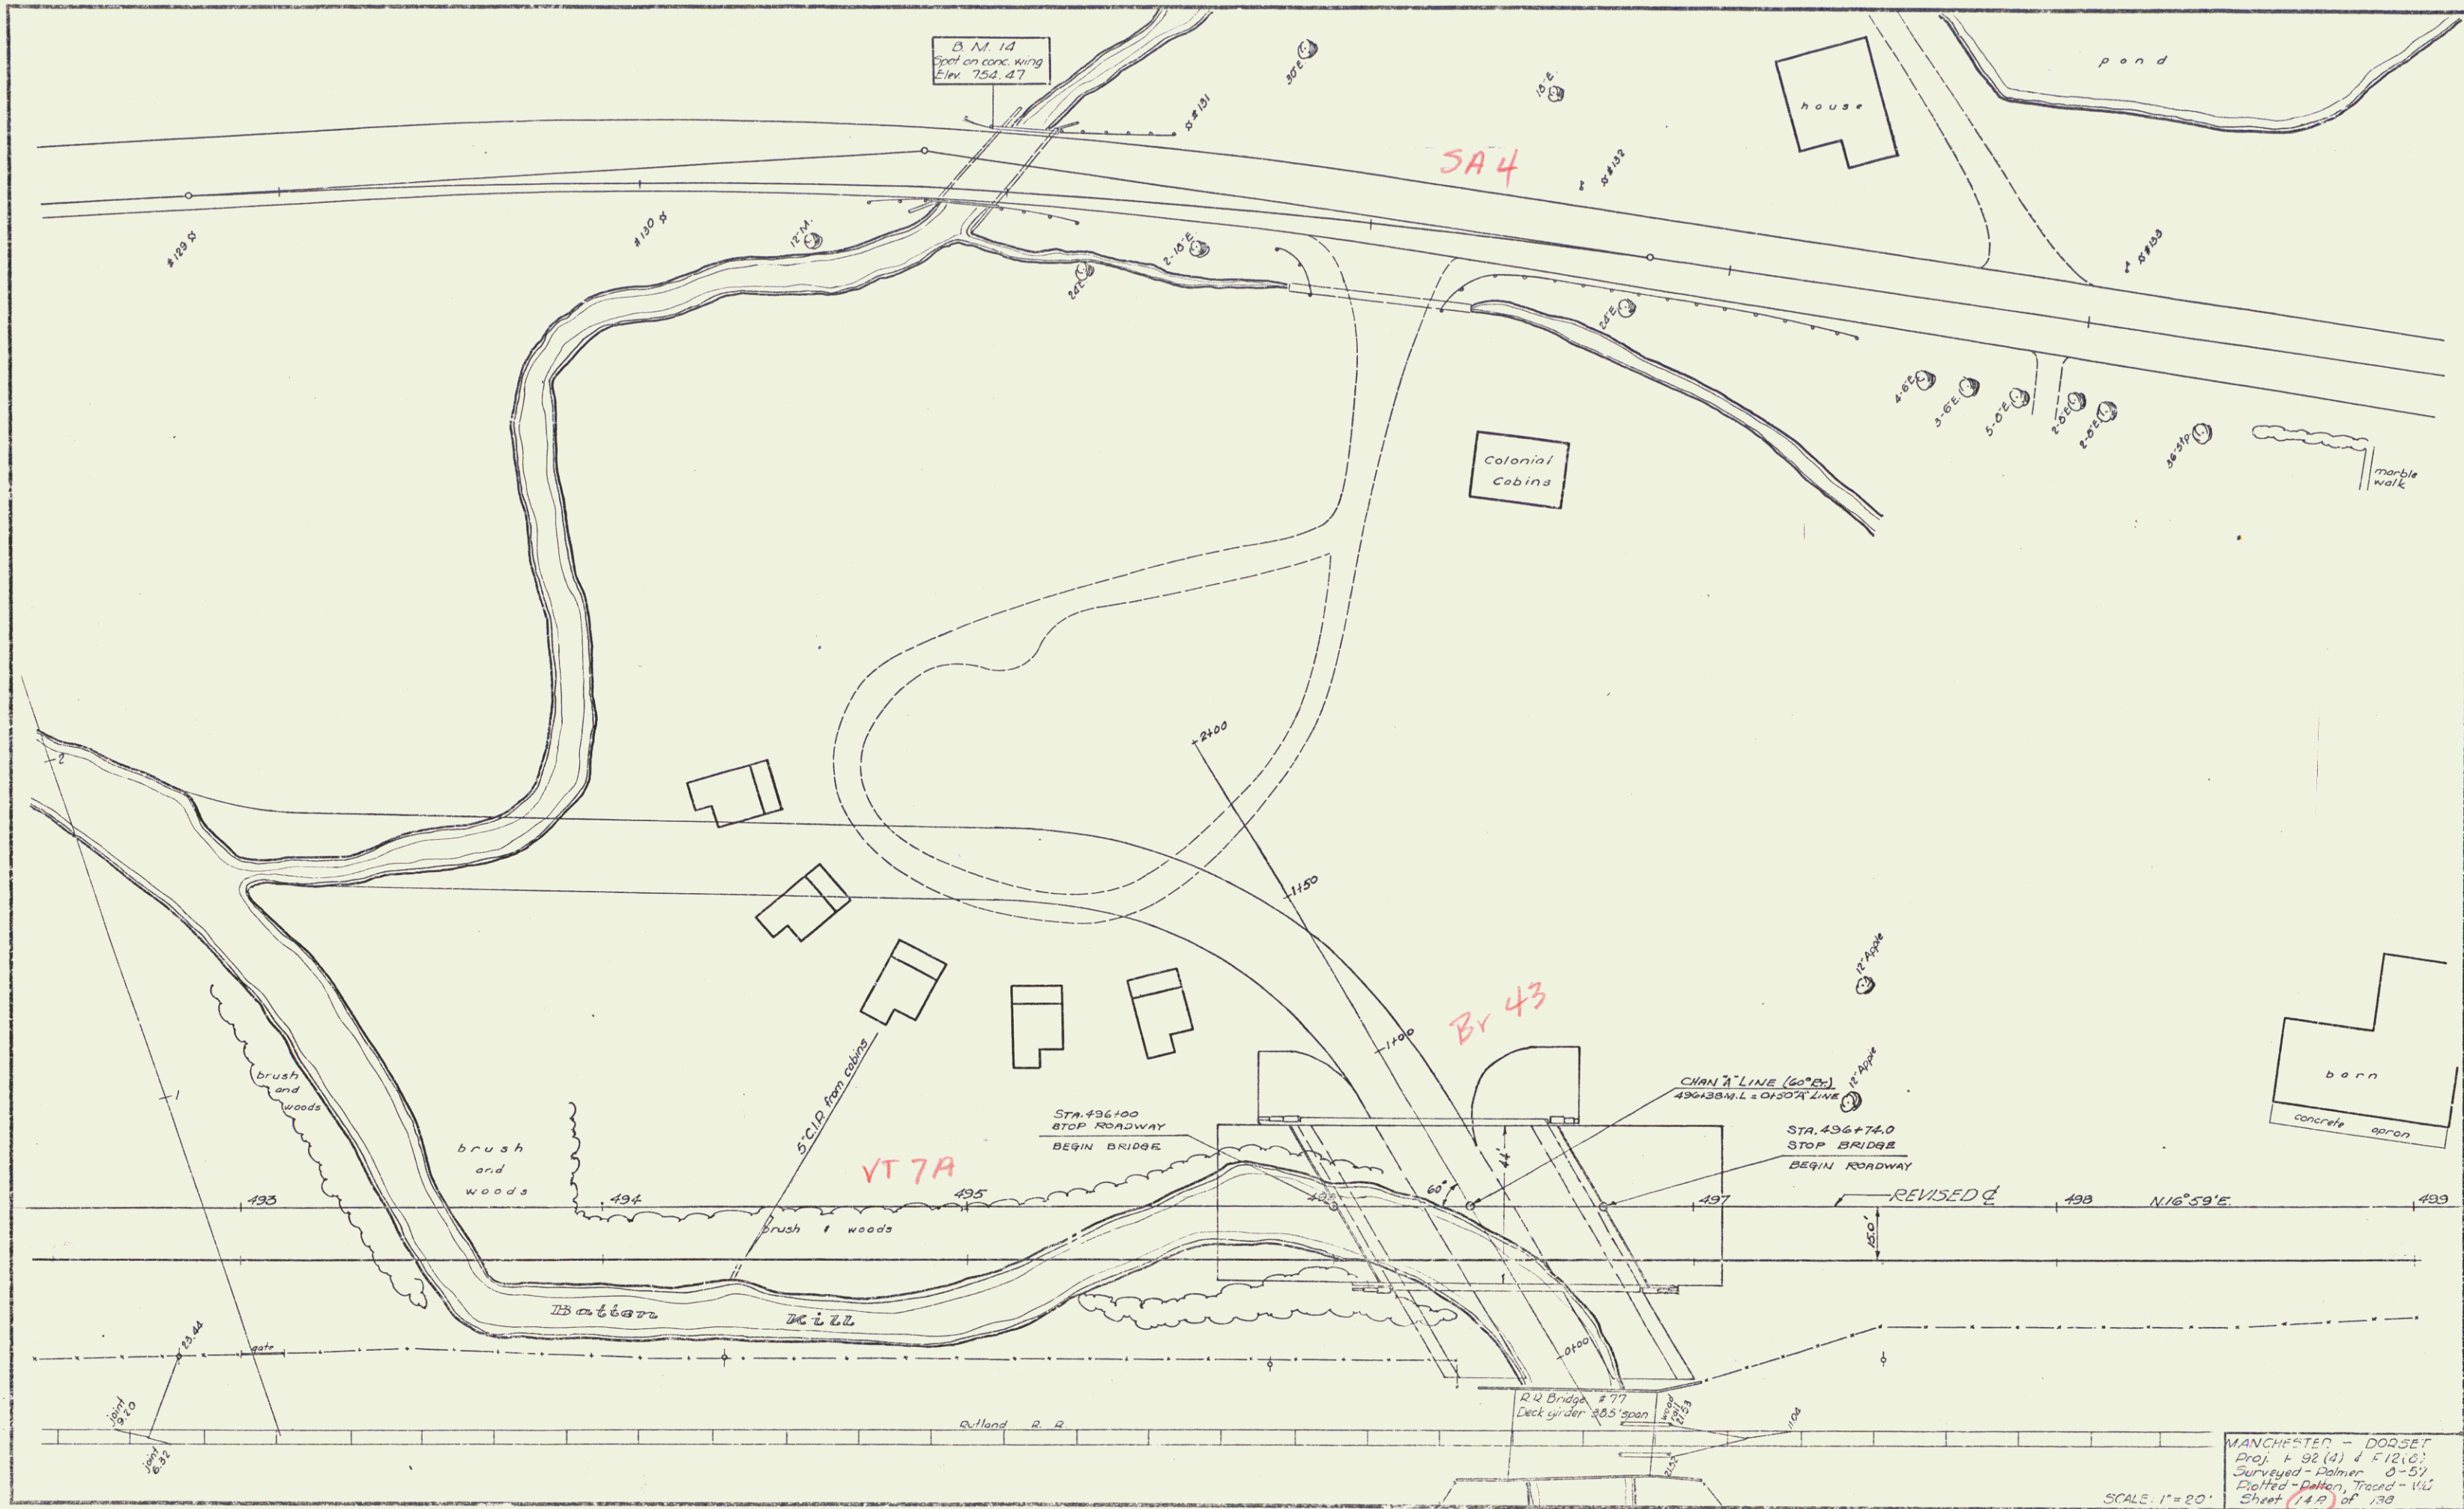

B.M. 14
Spot on conc. wing
Elev. 753.47


SA 4

Br 43

VT 7A

MANCHESTER - DORSET
Proj. 4 92 (4) 4 172 (2)
Surveyed - Palmer 5-57
Plotted - Dalton, Traced - V.L.
Sheet 14A of 138

SCALE: 1"=20'

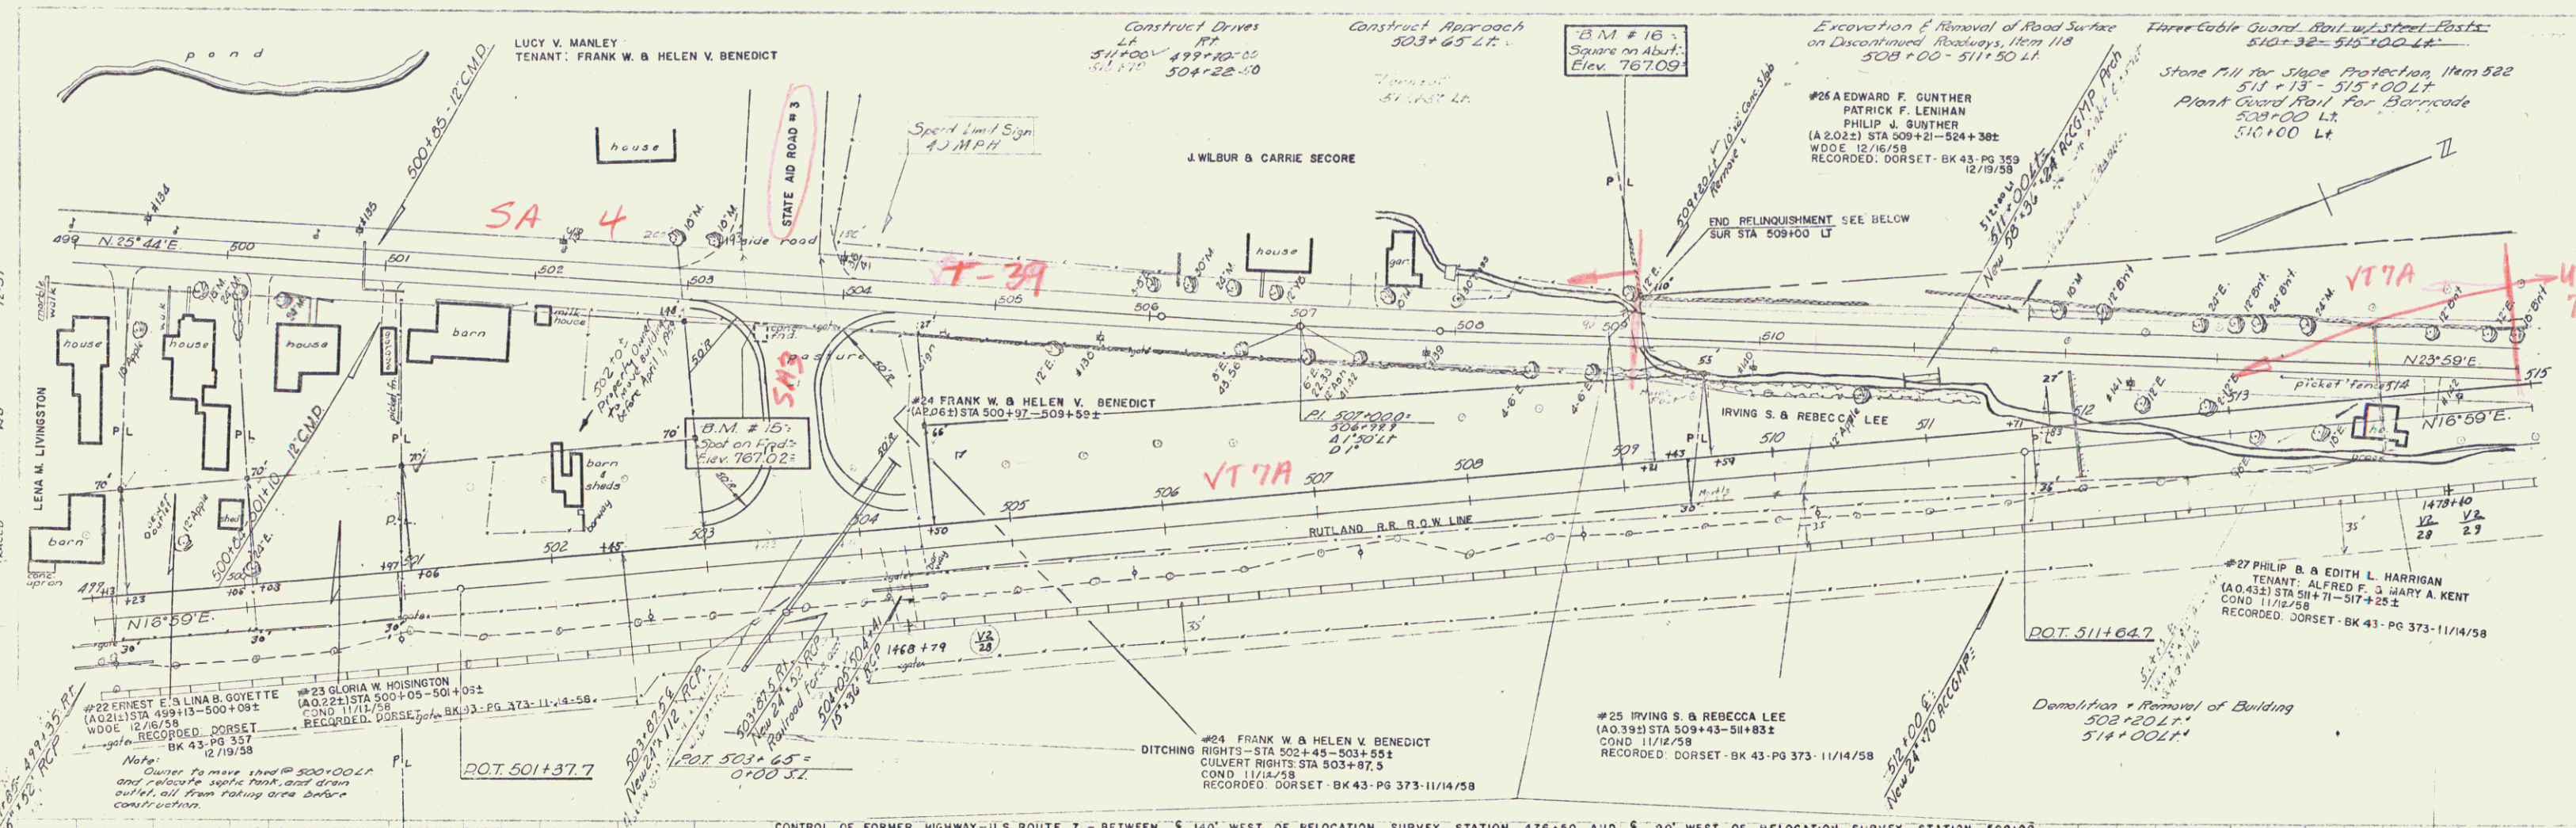

CONTROL OF FORMER HIGHWAY-U.S. ROUTE 7 - BETWEEN $\pm 140'$ WEST OF RELOCATION SURVEY STATION 476+50 AND $\pm 90'$ WEST OF RELOCATION SURVEY STATION 509+00 IS RELINQUISHED TO THE TOWN OF DORSET. RECORDED IN BOOK 41 PAGE 174, DORSET LAND RECORD, DECEMBER 4, 1959.

