
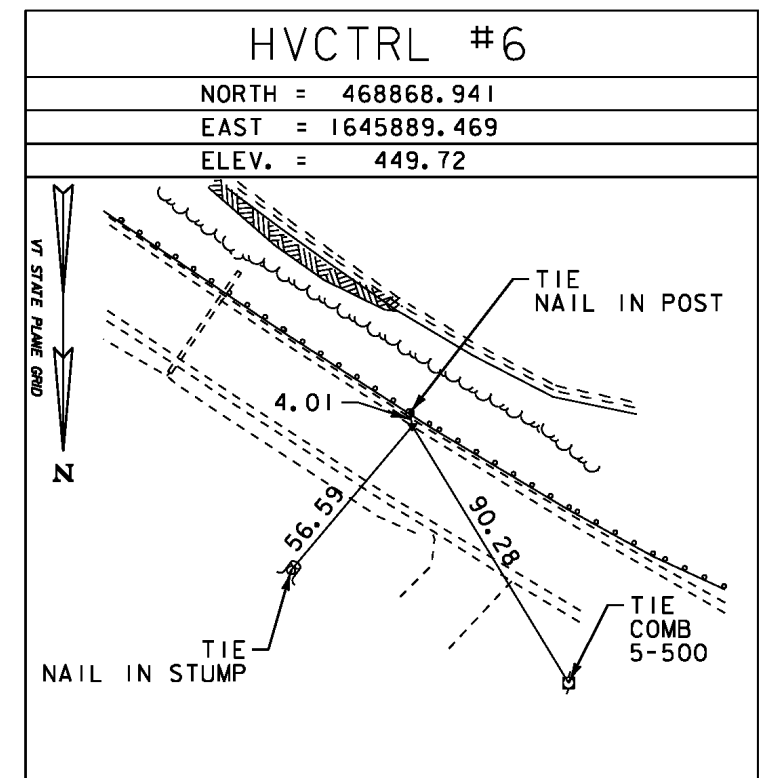
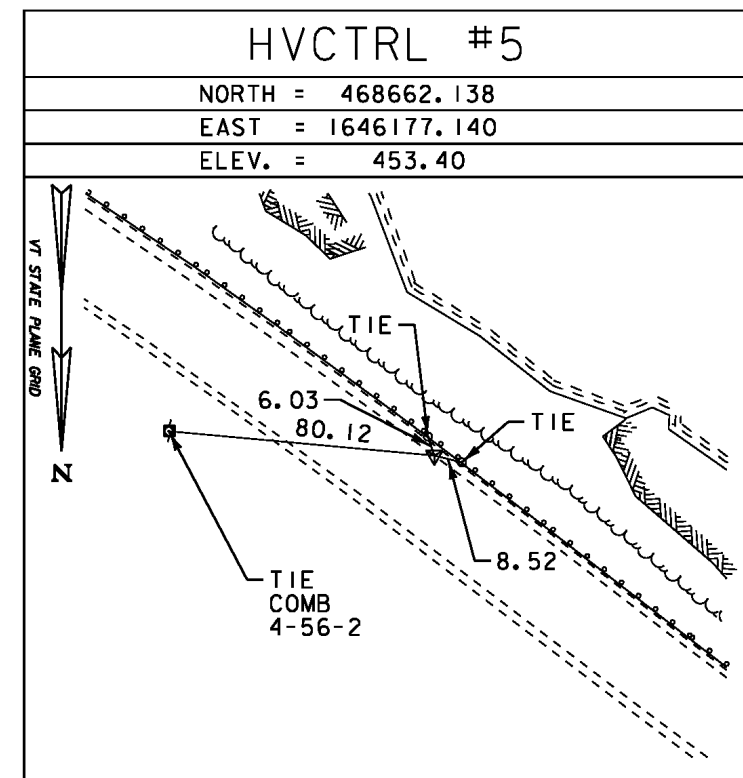
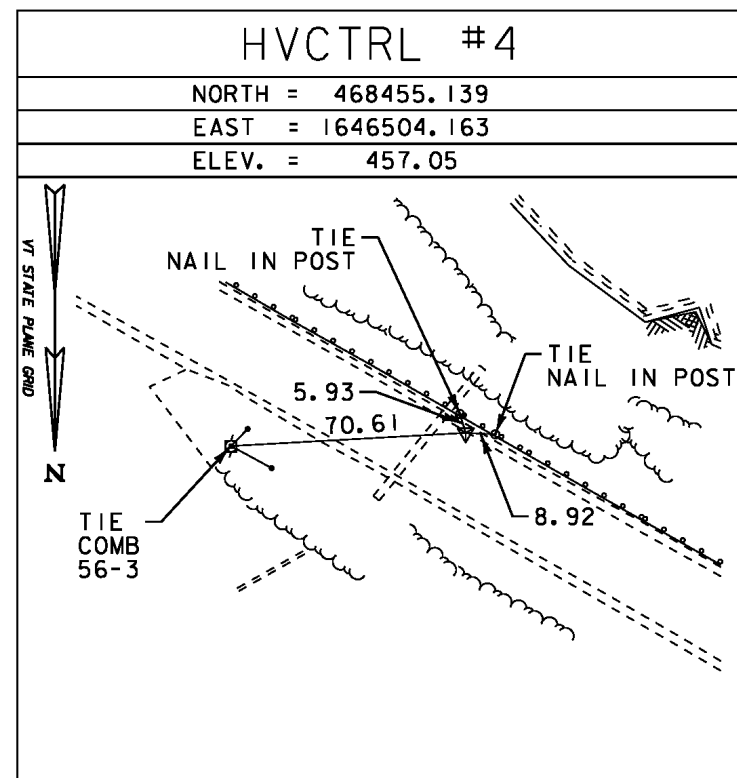
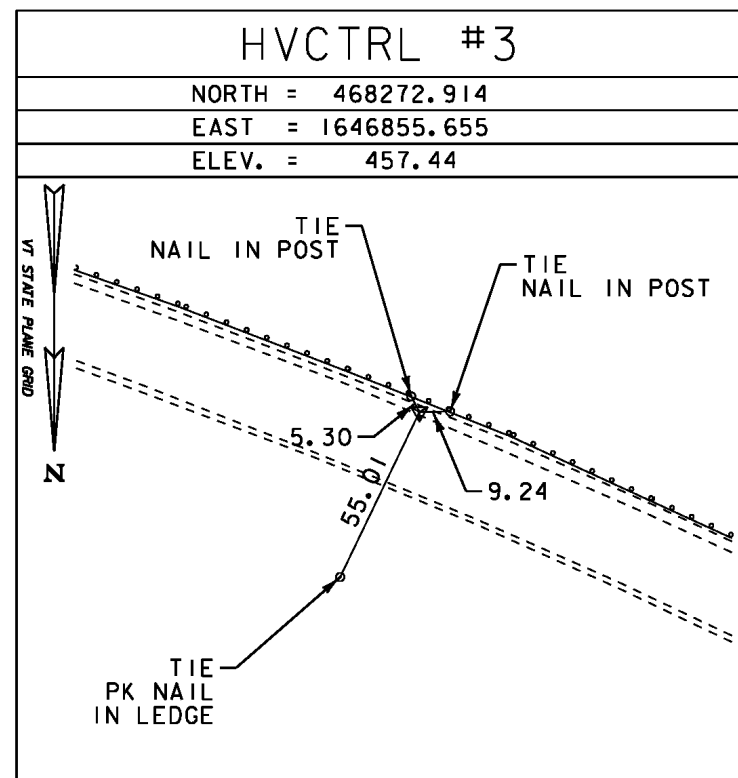







GPS CONTROL POINTS

NONE


TRAVERSE TIES

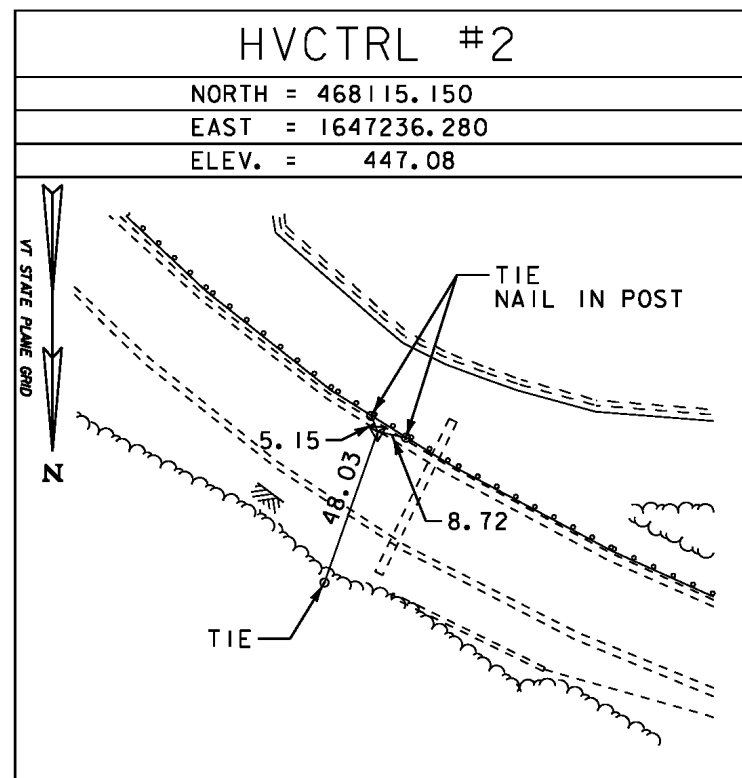

ALIGNMENT TIES

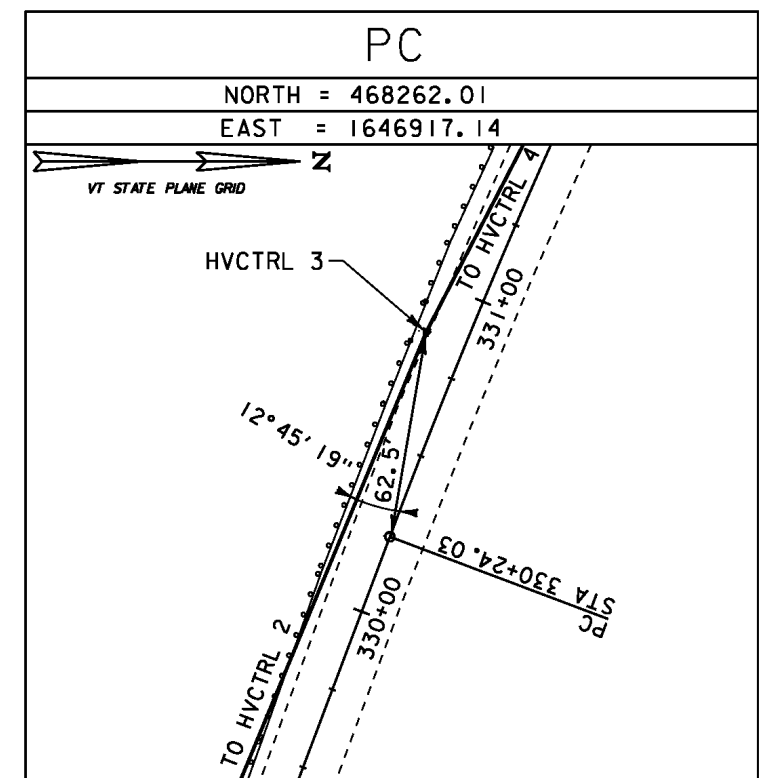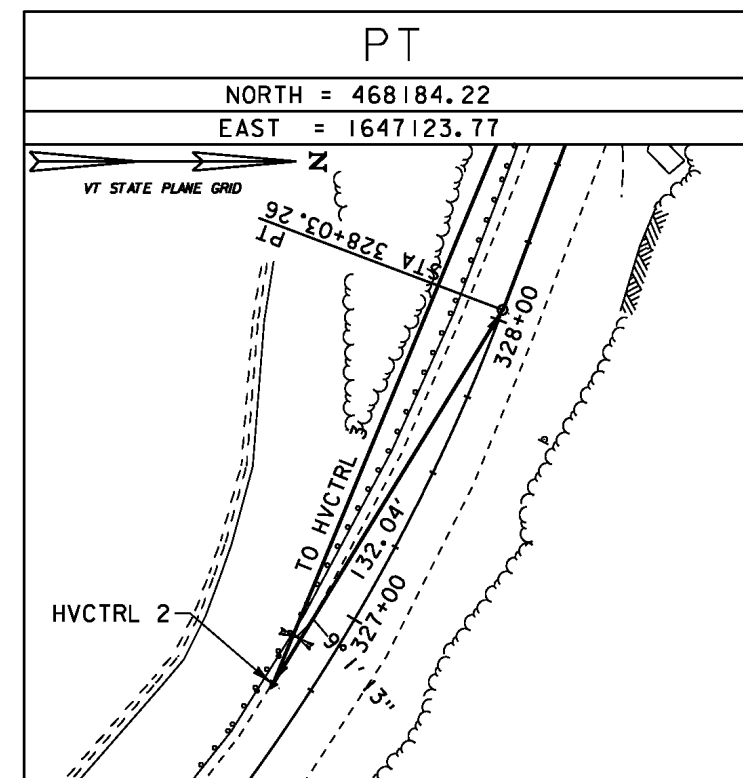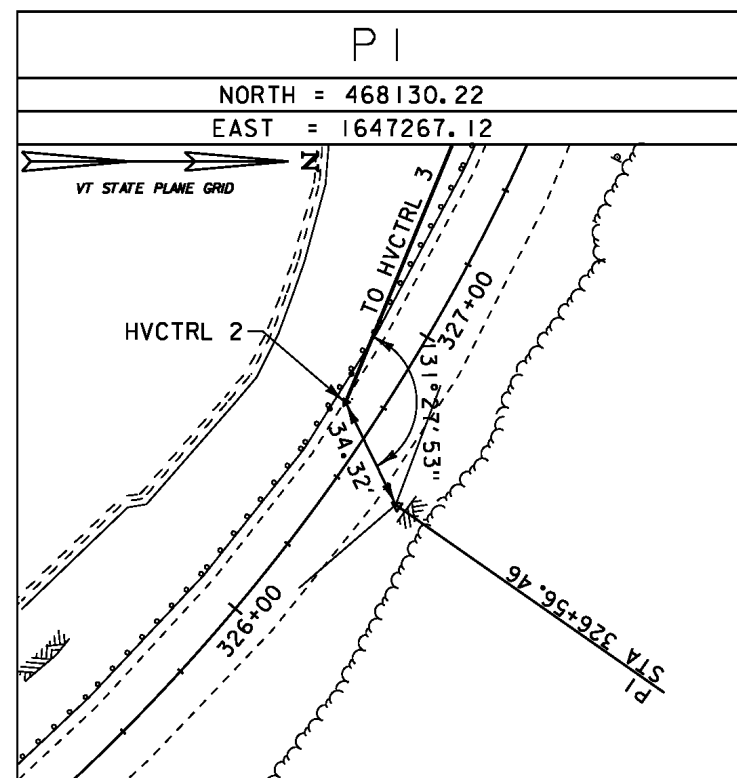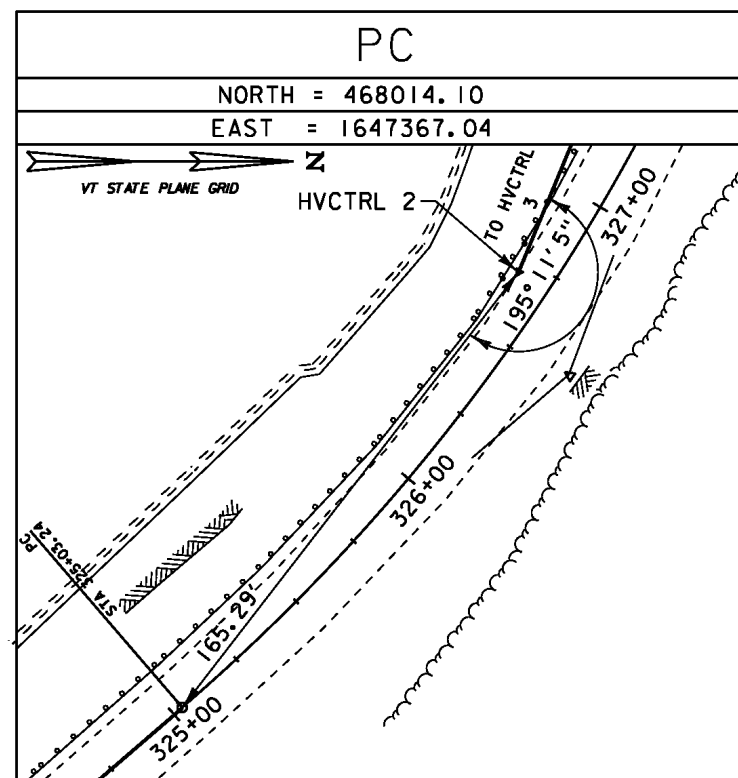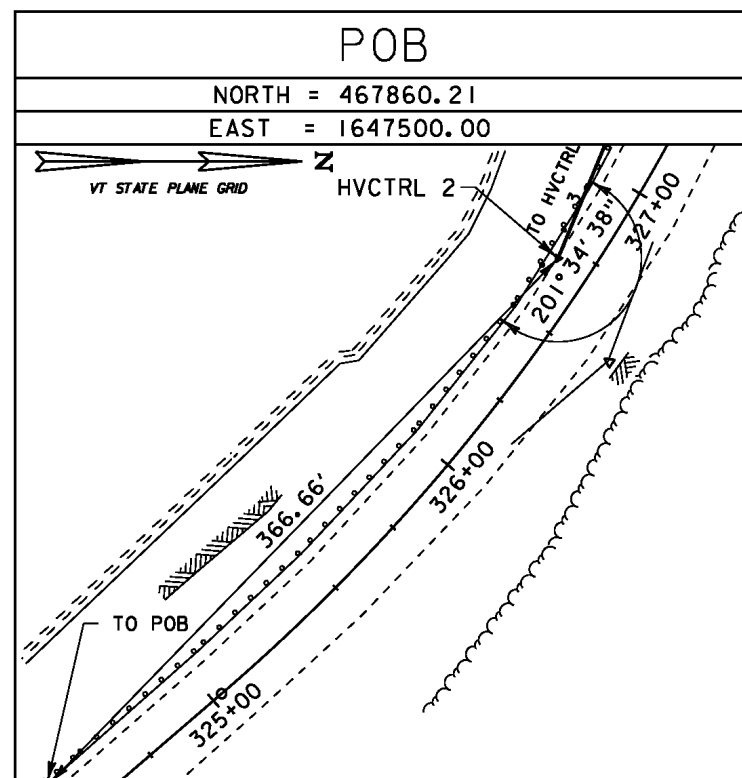

DATUM	
VERTICAL	NAVD 88
HORIZONTAL	NAD 83 (2011)
ADJUSTMENT	NONE

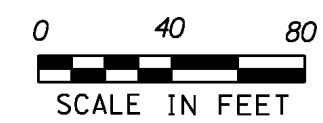

PROJECT NAME:	SHARON	FILE NAME:	z12c410+1.dgn	PLOT DATE:	10-SEP-2014
PROJECT NUMBER:	STP 0147 (20)	PROJECT LEADER:	J. TUCKER	DRAWN BY:	B. MACK
		DESIGNED BY:	B. MACK	CHECKED BY:	A. SANZ
		TIE SHEET	1	ROW SHEET	10 OF 17