

GREEN MOUNTAIN NATIONAL FOREST

R=333.00'  
L=241.15'  
B=S62°29'54"E  
D=235.91'

R=319.60'  
L=255.50'  
B=S63°58'37"E  
D=248.75'

R=717.00'  
L=193.25'  
B=S75°31'22"E  
D=192.66'

R=267.00'  
L=193.35'  
B=S62°29'54"E  
D=189.15'

R=783.00'  
L=211.04'  
B=S75°31'22"E  
D=210.40'

MATCH LINE SHEET 3

MATCH LINE SHEET 1

MIDDLEBURY COLLEGE

© 2014  
horizons  
Engineering  
All rights reserved

**BLAIS - HORIZONS**  
Surveying & Engineering  
17 Sunset Terrace ~ Newport, VT 05855  
Phone 802.334.6434 ~ Fax 802.334.5602

VERMONT ROUTE 125  
STATUTORY SURVEY  
HANCOCK, ADDISON COUNTY, VERMONT

PREPARED FOR

VERMONT AGENCY OF  
TRANSPORTATION

1 NATIONAL LIFE DRIVE  
MONTPELIER, VT 05633-5001


MONUMENT DETAIL TABLE

PT.	NORTHING	EASTING	BASELINE OFFSET	DESCRIPTION
9	525899.73	1518222.34	8+93.08 33.51 L	FENO MARKER FLUSH WITH GRADE
10	525881.95	1518265.92	9+41.85 33.05 L	5/8-INCH REBAR 0.7' AG
11	525833.78	1518452.46	11+41.68 23.06 L	5/8-INCH REBAR 1.0' AG
12	525819.21	1518575.46	12+65.60 29.27 L	5/8-INCH REBAR 0.8' AG
13	525710.27	1518784.71	14+85.27 31.65 L	5/8-INCH REBAR 0.8' AG
14	525620.00	1518865.29	16+05.95 33.31 L	5/8-INCH REBAR 0.2' AG
282	525545.97	1518842.90	16+44.35 33.85 R	5/8-INCH REBAR 0.2' AG
283	525666.32	1518735.47	14+84.61 34.35 R	FENO MARKER 0.5' AG
284	525753.67	1518567.69	12+67.68 36.70 R	5/8-INCH REBAR 0.7' AG
285	525768.24	1518444.70	11+43.27 33.92 R	5/8-INCH REBAR 1.0' AG
286	525820.84	1518240.98	9+39.60 32.91 R	5/8-INCH REBAR 0.7' AG
287	525831.42	1518215.06	9+12.54 32.38 R	5/8-INCH REBAR 0.7' AG



*Nathan P. Nadeau* 7/24/2014  
NATHAN P. NADEAU, LS DATE

I CERTIFY THAT THIS IS A CORRECT SURVEY TO THE BEST OF MY KNOWLEDGE BASED UPON AN EDM TOTAL STATION AND GPS FIELD SURVEY AND TOWN OF HANCOCK AND REFERENCED LAND AND HIGHWAY RECORDS. THIS PLAT MEETS THE REQUIREMENTS OF 27 VSA SECTION 1403.

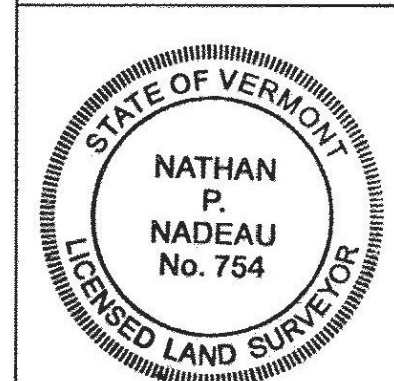

DATE:	7-23-2014	SCALE:	1IN. = 40FT.
SURV'D BY:	DR/JB/JN	DRAWN BY:	NPN/AJN
CHECK'D BY:	NPN/AJN	PROJECT #:	12568

SHEET 2 OF 45

BLAIS-HORIZONS CERTIFIES THAT THIS DRAWING WAS PRODUCED AS AN ORIGINAL INK ON MYLAR

SIGNATURE