

MATCH LINE SHEET 31

MATCH LINE SHEET 33

WALTER ENGLEHARDT, JR.
BOOK 25, PAGES 6-7

THOMAS B. PERERA
& GRETCHEN PERERA
BOOK 16, PAGE 172

JACQUES VEILLEUX
BOOK 19, PAGE 156

KATHERINE HODGETTS
BOOK 20, PAGE 51

KATHERINE HODGETTS
BOOK 20, PAGE 51

© 2014
horizons
Engineering
All rights reserved

BLAIS - HORIZONS
Surveying & Engineering
17 Sunset Terrace ~ Newport, VT 05855
Phone 802.334.6434 ~ Fax 802.334.5602


VERMONT ROUTE 125
STATUTORY SURVEY
HANCOCK, ADDISON COUNTY, VERMONT

PREPARED FOR

VERMONT AGENCY OF
TRANSPORTATION
1 NATIONAL LIFE DRIVE
MONTPELIER, VT 05633-5001


MONUMENT DETAIL TABLE

PT.	NORTHING	EASTING	BASELINE OFFSET	DESCRIPTION
102	520592.35	1539742.25	266+90.76 24.74 L	5/8-INCH REBAR FLUSH WITH GRADE
103	520577.83	1539962.00	269+10.99 24.75 L	5/8-INCH REBAR FLUSH WITH GRADE
104	520547.03	1540212.72	271+60.95 24.75 L	FENO MARKER FLUSH WITH GRADE
167	520498.31	1540203.94	271+60.95 24.75 R	5/8-INCH REBAR 0.5' AG
168	520528.44	1539958.73	269+10.99 24.75 R	FENO MARKER 0.3' AG
169	520549.58	1539639.16	265+90.72 24.75 R	5/8-INCH REBAR FLUSH WITH GRADE

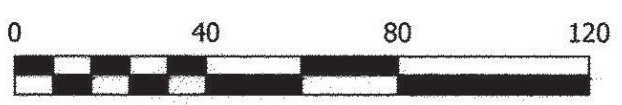

Nathan P. Nadeau 7/24/2014
NATHAN P. NADEAU, LS DATE

I CERTIFY THAT THIS IS A CORRECT SURVEY TO THE BEST OF MY KNOWLEDGE BASED UPON AN EDM TOTAL STATION AND GPS FIELD SURVEY AND TOWN OF HANCOCK AND REFERENCED LAND AND HIGHWAY RECORDS. THIS PLAT MEETS THE REQUIREMENTS OF 27 VSA SECTION 1403.

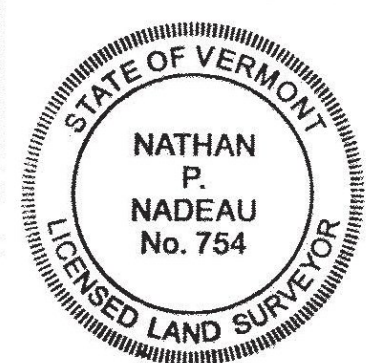

DATE: 7-23-2014	SCALE 1IN. = 40FT.
SURV'D BY: DR/JB/JN	DRAWN BY: NPN/AJN
CHECK'D BY: NPN/AJN	PROJECT #: 12568

SHEET 32 OF 45

BLAIS-HORIZONS CERTIFIES THAT THIS DRAWING WAS PRODUCED AS AN ORIGINAL INK ON MYLAR

SIGNATURE