

PLAN
 PROPERTY: Leonard Rossier
 DATE: 10/1/75
 DRAWN BY: A. Chapman
 CHECKED BY: J. S. Smith
 SCALE: 1" = 40'

PROF
 PROPERTY: Leonard Rossier
 DATE: 10/1/75
 DRAWN BY: A. Chapman
 CHECKED BY: J. S. Smith
 SCALE: 1" = 10'

CONSTRUCT SPECIAL DITCH
 TO BE PAID FOR UNDER THE
 ITEM OF 101-A
 LI
 292+00 - 293+42.2

TWO CABLE GUARD RAIL
 RI
 292+00 - 292+15
 295+35 - 295+40





CONSTRUCT DRIVES
 LI
 295+35 - 295+40
 RI
 295+35 - 295+40

WOOD GUIDE POSTS
 292+25 - 294+00

PARCEL: 8A
 STA: 290+75 - 317+70
 GRANTOR: LEONARD E. ROSSIER
 TAKING: 0.98 A
 RIGHTS: DRIVE - 292+35 TO 295+40, 295+40 TO 295+40
 SLOPE: 292+35 - 295+40, 295+40 - 295+40
 TITLE TAKEN: 0.98 A
 RECORDED: BA PB DT

PARCEL: 8A
 STATIONS: 294+66 - 317+70
 TAKING: 0.98 A

PARCEL: 8B
 STATIONS: 290+75 - 307+72
 TAKING: 0.6 A

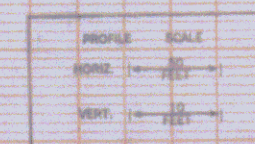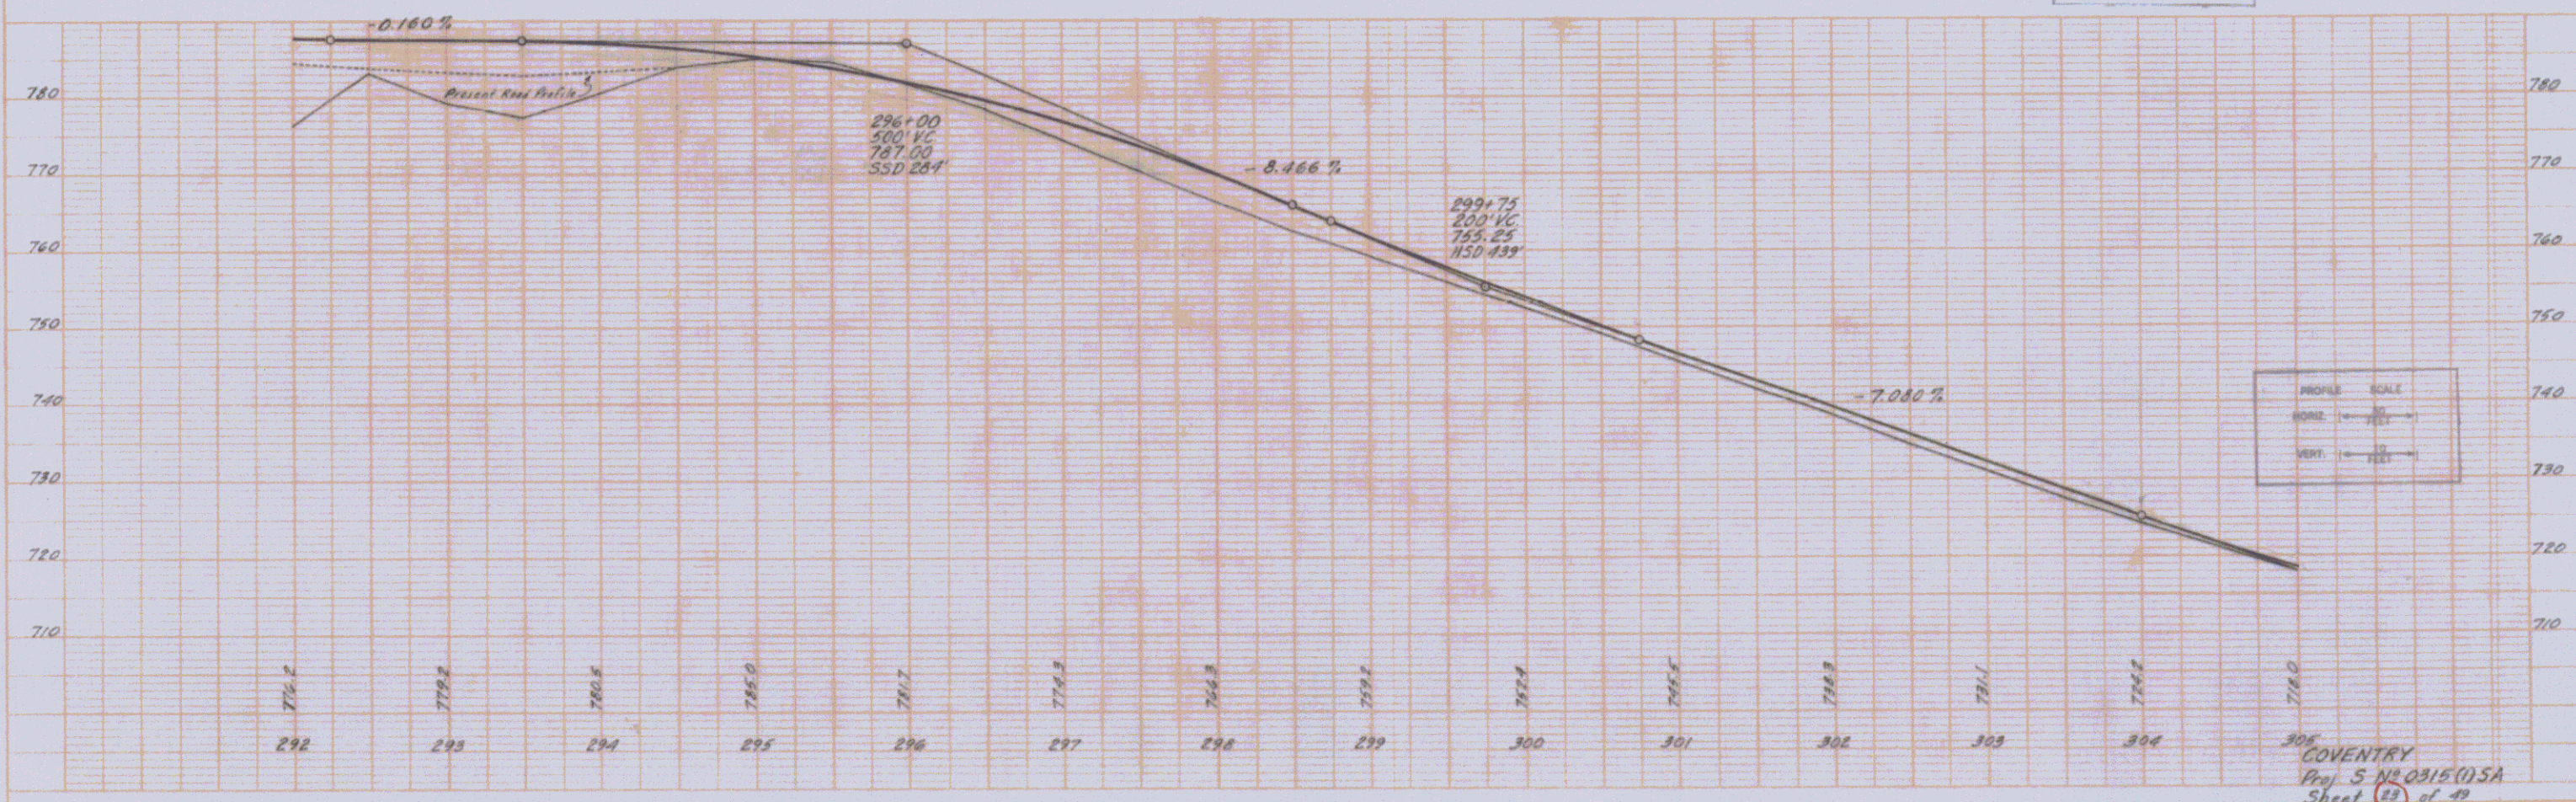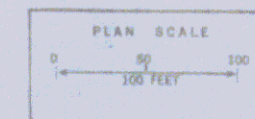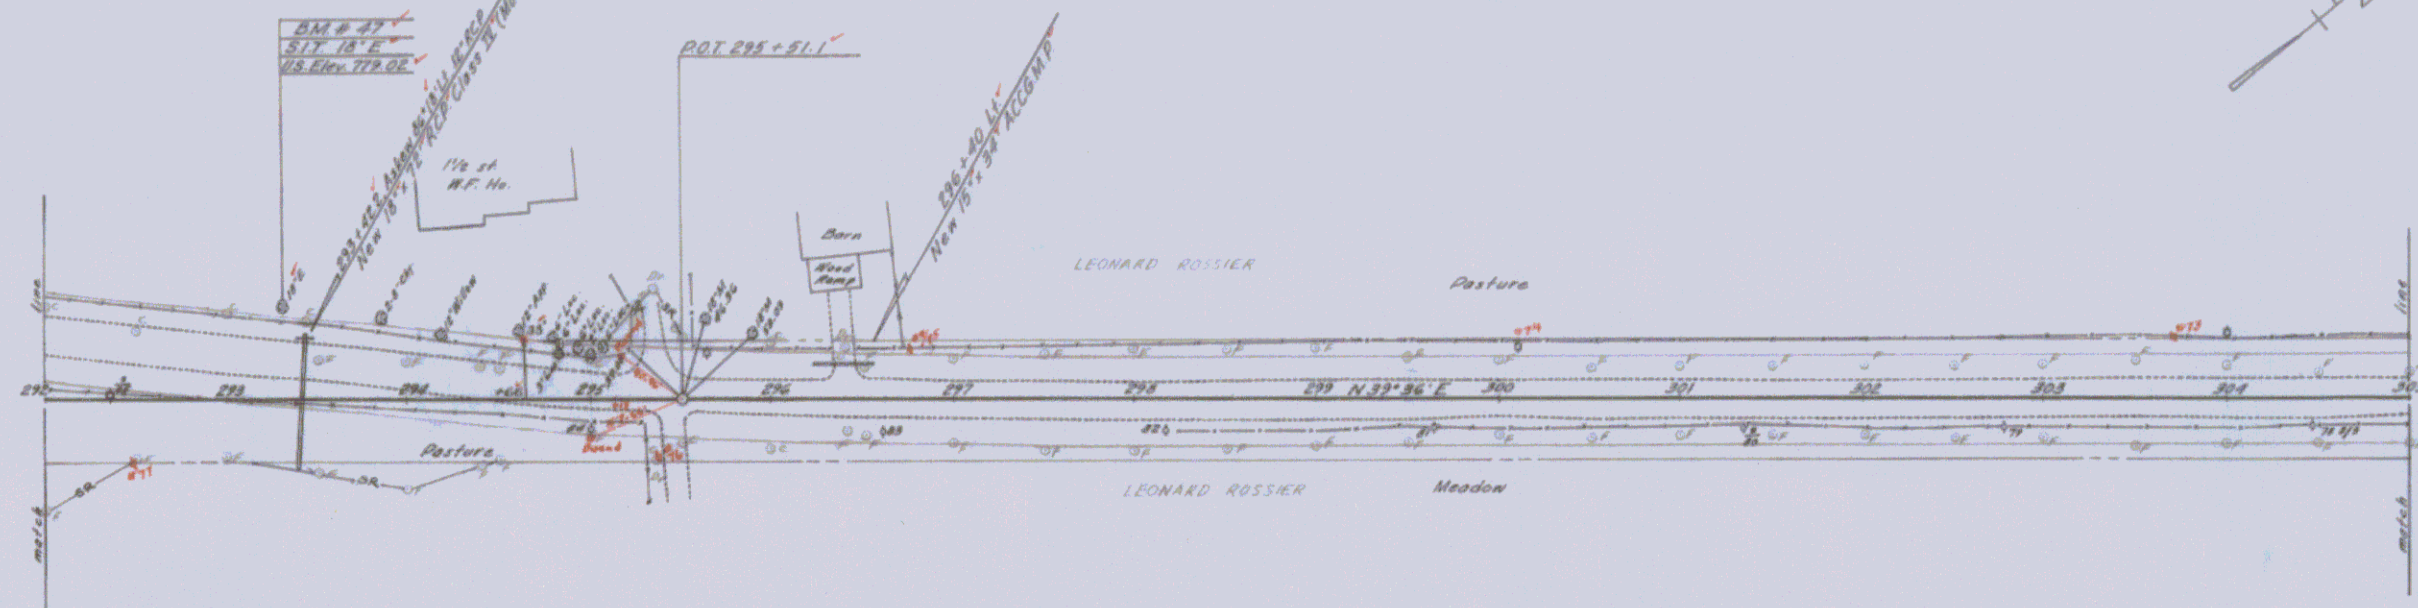

COVENTRY
 Proj 5 N° 0315 (1) SA
 Sheet 13 of 49