



- NOTES:**
1. ALL TRAFFIC SIGNS PER 21 PAY ITEM 821.00 AND PLANNED CHANNEL 300 R/W PER 21 PAY ITEM 821.00.
 2. SEE LANDSCAPE DETAILS, SHEET LD, FOR LANDSCAPE ITEM DESCRIPTIONS AND SCHEDULE. EXAMPLE: CP-5. CP DENOTES PLANT NAME, S DENOTES NUMBER OF UNITS PER GROUP.
 3. INSTALL VEHICLE BARRIER POSTS PER 821.00. INSTALL REMOVABLE VEHICLE BARRIER POSTS PER 821.00. SEE SHEET LD.

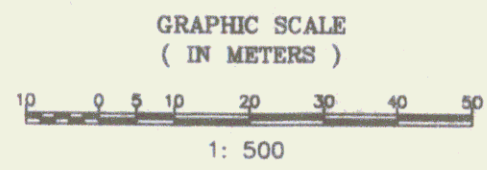

Metric

DATUM:
 VERTICAL: NOV1929
 HORIZONTAL: N/A

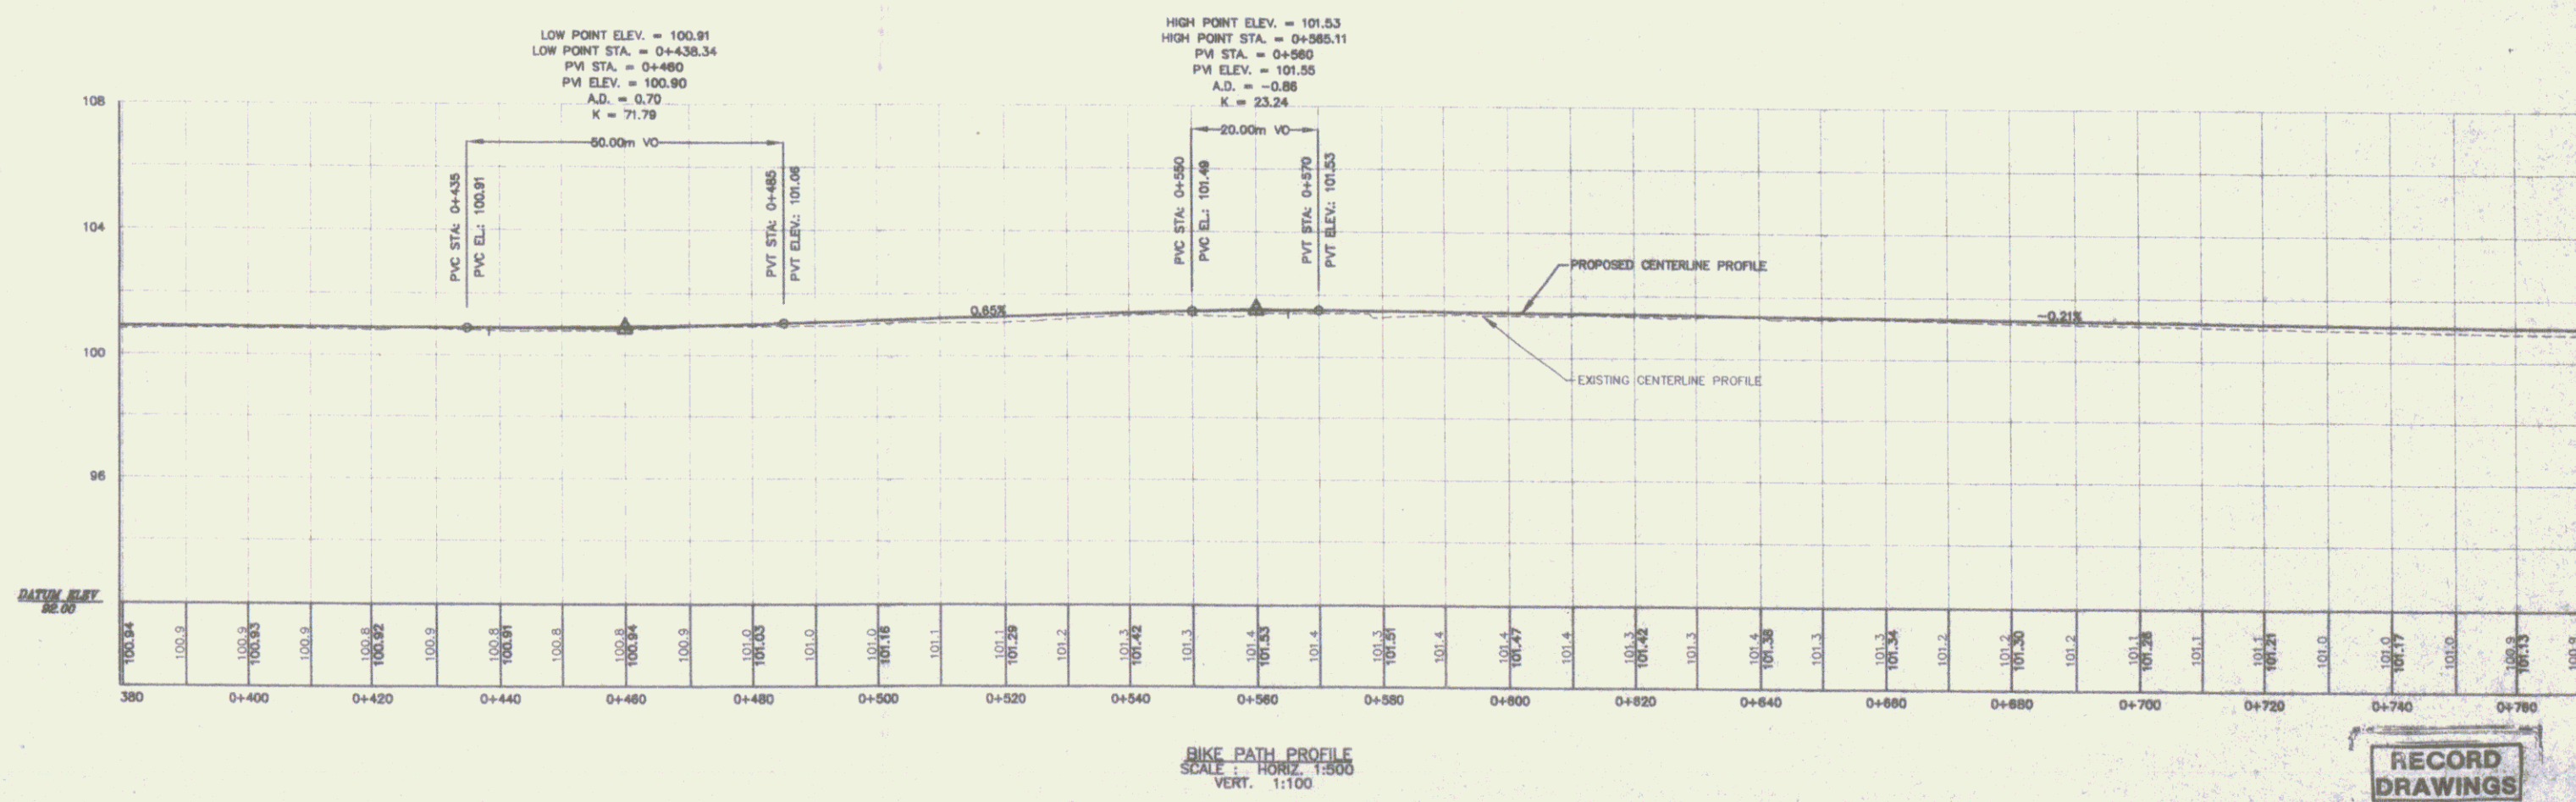

RECORD DRAWINGS

Springfield Transportation Path Phase 1
TOWN OF SPRINGFIELD
SPRINGFIELD, VERMONT
PLAN AND PROFILE

PP2

SHEET 4