


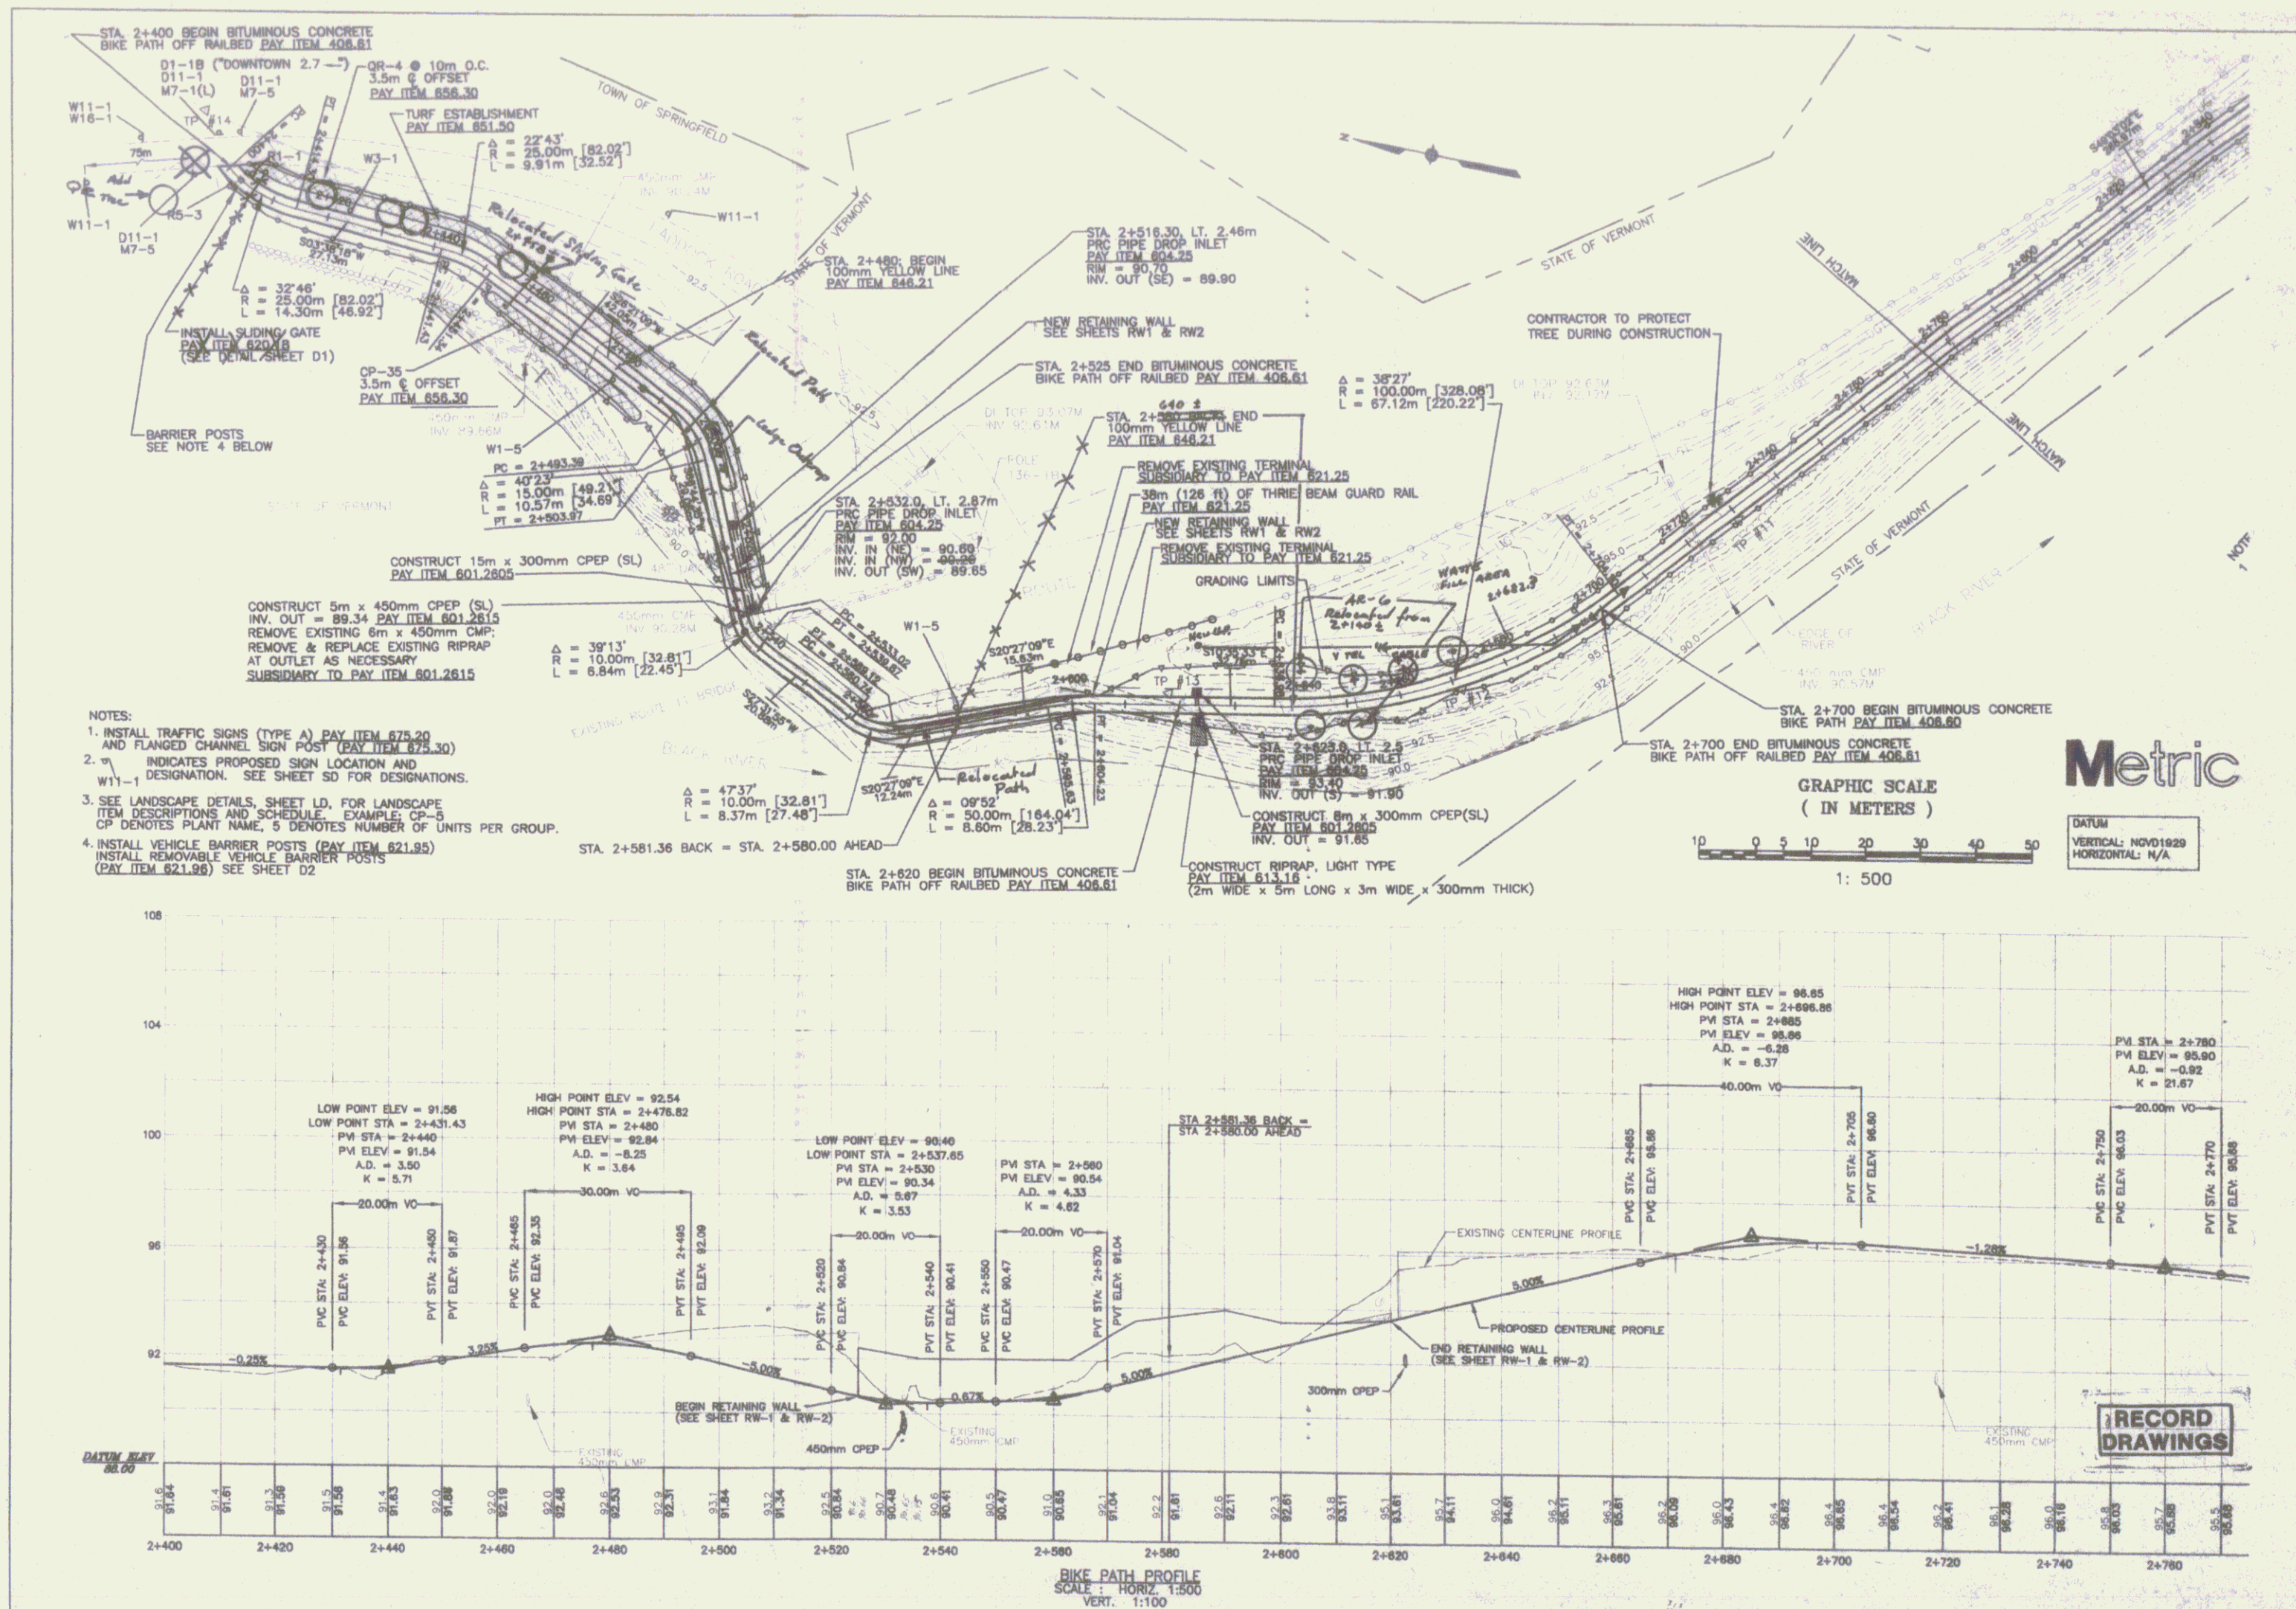

Springfield

DESIGNED BY: [Signature]
CHECKED BY: [Signature]
DATE: 11/19/2019
SCALE: AS SHOWN

**SPRINGFIELD TRANSPORTATION PATH
TOWN OF SPRINGFIELD
SPRINGFIELD, VERMONT
PLAN AND PROFILE**

PP7

9