



- NOTES:
1. INSTALL TRAFFIC SIGNS (TYPE A) PAY ITEM 675.20 AND FLANGED CHANNEL SIGN POST (PAY ITEM 675.30)
 2. W INDICATES PROPOSED SIGN LOCATION AND DESIGNATION. SEE SHEET 50 FOR DESIGNATIONS. W11-1
 3. SEE LANDSCAPE DETAILS, SHEET LD, FOR LANDSCAPE ITEM DESCRIPTIONS AND SCHEDULE. EXAMPLE: CP-5 CP DENOTES PLANT NAME, 5 DENOTES NUMBER OF UNITS PER GROUP.
 4. INSTALL VEHICLE BARRIER POSTS (PAY ITEM 621.95) INSTALL REMOVABLE VEHICLE BARRIER POSTS (PAY ITEM 621.96) SEE SHEET D2

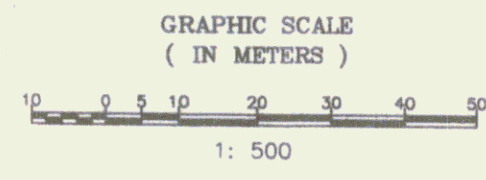

Metric

DATUM
VERTICAL: NVD1929
HORIZONTAL: N/A

PVI STA = 3+520
PVI ELEV = 102.85
A.D. = -1.46
K = 13.39

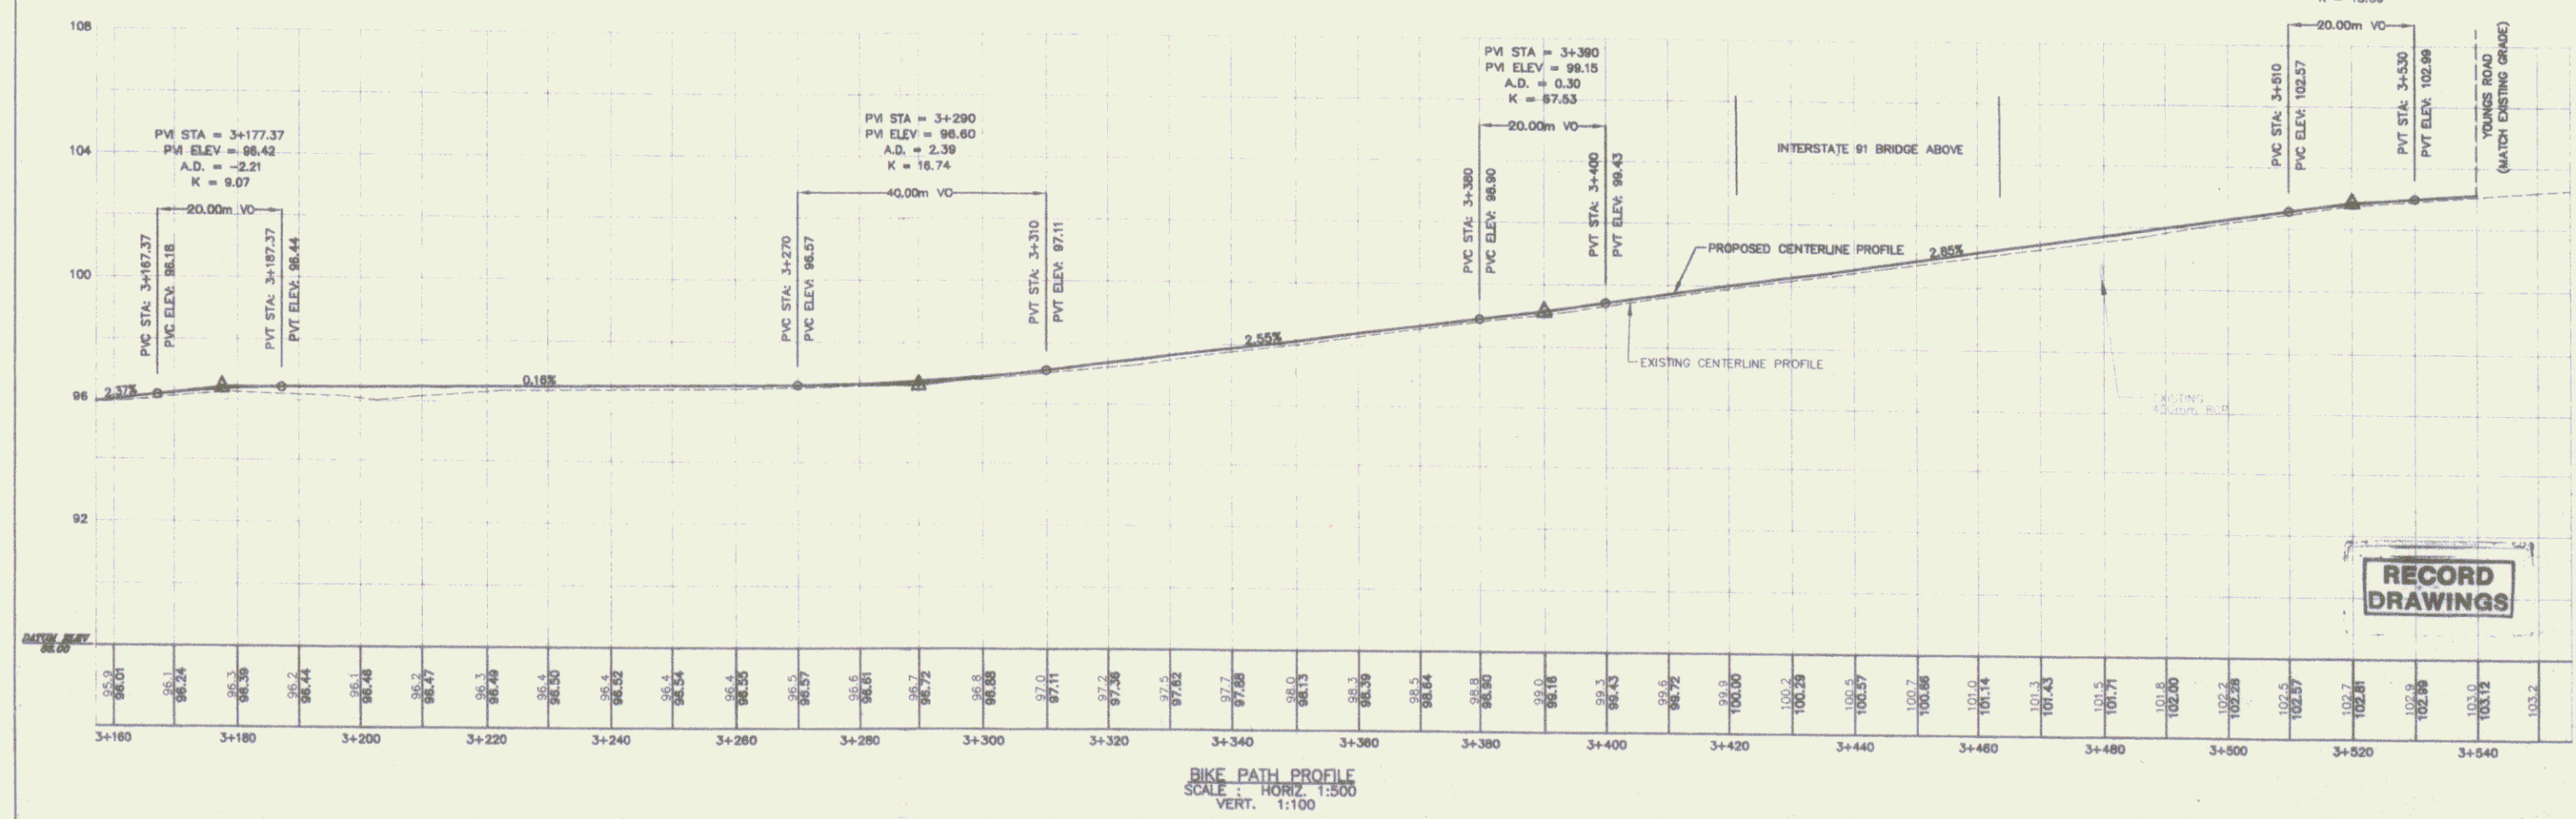

BIKE PATH PROFILE
SCALE: HORIZ. 1:500
VERT. 1:100

Duro's
Engineering & Planning
100 Parkside Road
Springfield, VT 05156
Tel: 802-883-4444

NO.	DATE	REVISIONS	BY	CHKD.
1	3/09	REVISED PER REVIEW COMMENTS	J.P.	D.F.
2	6/09	REVISED PER REVIEW COMMENTS	J.P.	D.F.



SPRINGFIELD TRANSPORTATION PATH
PHASE 1
TOWN OF SPRINGFIELD
SPRINGFIELD, VERMONT
PLAN AND PROFILE

DESIGNED BY	DATE
DAVID POIRIER	03-10-07
CHECKED BY	DATE
DAVID POIRIER	03-10-07
SCALE	AS SHOWN
1:500	1:500

METRIC
PP9