


- NOTES:
1. INSTALL TRAFFIC SIGNS (TYPE A) PAY ITEM 675.20 AND FLANGED CHANNEL SIGN POST (PAY ITEM 675.30)
 2. W11-1 INDICATES PROPOSED SIGN LOCATION AND DESIGNATION. SEE SHEET S0 FOR DESIGNATIONS.
 3. SEE LANDSCAPE DETAILS, SHEET LD, FOR LANDSCAPE ITEM DESCRIPTIONS AND SCHEDULE. EXAMPLE: CP-5 CP DENOTES PLANT NAME, 5 DENOTES NUMBER OF UNITS PER GROUP.
 4. INSTALL VEHICLE BARRIER POSTS (PAY ITEM 621.95) INSTALL REMOVABLE VEHICLE BARRIER POSTS (PAY ITEM 621.88) SEE SHEET D2

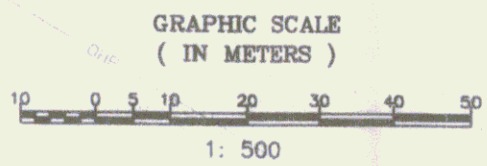

Metric

DATUM
VERTICAL: NGVD1929
HORIZONTAL: N/A

RECORD DRAWINGS

PP10

SHEET 12

12

Duro's Staff

(Principal)
(Inspector)
(Planner)
(Engineer)

NO.	DATE	REVISIONS	BY	CHK
1	3/99	REVISED PER REVIEW COMMENTS		
2	6/99	REVISED PER REVIEW COMMENTS		

100 Piedmont Road, Montpelier, Vermont, USA (802) 840-0400

STATE OF VERMONT
TOWN OF SPRINGFIELD
SPRINGFIELD TRANSPORTATION PATH
PHASE 1
TOWN OF SPRINGFIELD
SPRINGFIELD, VERMONT
PLAN AND PROFILE

DESIGNED BY: [Blank]
DRAWN BY: [Blank]
CHECKED BY: [Blank]
DATE: [Blank]

METRIC
PROJECT NUMBER: PP10