


Metric

DATUM
VERTICAL: NAVD1929
HORIZONTAL: N/A

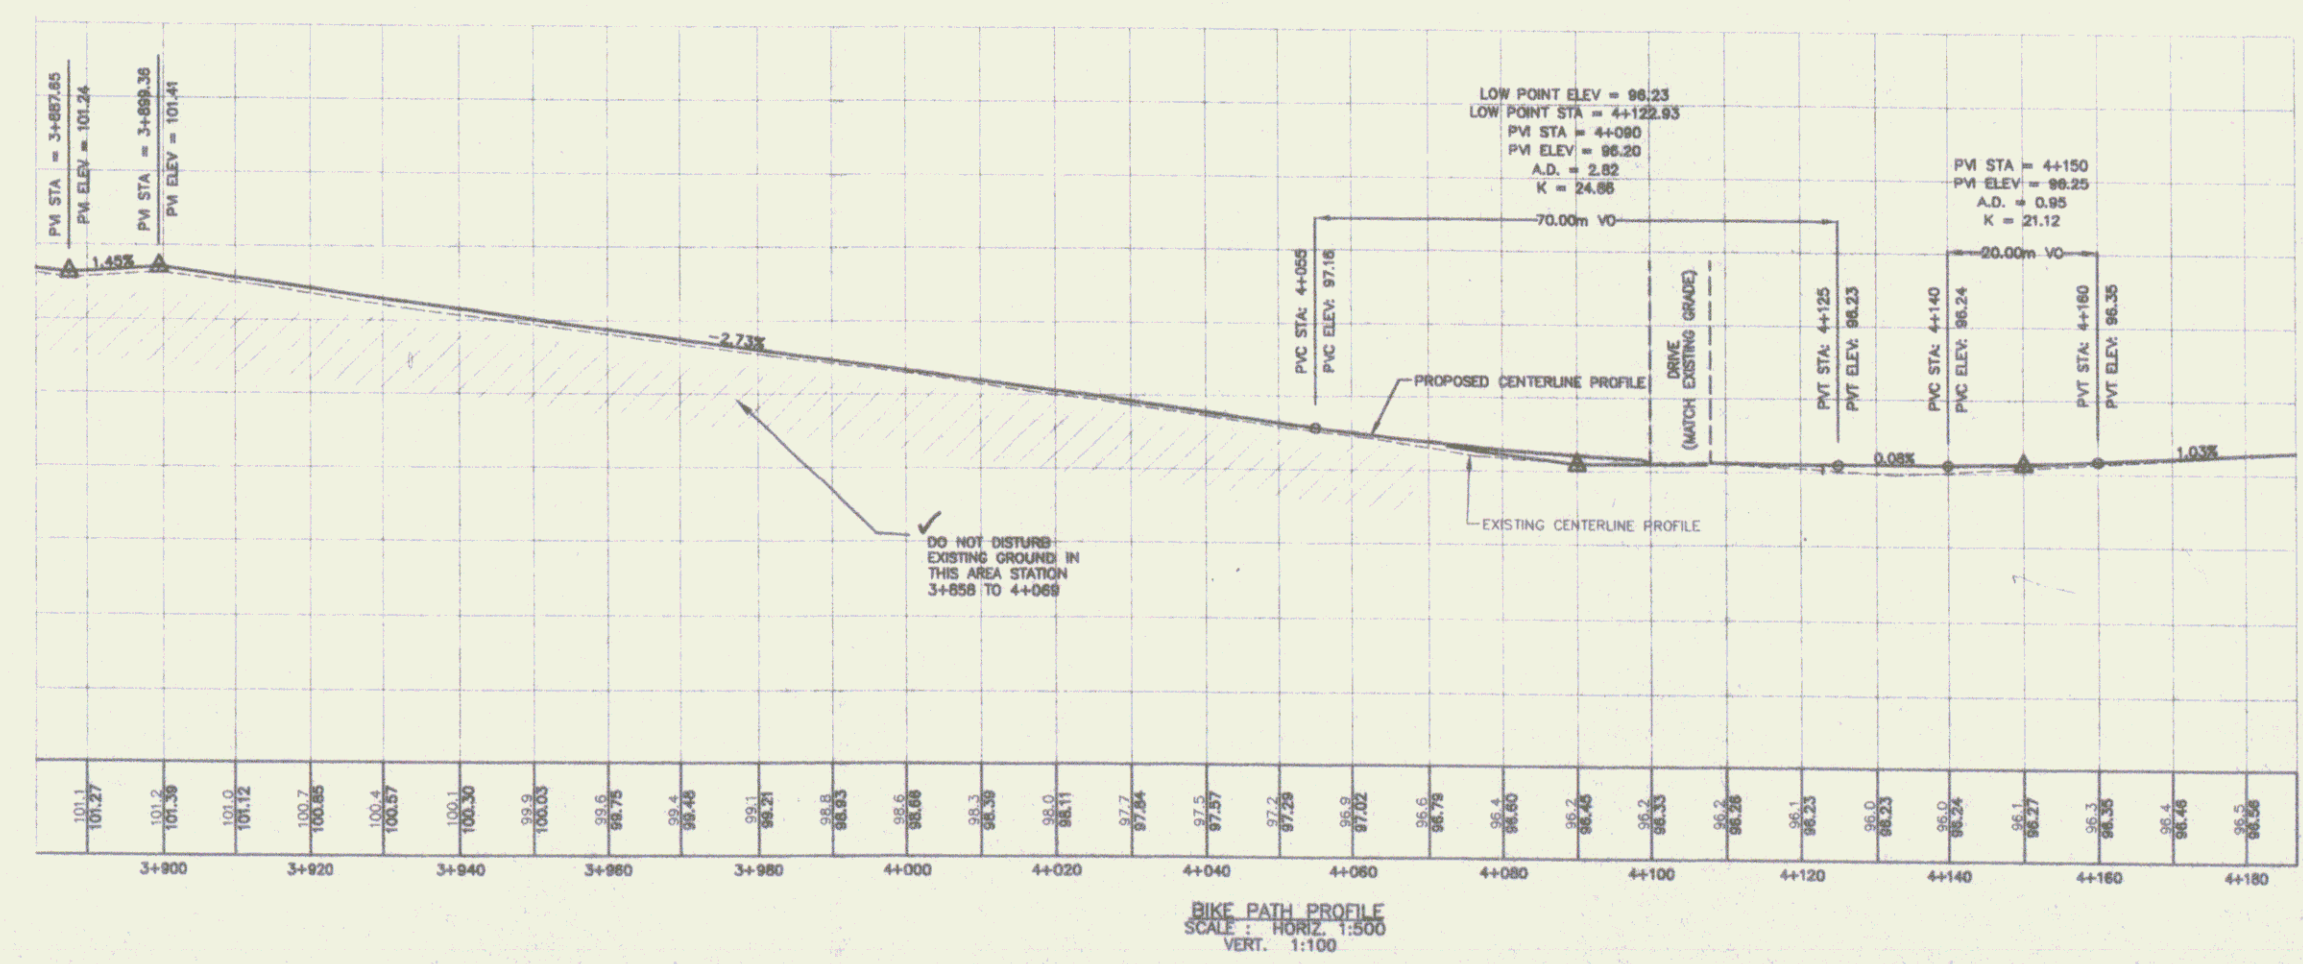

RECORD DRAWINGS

Dubois & King
INCORPORATED
100 Parkside Road, North Ferrisburgh, Vermont 05703
Tel: (802) 882-0200
Fax: (802) 882-0201

NO.	DATE	REVISIONS	BY	CHK
1		REVISED PER REVIEW COMMENTS	AP	DAF
2		REVISED PER REVIEW COMMENTS	AP	DAF



SPRINGFIELD TRANSPORTATION PATH
PHASE 1
TOWN OF SPRINGFIELD
SPRINGFIELD, VERMONT
PLAN AND PROFILE

DESIGNED BY: DATE: 10/1/2010
DRAWN BY: DATE: 10/1/2010
CHECKED BY: DATE: 10/1/2010
SCALE: AS SHOWN
PROJECT NO.: 10000
SHEET NO.: 13

PP11