


SIGN DETAIL W11-1  
NOT TO SCALE  
COLORS FOR W11-1  
LEGEND: BLACK  
BACKGROUND: YELLOW (REFL.)  
FLOURESCENT YELLOW GREEN (FYG)  
BACKGROUND WHERE NOTED ON PLANS  
SIZE  
750mm x 750mm  
AREA  
0.56 m<sup>2</sup>




SIGN DETAIL W8-3  
NOT TO SCALE  
COLORS FOR W8-3  
LEGEND: BLACK  
BACKGROUND: YELLOW (REFL.)  
SIZE  
450mm x 450mm  
AREA  
0.20 m<sup>2</sup>

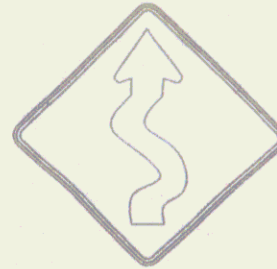

SIGN DETAIL W1-5  
NOT TO SCALE  
COLORS FOR W1-5  
LEGEND: BLACK  
BACKGROUND: YELLOW (REFL.)  
SIZE  
450mm x 450mm  
AREA  
0.20 m<sup>2</sup>



SIGN DETAIL W3-1  
NOT TO SCALE  
COLORS FOR W3-1  
LEGEND: BLACK  
BACKGROUND: YELLOW (REFL.)  
SIZE  
450mm x 450mm  
AREA  
0.20 m<sup>2</sup>

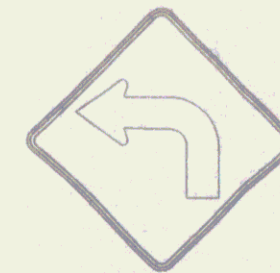


SIGN DETAIL W1-1(L)  
NOT TO SCALE  
COLORS FOR W1-1(L)  
LEGEND: BLACK  
BACKGROUND: YELLOW (REFL.)  
SIZE  
450mm x 450mm  
AREA  
0.20 m<sup>2</sup>

\* SIGN TO BE LOCATED 75 METERS BEFORE PATH CROSSING

Add Sign - "Trailhead Parking"



SIGN DETAIL W16-1  
NOT TO SCALE  
COLORS FOR W16-1  
LEGEND: BLACK  
BACKGROUND: FLOURESCENT YELLOW  
GREEN (FYG)  
SIZE  
600mm x 600mm  
AREA  
0.36 m<sup>2</sup>

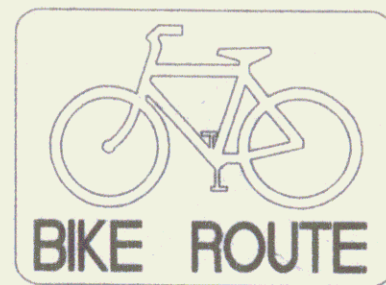

SIGN DETAIL D11-1  
NOT TO SCALE  
COLORS FOR D11-1  
LEGEND: WHITE (REFL.)  
BACKGROUND: GREEN (REFL.)  
SIZE  
600mm x 450mm  
AREA  
0.27 m<sup>2</sup>



SIGN DETAIL D1-1B  
NOT TO SCALE  
COLORS FOR D1-1B  
LEGEND: WHITE (REFL.)  
BACKGROUND: GREEN (REFL.)  
SIZE  
600mm x 150mm  
AREA  
0.09 m<sup>2</sup>




SIGN DETAIL R1-1  
NOT TO SCALE  
COLORS FOR R1-1  
LEGEND: WHITE (REFL.)  
BACKGROUND: RED (REFL.)  
SIZE  
450mm x 450mm  
AREA  
0.20 m<sup>2</sup>




SIGN DETAIL R6-3  
NOT TO SCALE  
COLORS FOR R6-3  
LEGEND: BLACK  
BACKGROUND: WHITE (REFL.)  
SIZE  
600mm x 600mm  
AREA  
0.36 m<sup>2</sup>




TYPE III OBJECT MARKER  
NOT TO SCALE  
COLORS FOR OBJECT MARKER  
LEGEND: BLACK  
BACKGROUND: YELLOW (REFL.)  
SIZE  
150mm x 450mm  
75mm WIDE STRIPES  
AREA  
0.07 m<sup>2</sup>

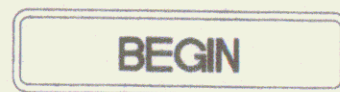


SIGN DETAIL M4-11  
NOT TO SCALE  
COLORS FOR M4-11  
LEGEND: WHITE (REFL.)  
BACKGROUND: GREEN (REFL.)  
SIZE  
600mm x 150mm  
AREA  
0.09 m<sup>2</sup>

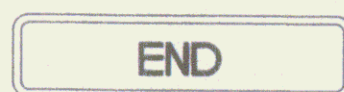


SIGN DETAIL M4-12  
NOT TO SCALE  
COLORS FOR M4-12  
LEGEND: WHITE (REFL.)  
BACKGROUND: GREEN (REFL.)  
SIZE  
600mm x 150mm  
AREA  
0.09 m<sup>2</sup>

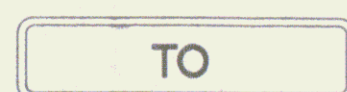


SIGN DETAIL M4-13  
NOT TO SCALE  
COLORS FOR M4-13  
LEGEND: WHITE (REFL.)  
BACKGROUND: GREEN (REFL.)  
SIZE  
600mm x 150mm  
AREA  
0.09 m<sup>2</sup>

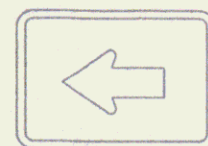

SIGN DETAIL M7-1  
NOT TO SCALE  
COLORS FOR M7-1  
LEGEND: WHITE (REFL.)  
BACKGROUND: GREEN (REFL.)  
SIZE  
300mm x 225mm  
AREA  
0.07 m<sup>2</sup>

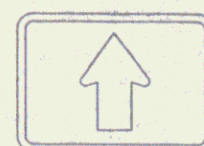

SIGN DETAIL M7-2  
NOT TO SCALE  
COLORS FOR M7-2  
LEGEND: WHITE (REFL.)  
BACKGROUND: GREEN (REFL.)  
SIZE  
300mm x 225mm  
AREA  
0.07 m<sup>2</sup>

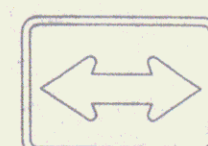

SIGN DETAIL M7-5  
NOT TO SCALE  
COLORS FOR M7-5  
LEGEND: WHITE (REFL.)  
BACKGROUND: GREEN (REFL.)  
SIZE  
300mm x 225mm  
AREA  
0.07 m<sup>2</sup>

NOTES:

1. ALL SIGNS SHALL CONFORM TO THE STANDARDS SET FORTH BY THE "MANUAL OF UNIFORM TRAFFIC CONTROL DEVICES" (MUTCD) CURRENT EDITION. THE CONTRACTOR SHALL ORDER THE DESIGNATED SIGNS ACCORDINGLY.
2. SIGN PLACEMENT SHALL CONFORM TO THE MUTCD OR THE VERMONT AGENCY OF TRANSPORTATION (VAOT) STANDARDS. IN THE CASE OF DISCREPANCY, THE VAOT STANDARDS SHALL GOVERN.
3. ALL SIGNS TO BE MADE FROM FLAT SHEET ALUMINUM.

RECORD DRAWINGS

Dubois & King  
Engineering Planning  
100 Parkside Road, North Ferrisburgh, VT 05703  
Tel: 802-253-3333

NO.	DATE	BY	DESCRIPTION
1	1/1/20	SD	ISSUED FOR BIDDING
2	1/1/20	SD	ISSUED FOR BIDDING



SPRINGFIELD TRANSPORTATION PATH  
PHASE 1  
TOWN OF SPRINGFIELD  
SPRINGFIELD, VERMONT  
TRAFFIC SIGN DETAILS

DESIGNED BY	DATE
CHECKED BY	DATE
FILE NO.	PROJECT NO.
DATE	DATE
PROJECT NO.	PROJECT NO.

SD