



PLAN - (Below Roof)
SCALE: 3/4" = 1'-0"

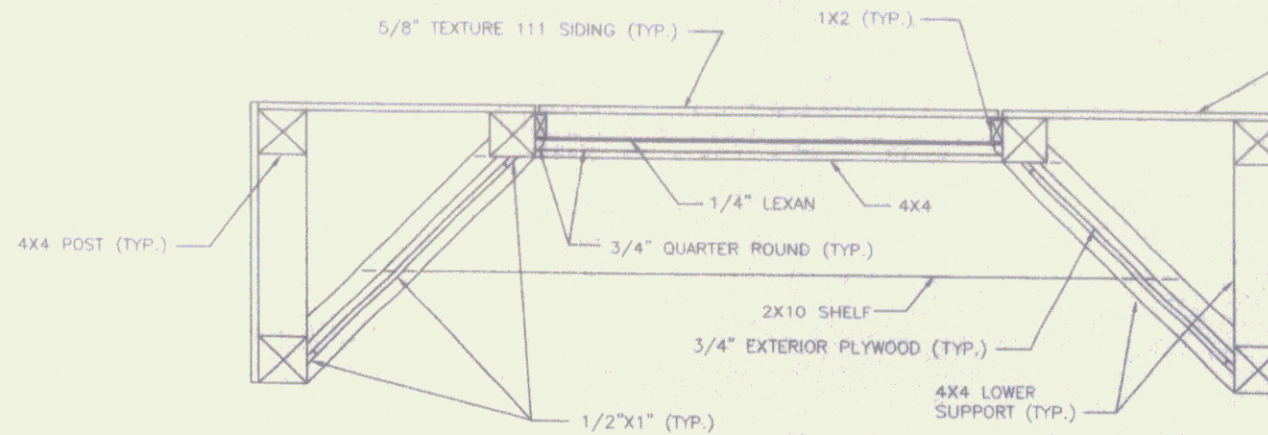


SECTION A-A
SCALE: 1 1/2" = 1'-0"

NOTES:


1. P.T. = PRESSURE TREATED
2. R.O. = ROUGH OPENING
3. INFORMATION ON THIS SHEET HAS BEEN ADOPTED FROM A U.S. DEPARTMENT OF AGRICULTURE SHEET, FILE NO. 7610-157 ENTITLED "REGISTER BULLETIN BOARD".

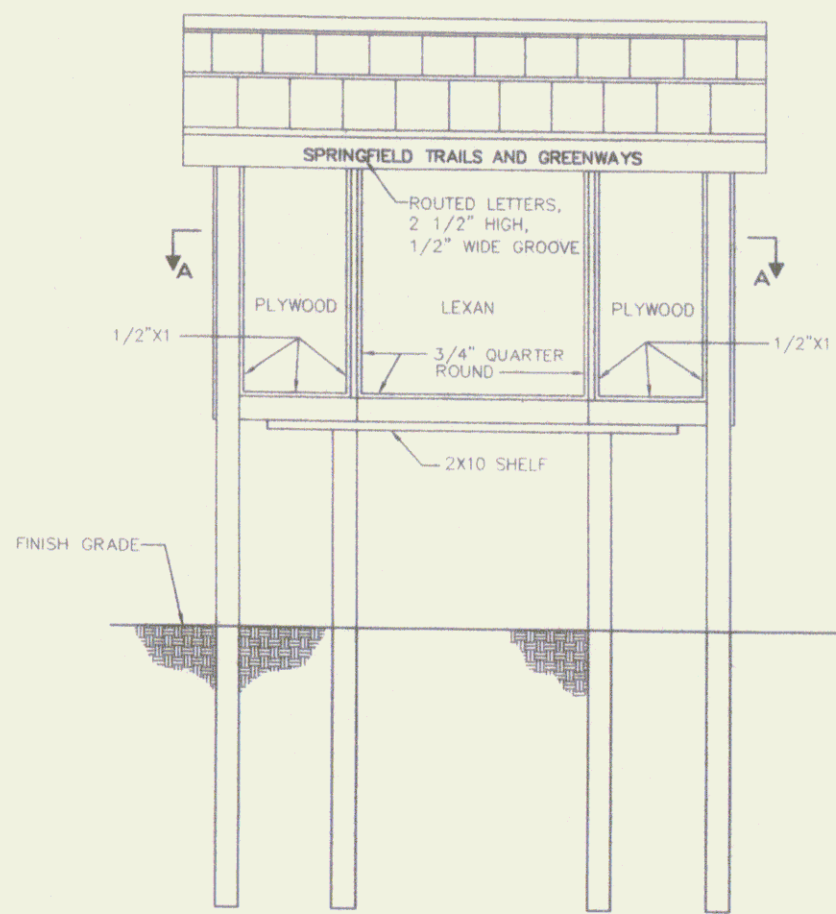


FRONT ELEVATION
SCALE: 3/4" = 1'-0"

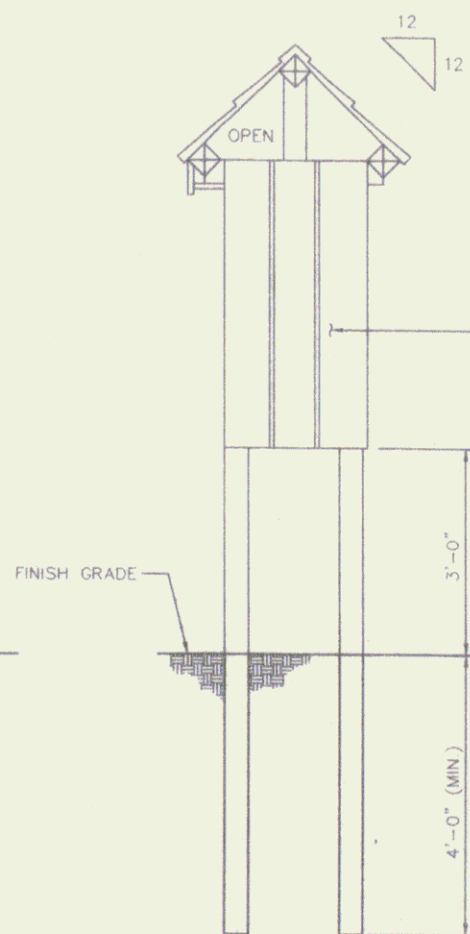

SIDE ELEVATION
SCALE: 3/4" = 1'-0"

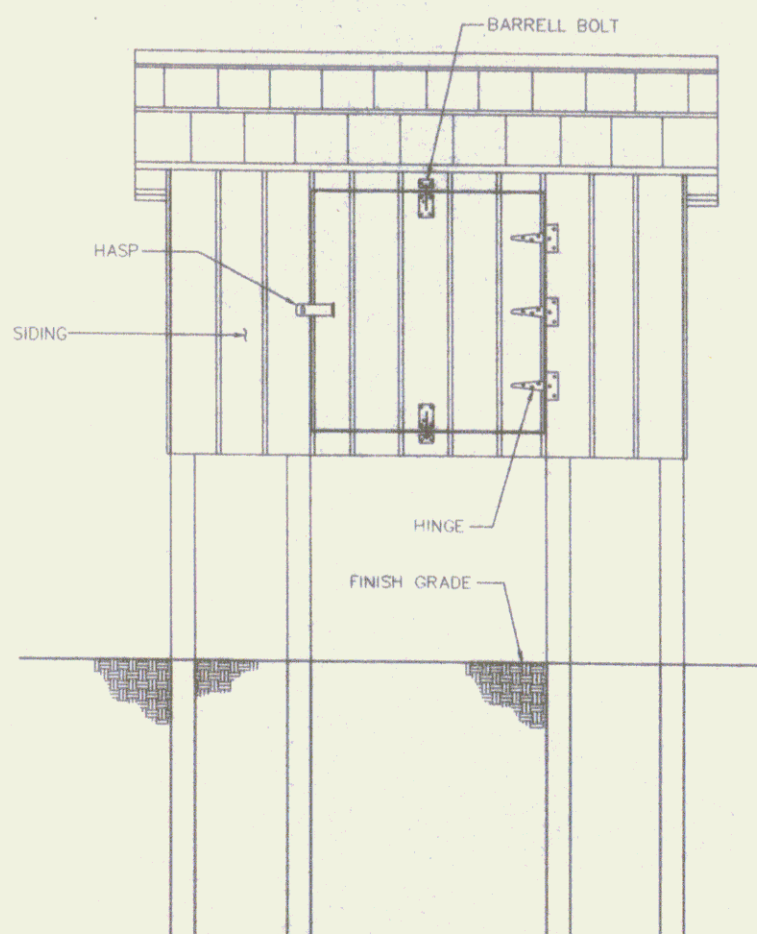

REAR ELEVATION
SCALE: 3/4" = 1'-0"

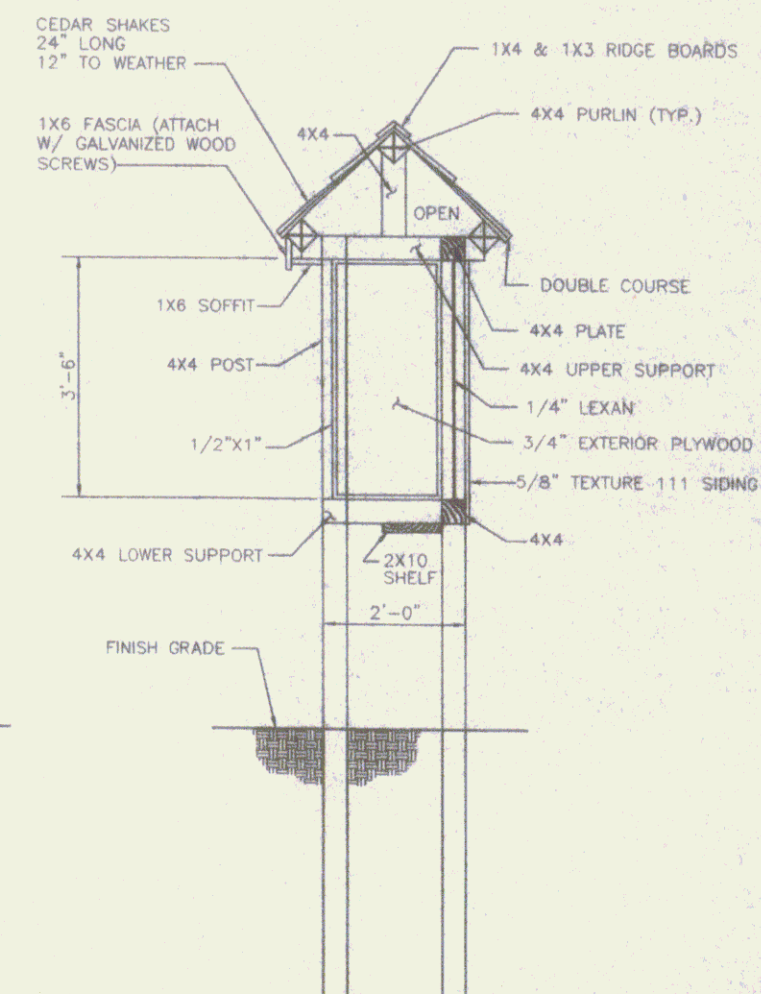

SECTION B-B
SCALE: 3/4" = 1'-0"

BILL OF MATERIALS

| NO. | SIZE | FINISH / DESCRIPTION | USE | NO. | SIZE | FINISH / DESCRIPTION | USE |
|-----|----------|----------------------|-----------------------|-----|---------------------|----------------------|------------------------|
| 6 | 4X4X12' | S4S (P.T.) | POSTS | 1 | 40"X42"X1/4" (R.O.) | LEXAN | BULLETIN BOARD |
| 4 | 4X4X8' | S4S (P.T.) | PURLINS, PLATE (LONG) | 2 | BUNDLES | 24" | HANDSPLIT CEDAR SHAKES |
| 2 | 4X4X12' | S4S (P.T.) | SUPPORTS, PLATES | 16 | LIN. FT. | 3/4" | QUARTER ROUND |
| 1 | 2X10X5' | S4S (P.T.) | SHELF | 24 | LIN. FT. | 1/2"X1" | S4S (WHITE PINE) |
| 1 | 1X6X8' | S4S(WHITE PINE) | FASCIA | 16 | | 3/8"X6" | LAG SCREWS W/ WASHERS |
| 1 | 1X6X8' | S4S (P.T.) | SOFFIT | 2 | LB. BOX | 6P | GALVANIZED NAILS |
| 1 | 1X4X9' | S4S (P.T.) | RIDGE BOARD | 3 | | 5" | T-HINGES |
| 1 | 1X3X9' | S4S (P.T.) | RIDGE BOARD | 1 | | 3 1/4" | SAFETY HASP |
| 2 | 1X2X8' | S4S (P.T.) | BULLETIN BOARD | 2 | | 3" | BARRELL BOLTS |
| 2 | 4X9X5/8" | TEXTURE 111 | BULLETIN BOARD | | | | |
| 1 | 4X8X3/4" | EXTERIOR PLYWOOD | BULLETIN BOARDS | | | | |

*N. I. C.
Constructed by
Crown Point Builders
Set by J. P. Sicard Inc.*

NOTE:
ALL DIMENSIONS SHOWN ON THIS PLAN ARE IMPERIAL.

RECORD DRAWINGS

Springfield Transportation Path Phase 1
 Town of Springfield
 Springfield, Vermont
 Kiosk Details

SHEET 22