


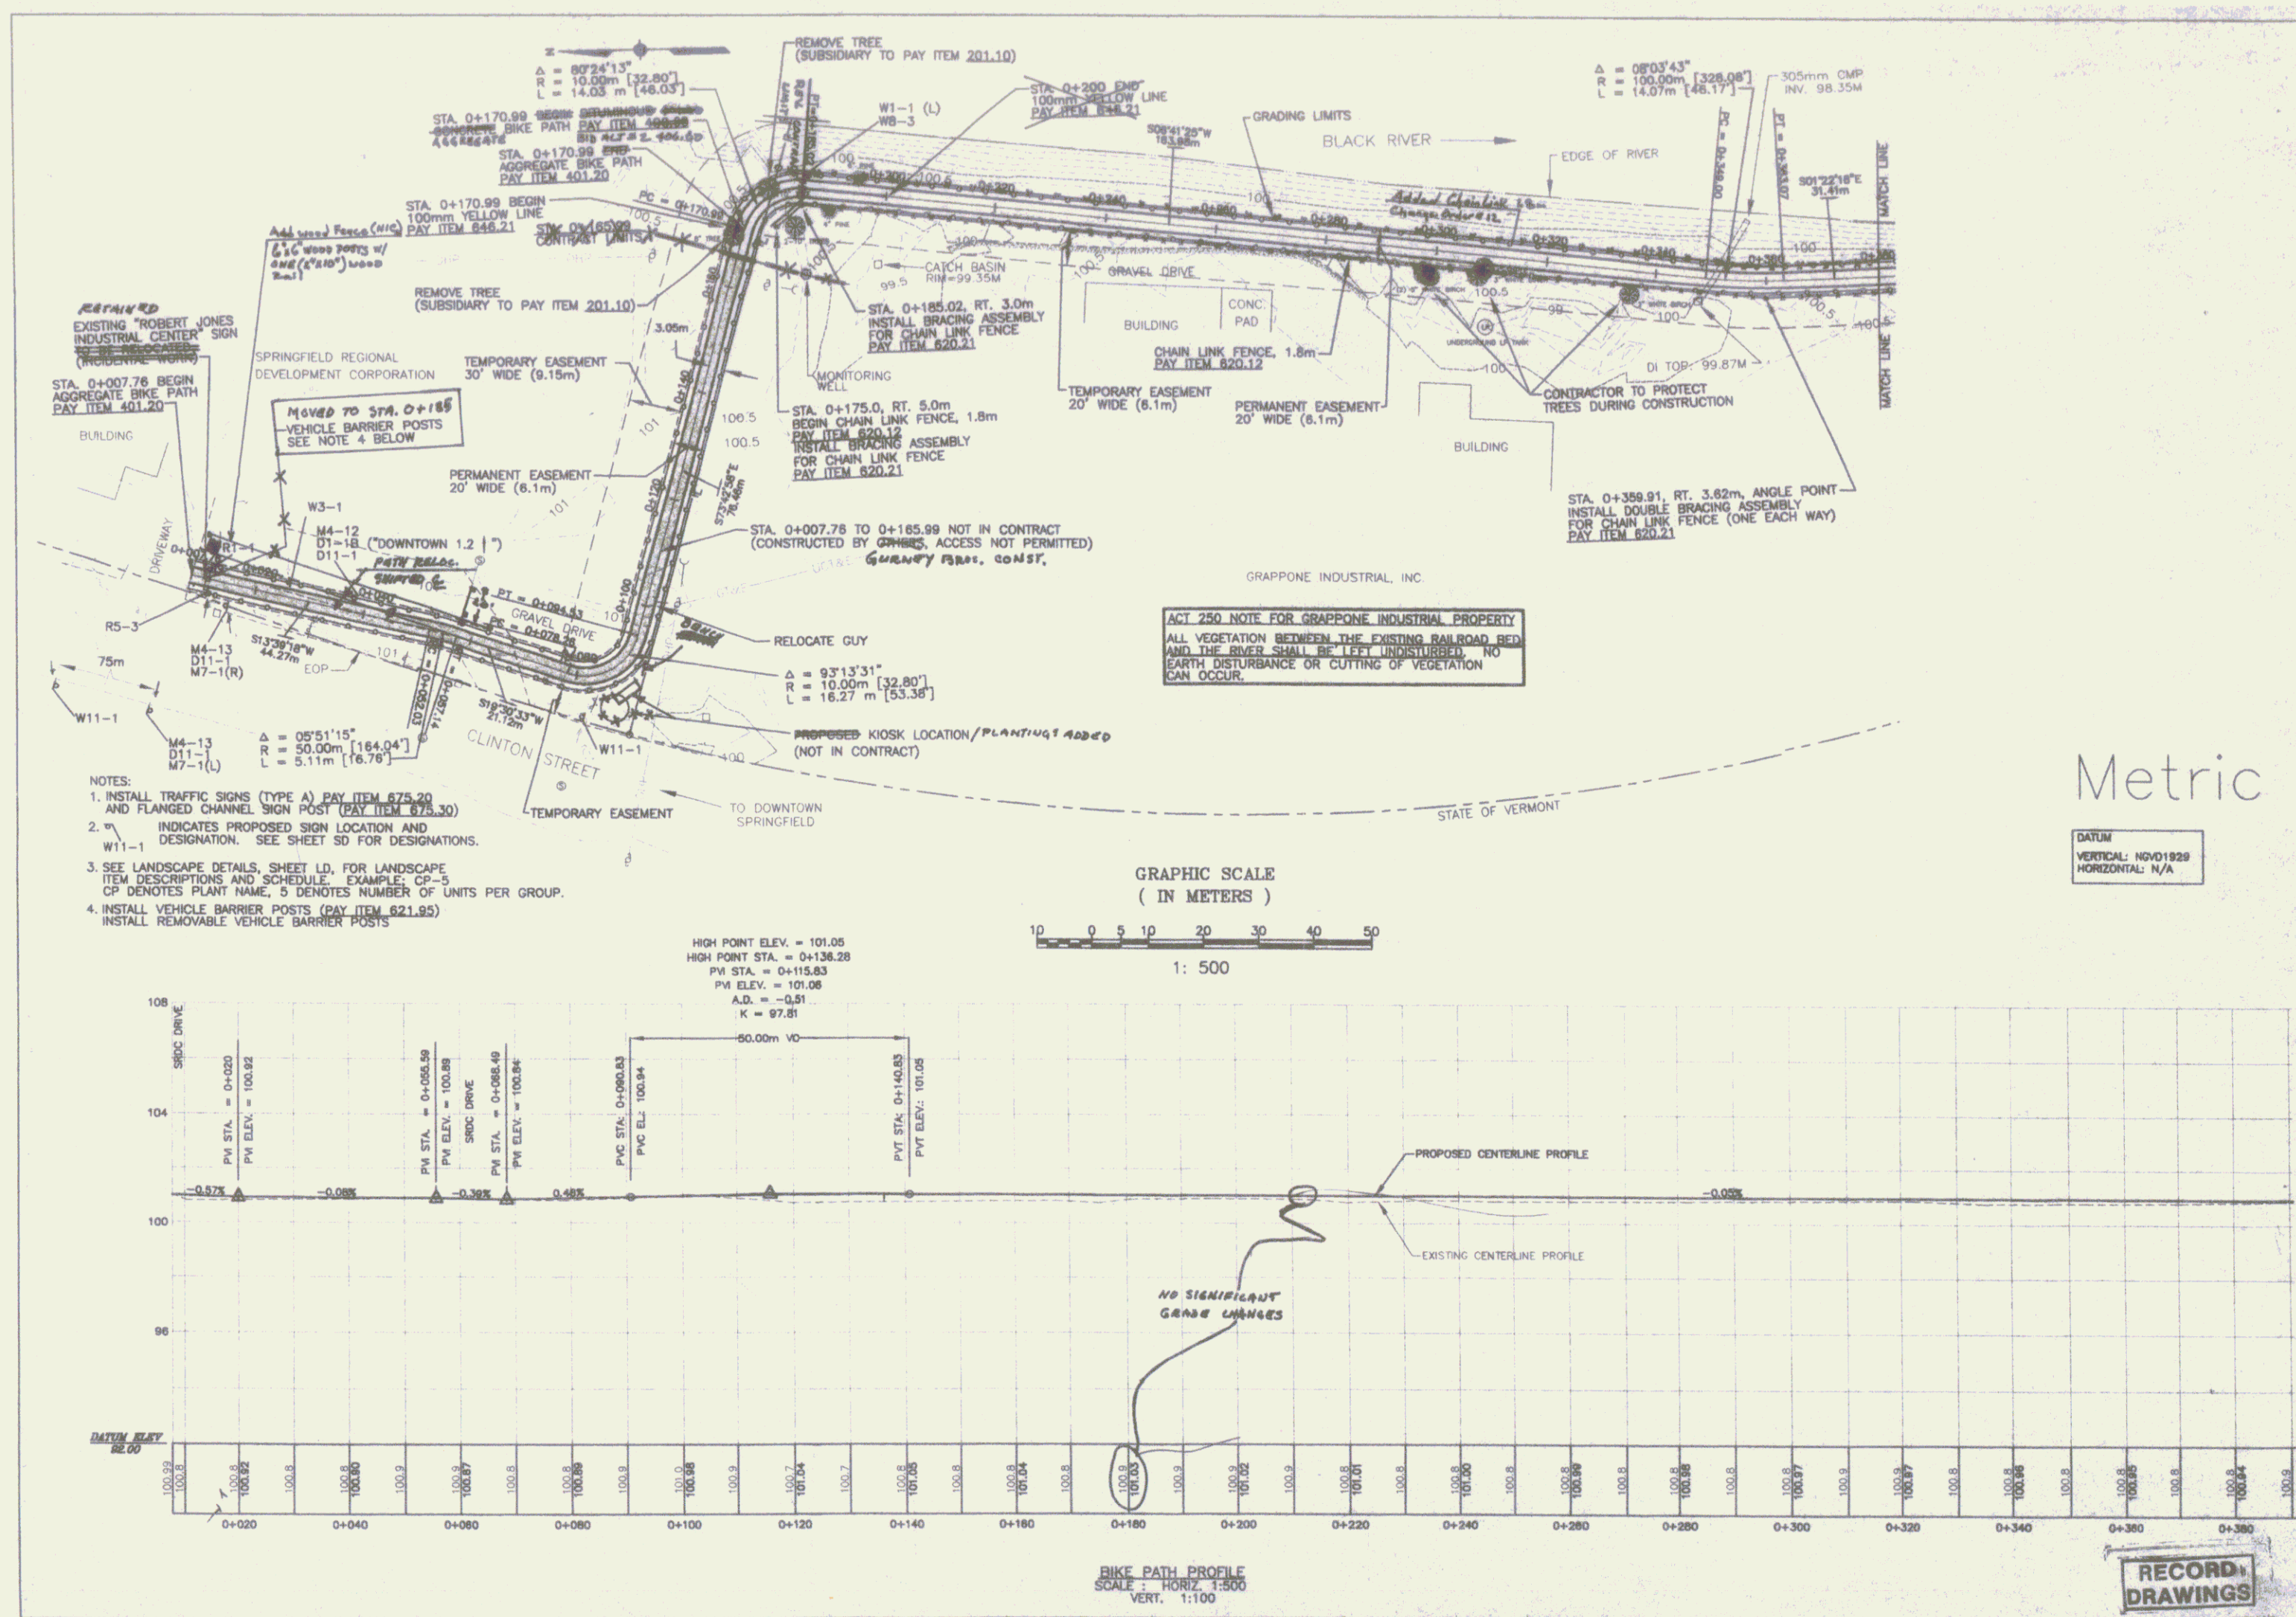

- NOTES:
1. INSTALL TRAFFIC SIGNS (TYPE A) PAY ITEM 675.20 AND FLANGED CHANNEL SIGN POST (PAY ITEM 675.30)
 2. W11-1 INDICATES PROPOSED SIGN LOCATION AND DESIGNATION. SEE SHEET 50 FOR DESIGNATIONS.
 3. SEE LANDSCAPE DETAILS, SHEET LD, FOR LANDSCAPE ITEM DESCRIPTIONS AND SCHEDULE. EXAMPLE: CP-5 CP DENOTES PLANT NAME, 5 DENOTES NUMBER OF UNITS PER GROUP.
 4. INSTALL VEHICLE BARRIER POSTS (PAY ITEM 621.95) INSTALL REMOVABLE VEHICLE BARRIER POSTS

ACT 250 NOTE FOR GRAPPONE INDUSTRIAL PROPERTY
ALL VEGETATION BETWEEN THE EXISTING RAILROAD BED AND THE RIVER SHALL BE LEFT UNDISTURBED. NO EARTH DISTURBANCE OR CUTTING OF VEGETATION CAN OCCUR.

Metric
DATUM
VERTICAL: NGVD1929
HORIZONTAL: N/A

RECORD DRAWINGS

SPRINGFIELD TRANSPORTATION PATH
PHASE 1
TOWN OF SPRINGFIELD
SPRINGFIELD, VERMONT
PLAN AND PROFILE

NO.	DATE	BY	CHKD.	APP'D.
1	11/14/23	DAVID SKLAR		
2	11/14/23	DAVID SKLAR		
3	11/14/23	DAVID SKLAR		

PP1