


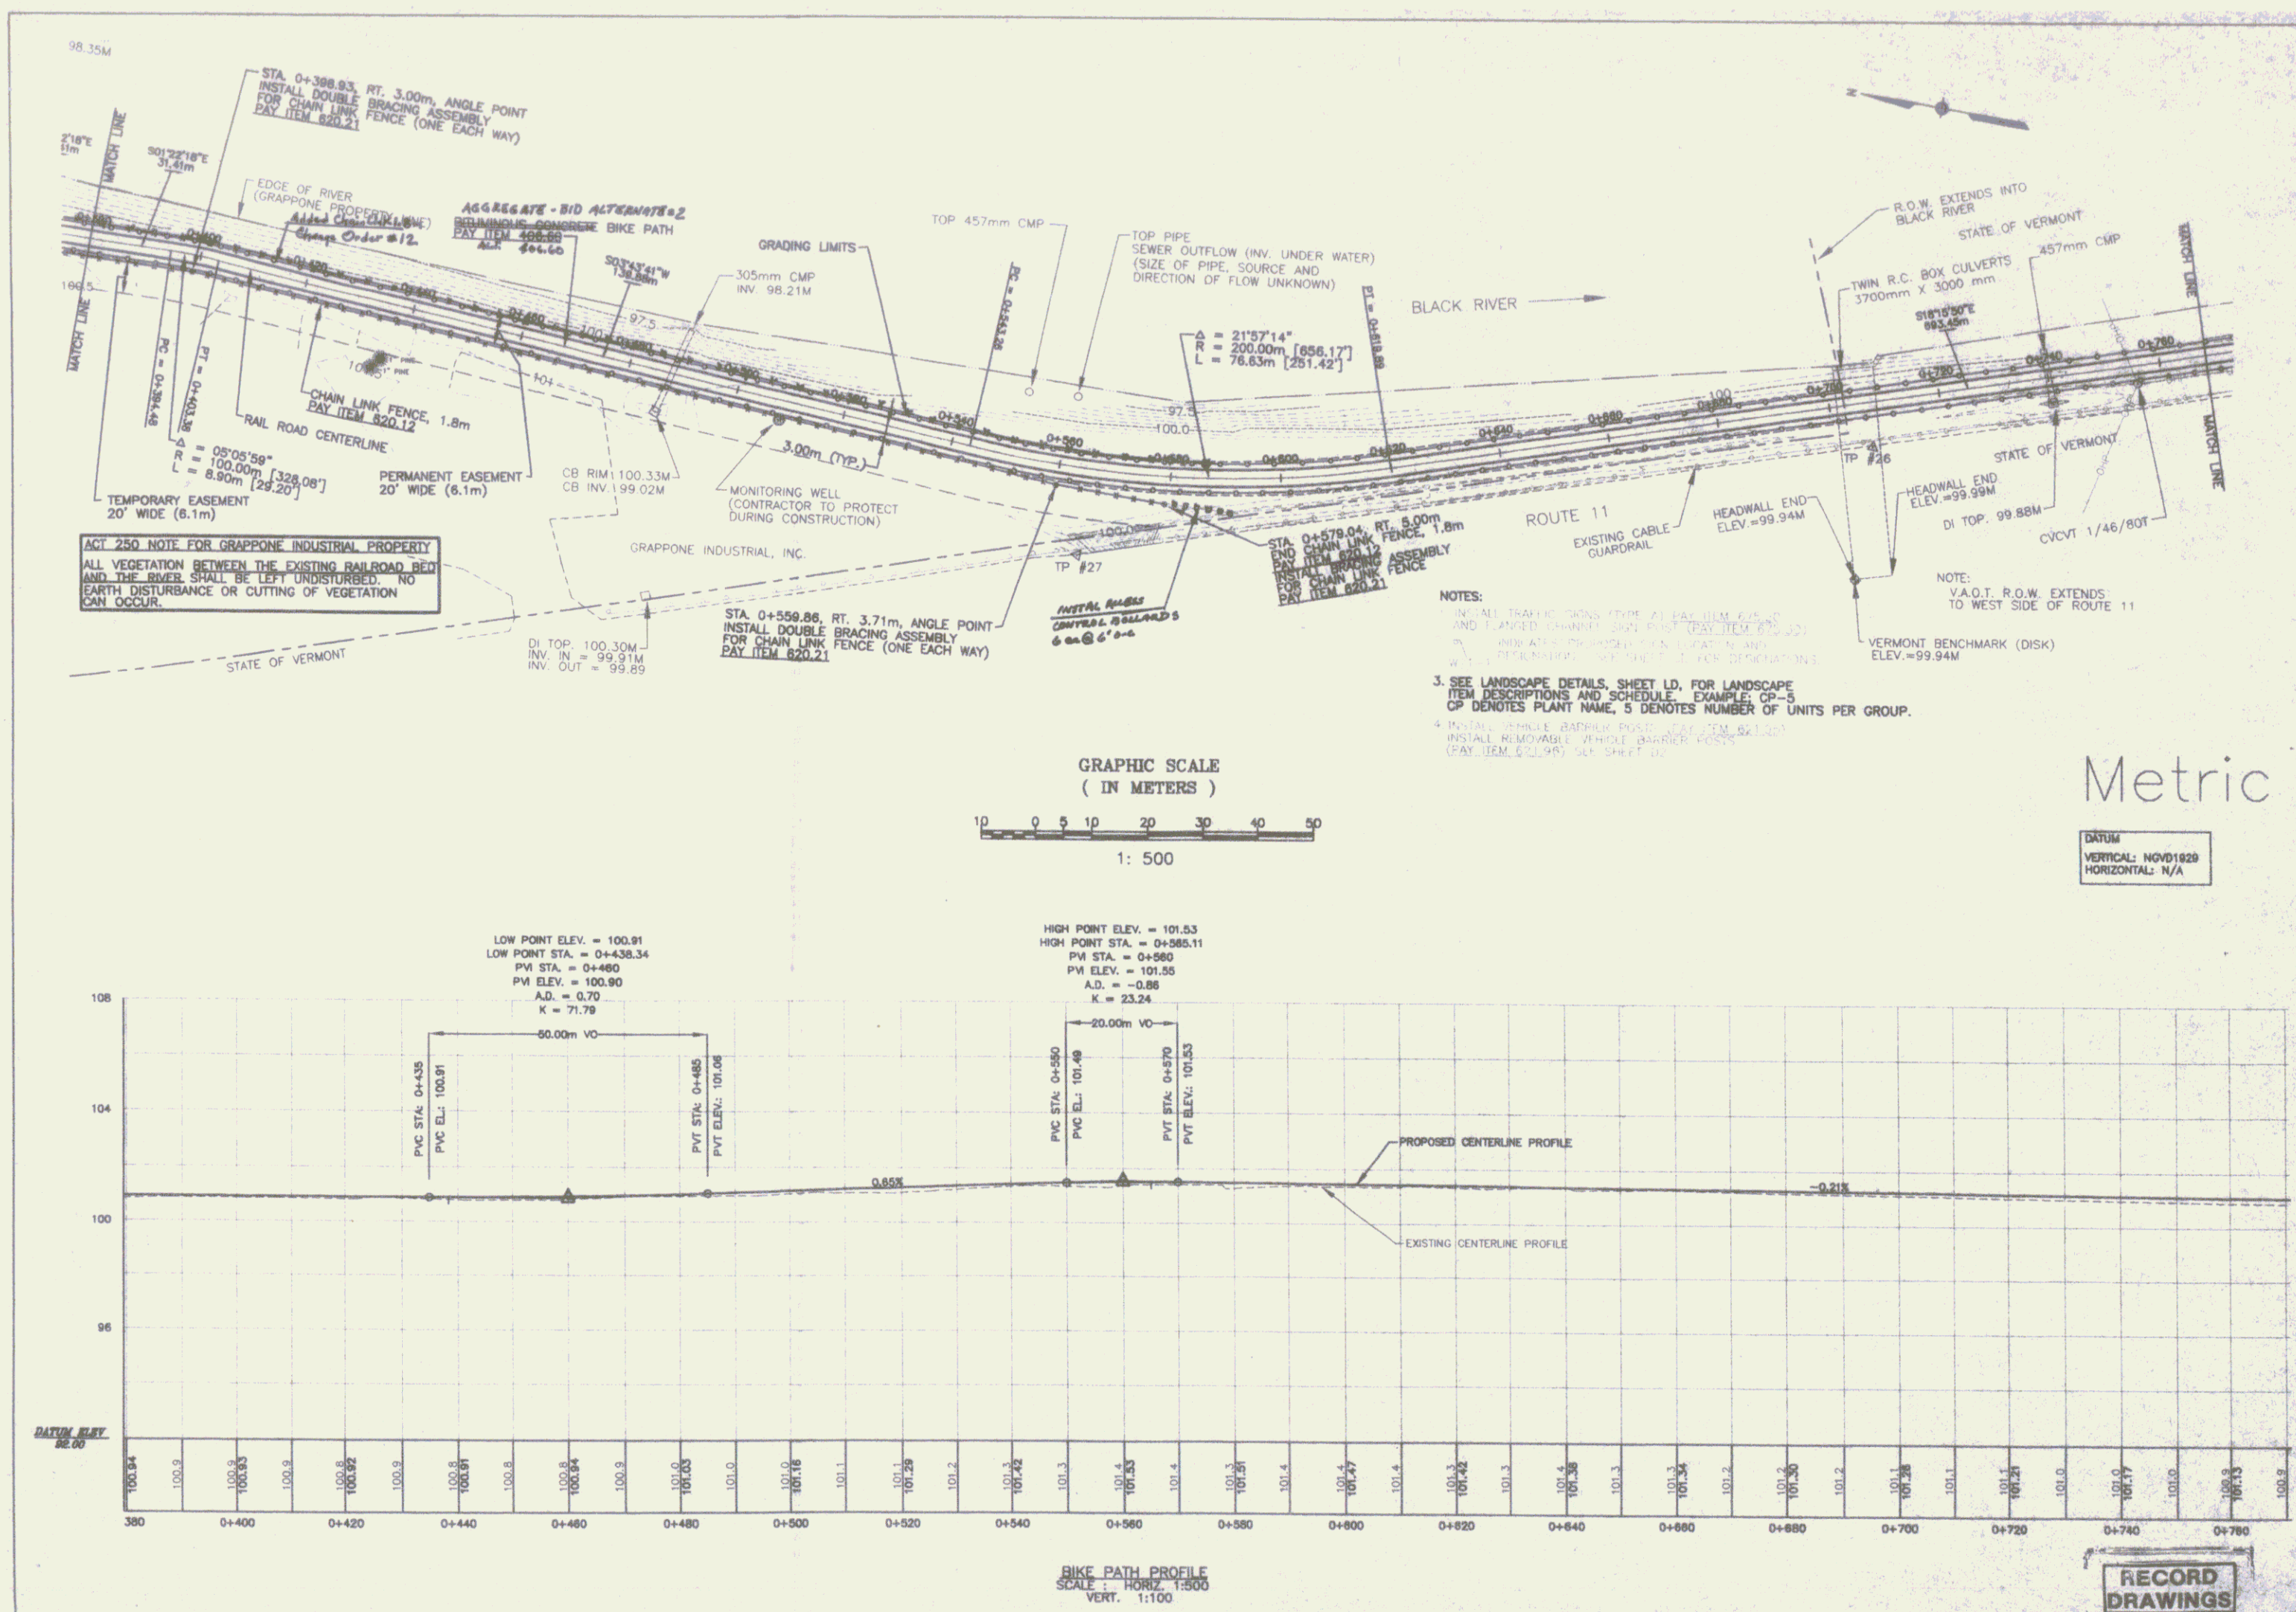

Metric

DATUM
VERTICAL: NGVD1929
HORIZONTAL: N/A

SPRINGFIELD TRANSPORTATION PATH
PHASE 1
TOWN OF SPRINGFIELD
SPRINGFIELD, VERMONT
PLAN AND PROFILE

RECEIVED BY	DATE
ONE	10-1-97
RECEIVED BY	DATE
ONE	10-1-97
RECEIVED BY	DATE
ONE	10-1-97
FILE	ONE
RECEIVED BY	DATE
ONE	10-1-97
WORLD	IN WORLD

METRIC
PROJECT NUMBER
PP2

PP2

SHEET 4

4