


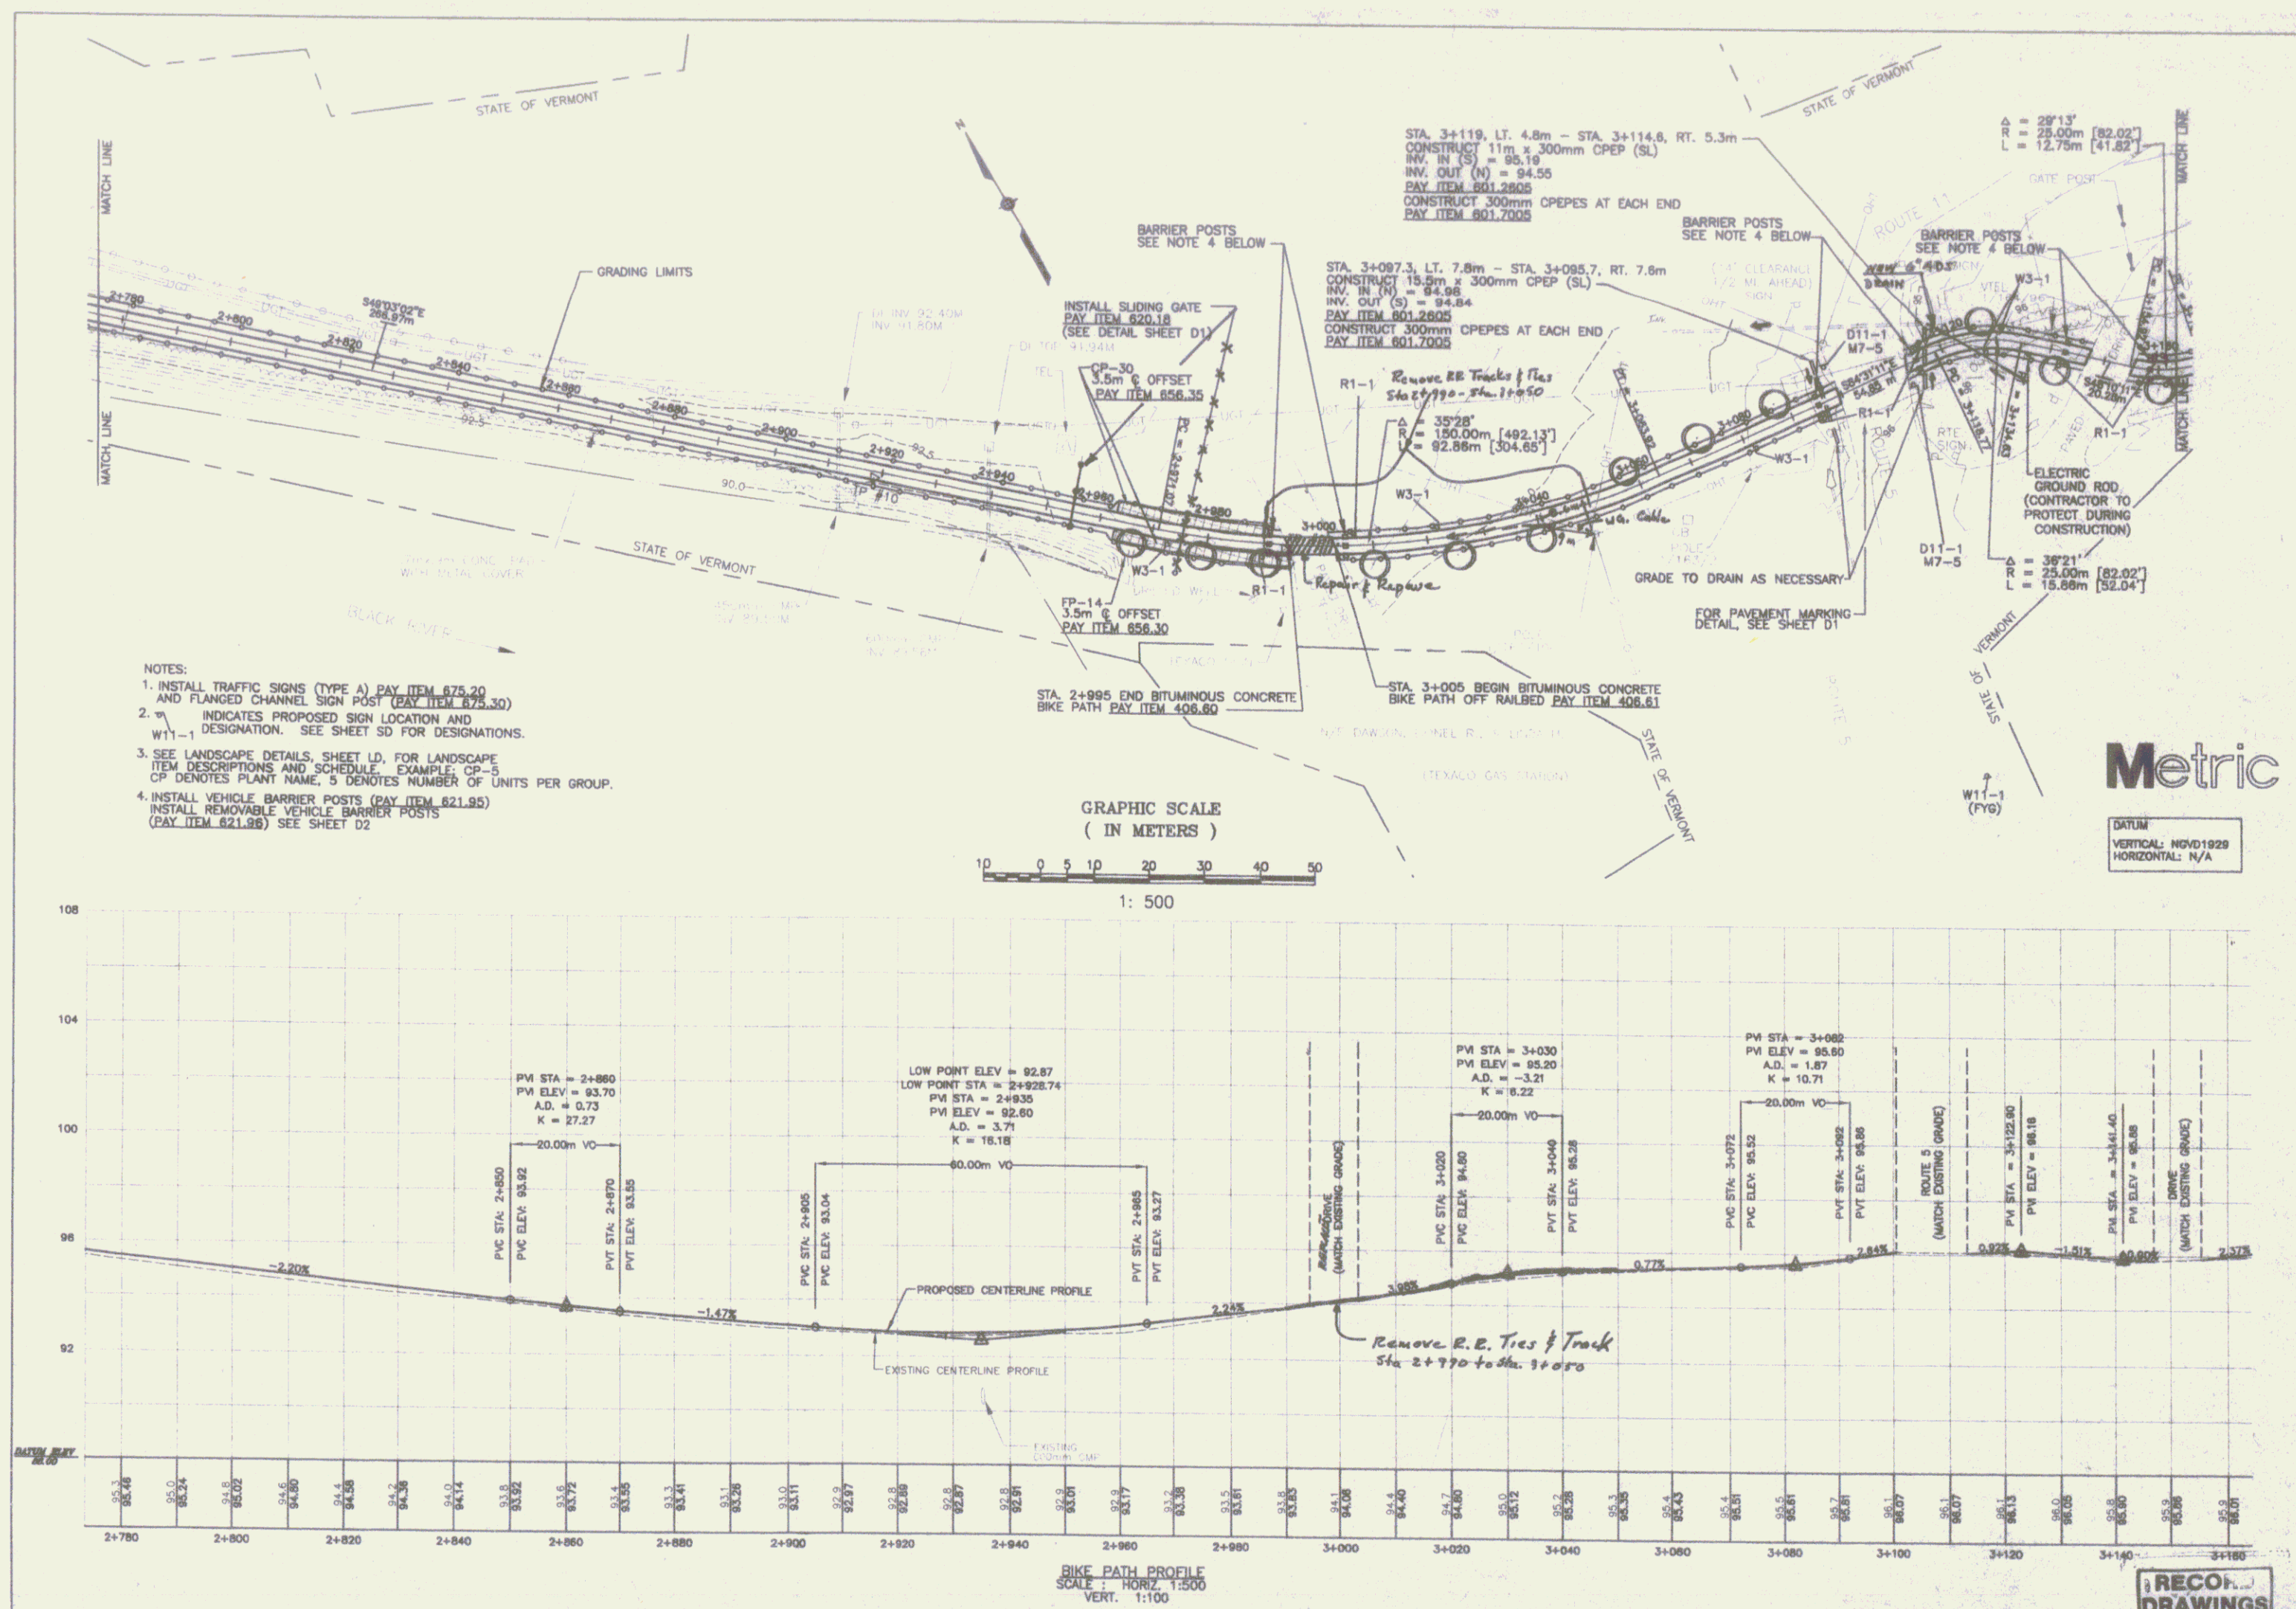

SPRINGFIELD TRANSPORTATION PATH

PHASE 1

TOWN OF SPRINGFIELD

SPRINGFIELD, VERMONT

PLAN AND PROFILE

RECORD DRAWINGS

PP8

SHEET 10

10