


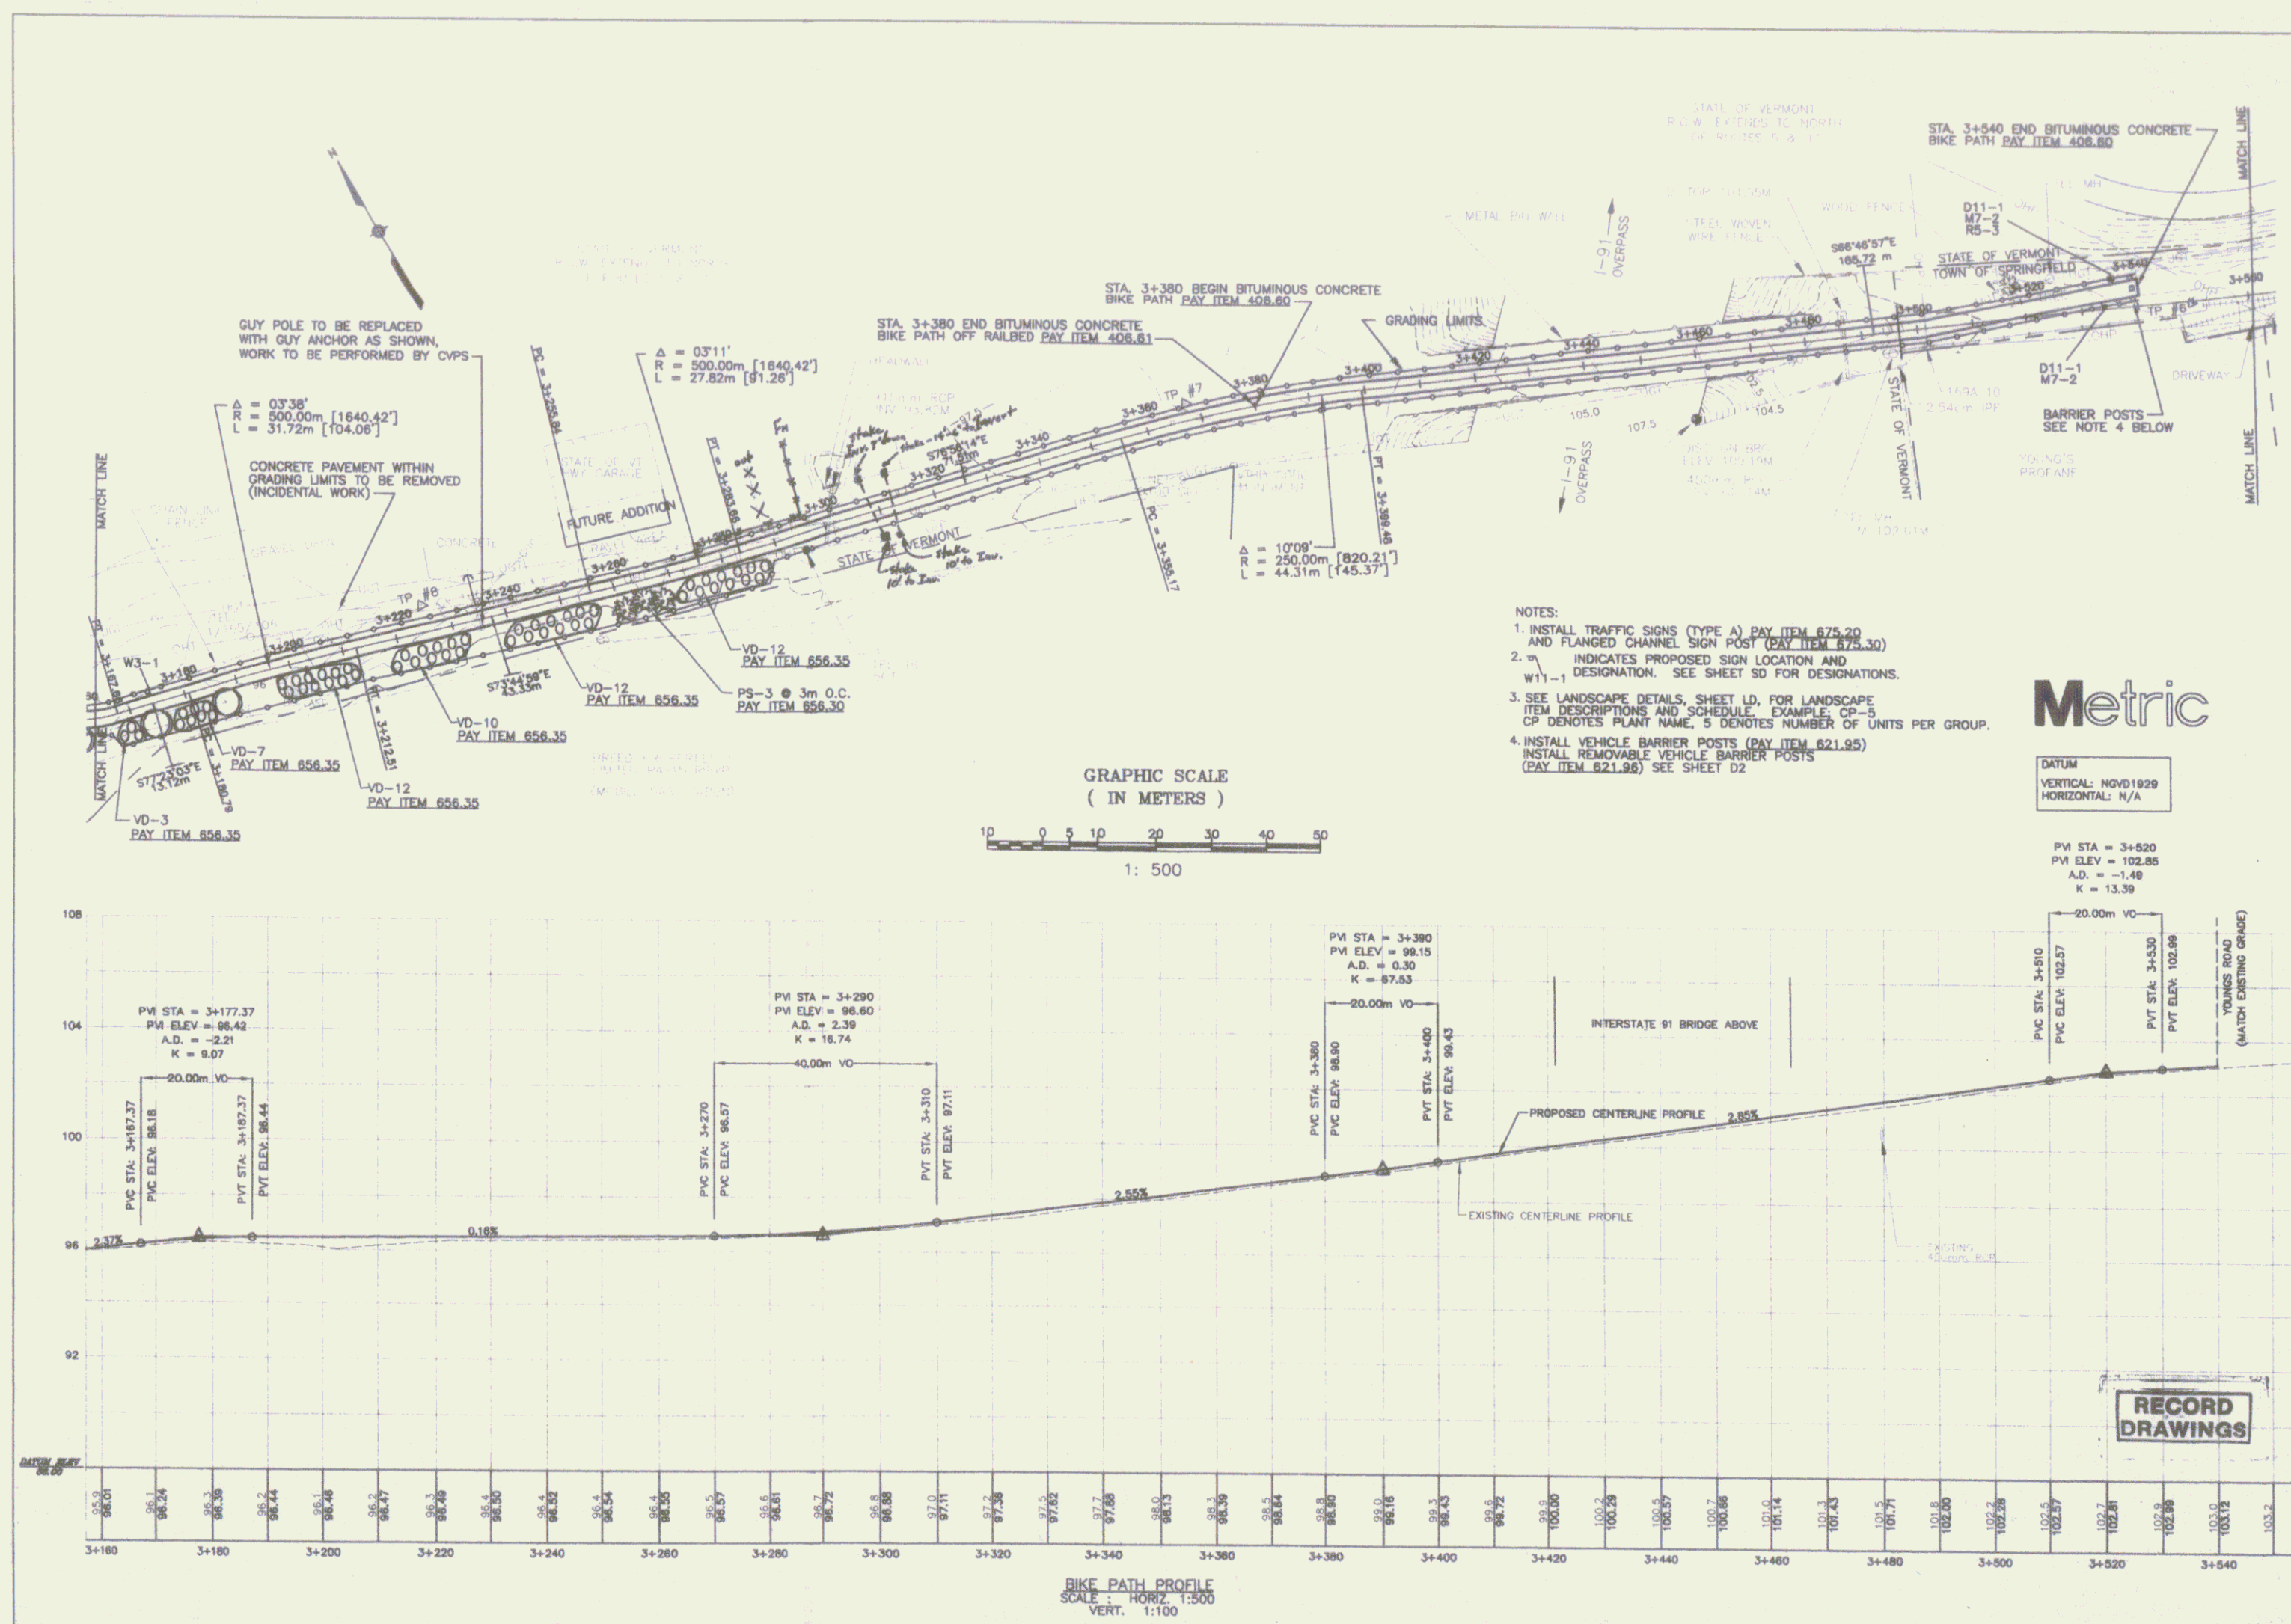

- NOTES:
1. INSTALL TRAFFIC SIGNS (TYPE A) PAY ITEM 675.20 AND FLANGED CHANNEL SIGN POST (PAY ITEM 675.30)
 2. W1 INDICATES PROPOSED SIGN LOCATION AND W1-1 DESIGNATION. SEE SHEET 50 FOR DESIGNATIONS.
 3. SEE LANDSCAPE DETAILS, SHEET LD, FOR LANDSCAPE ITEM DESCRIPTIONS AND SCHEDULE. EXAMPLE: CP-5 CP DENOTES PLANT NAME, 5 DENOTES NUMBER OF UNITS PER GROUP.
 4. INSTALL VEHICLE BARRIER POSTS (PAY ITEM 621.95) INSTALL REMOVABLE VEHICLE BARRIER POSTS (PAY ITEM 621.96) SEE SHEET D2

Metric

DATUM
VERTICAL: NGVD1929
HORIZONTAL: N/A

PVI STA = 3+520
PVI ELEV = 102.85
A.D. = -1.46
K = 13.39

engineering planning design

NO.	DATE	REVISIONS	BY	CHKD
1	3/09	REVISED PER REVIEW COMMENTS	J.P.	D.F.
2	6/09	REVISED PER REVIEW COMMENTS	J.P.	D.F.

SPRINGFIELD TRANSPORTATION PATH
PHASE 1
TOWN OF SPRINGFIELD,
SPRINGFIELD, VERMONT
PLAN AND PROFILE

REVISIONS

NO.	DATE	REVISIONS
1	3/09	REVISED PER REVIEW COMMENTS
2	6/09	REVISED PER REVIEW COMMENTS

PP9

SHEET 11