

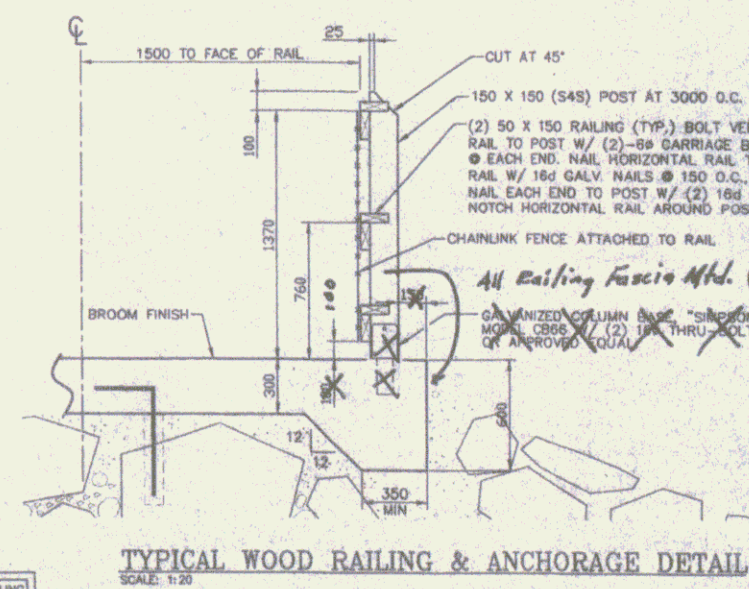
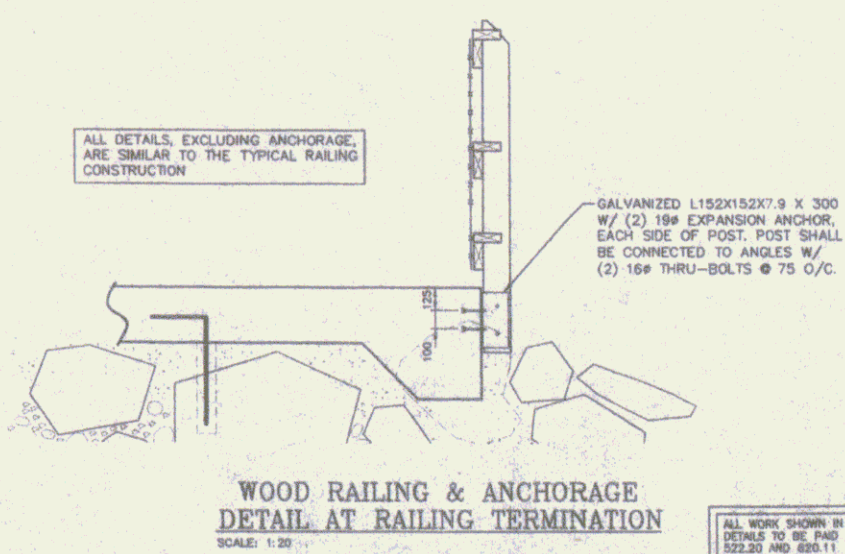
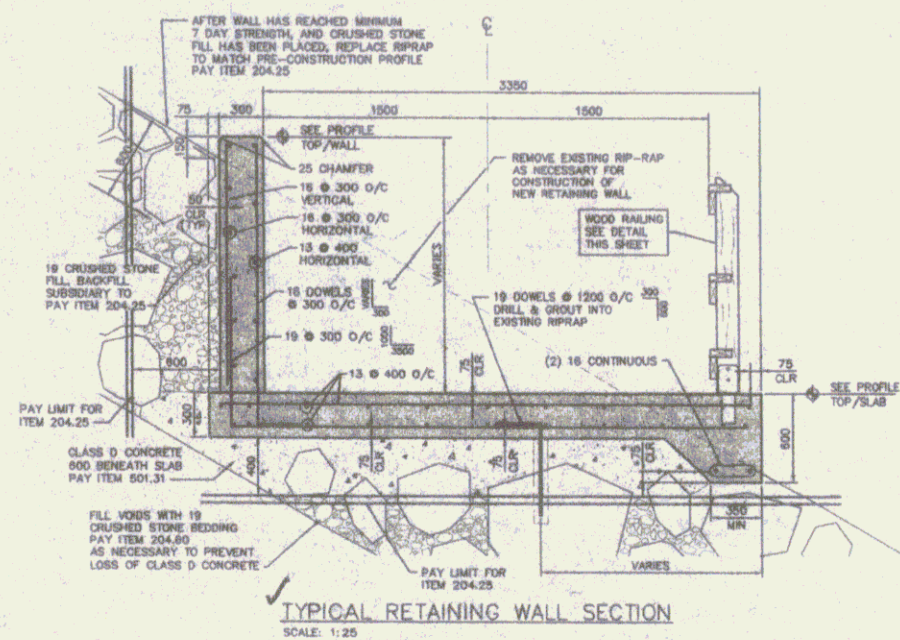
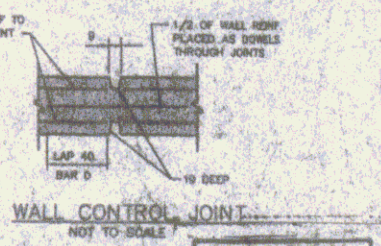
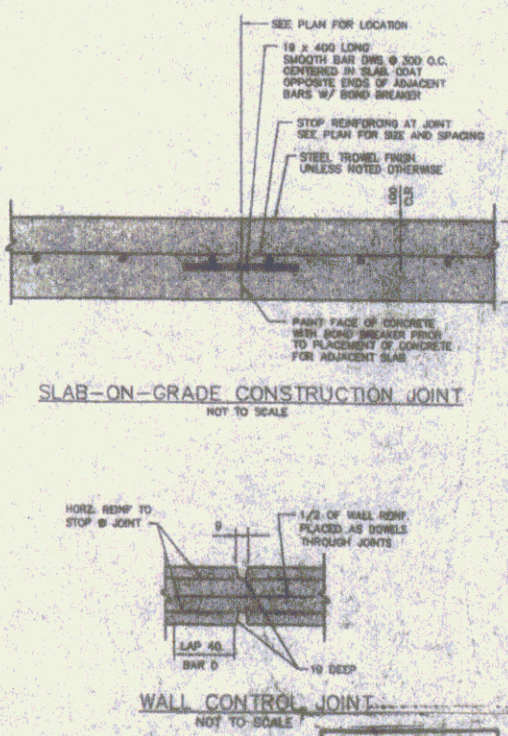
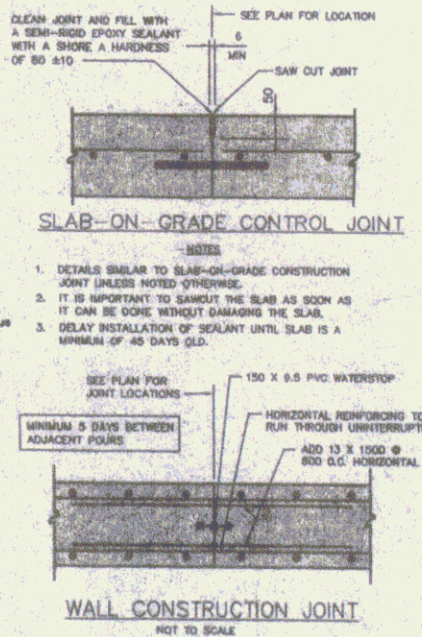


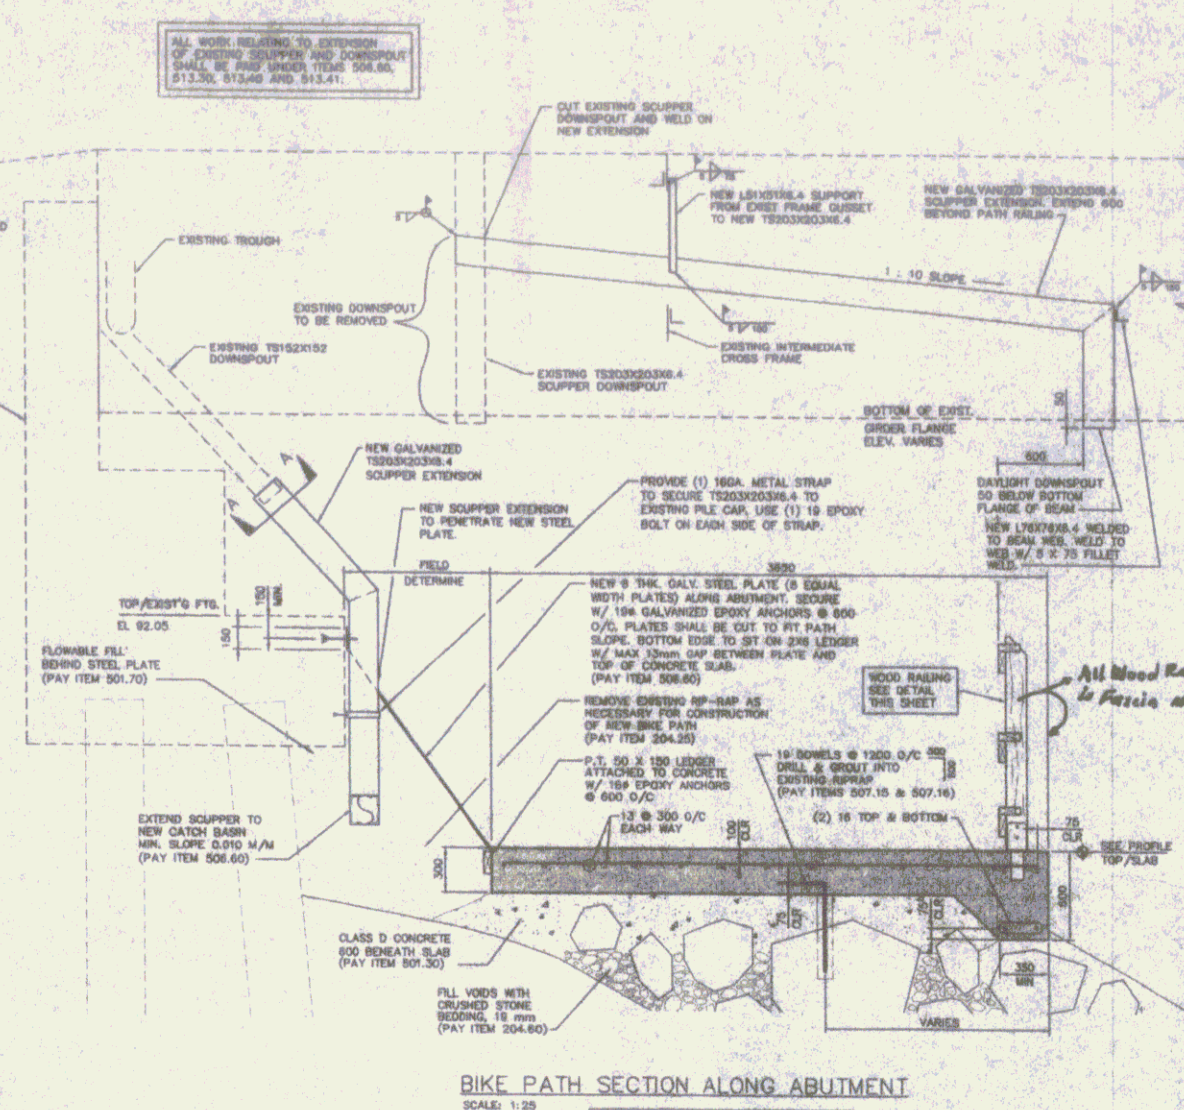

SECTION A-A
SCALE: 1:25

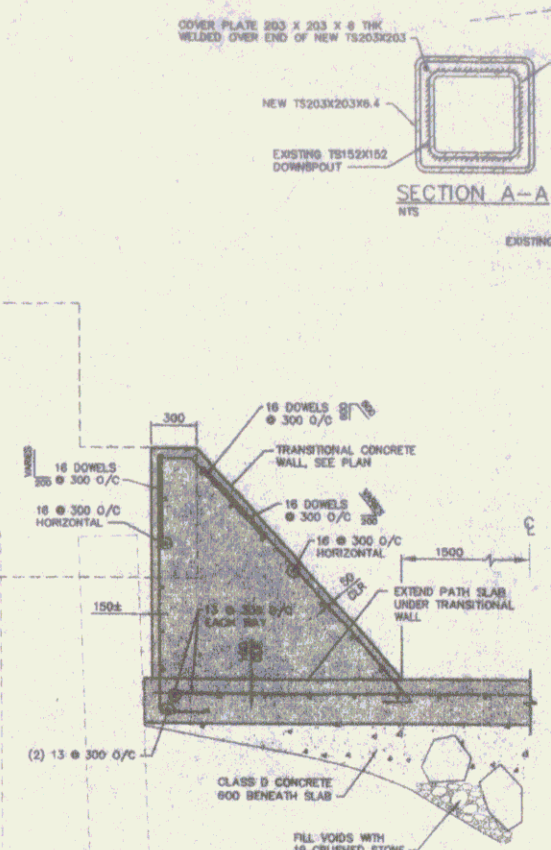

SPRINGFIELD TRANSPORTATION PATH
PHASE 1
TOWN OF SPRINGFIELD
SPRINGFIELD, VERMONT

RETAINING WALL SECTIONS & DETAILS

RECORD DRAWINGS
RW-2

SHEET 15