
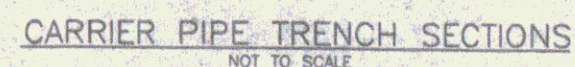


- NOTES:** 1. SEGMENTAL WALL SYSTEM (SWS) SHALL BE CONSTRUCTED TO THE LINES AND GRADES DESIGNATED ON THESE DRAWINGS. CONTRACTOR SHALL SUBMIT DESIGN, LATEST EDITION OF MANUFACTURER'S SPECIFICATIONS, METHOD OF INSTALLATION, AND LIST OF MATERIALS PROPOSED FOR USE, TO BE APPROVED BY THE ENGINEER. ACCEPTABLE SWS MANUFACTURERS ARE KEYSTONE, VERSA-LOK, ANCHOR WALL SYSTEMS, OR APPROVED EQUAL.
2. SEE SHEET PP-10 FOR ADDITIONAL INFORMATION REGARDING TRAILHEAD PARKING AREA PLAN.

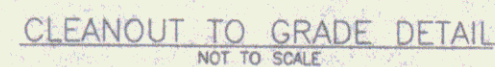

**RECORD
DRAWINGS**

SPRINGFIELD TRANSPORTATION PATH
PHASE 1
TOWN OF SPRINGFIELD
SPRINGFIELD, VERMONT
STRAIGHTHEAD PARKING AREA RETAINING WALL

RW-3