




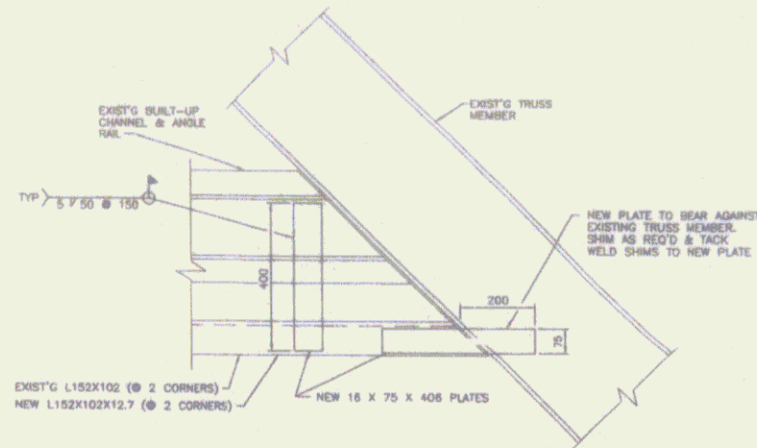


DETAIL
SCALE: 1:10
RW-4

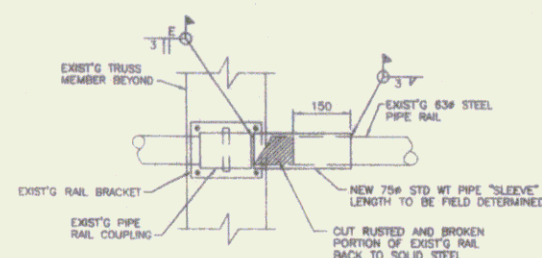


DETAIL
SCALE: 1:10
RW-4

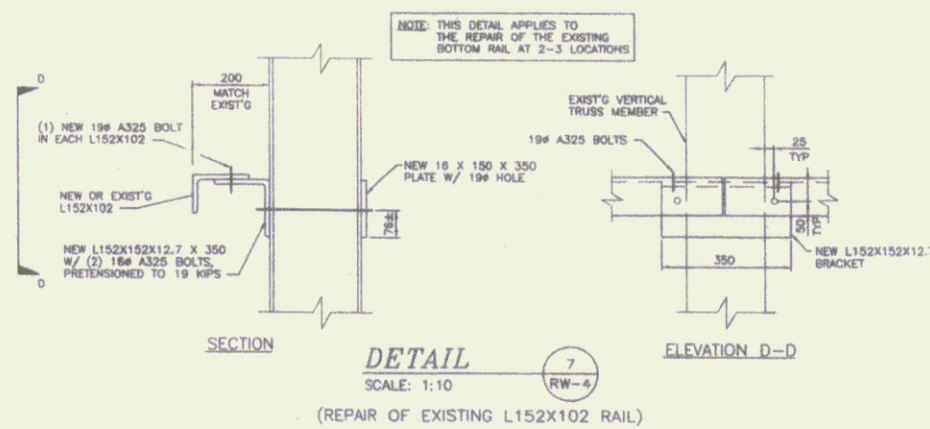


DETAIL
SCALE: 1:10
RW-4

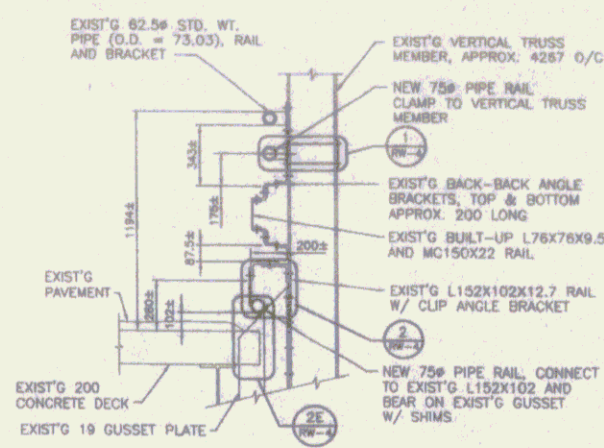


SECTION
SCALE: 1:20
RW-4

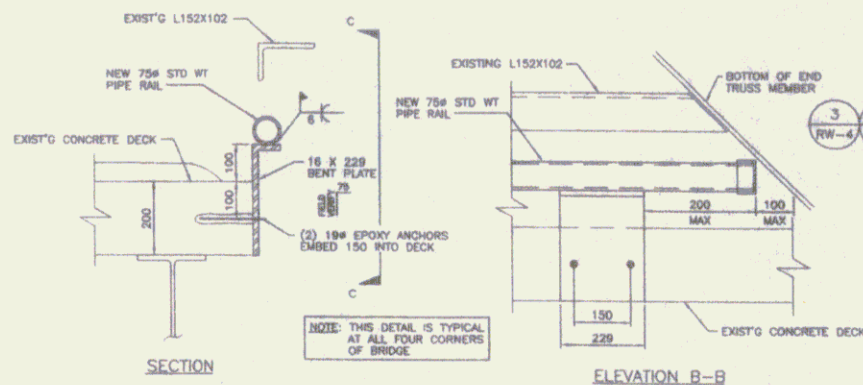


DETAIL
SCALE: 1:10
RW-4

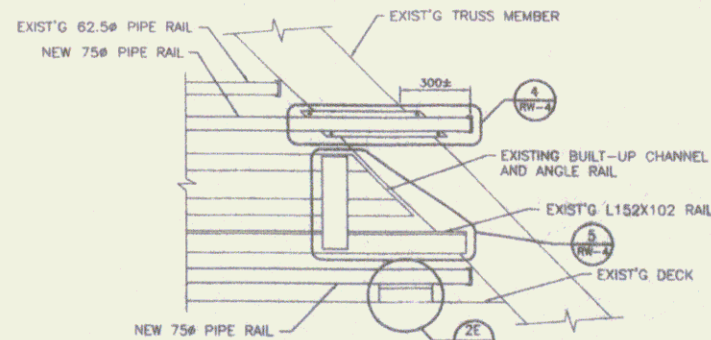


DETAIL
NOT TO SCALE
RW-4

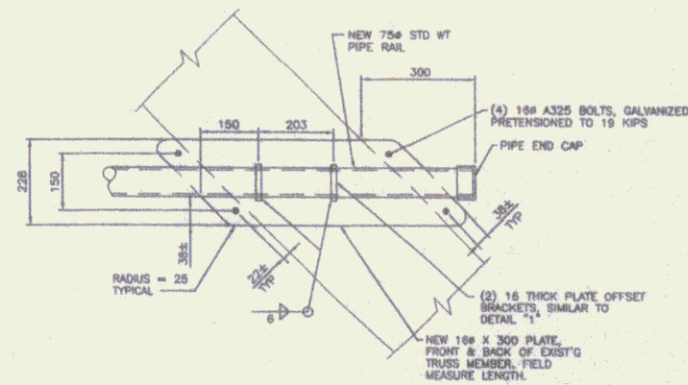

DETAIL
SCALE: 1:10
RW-4

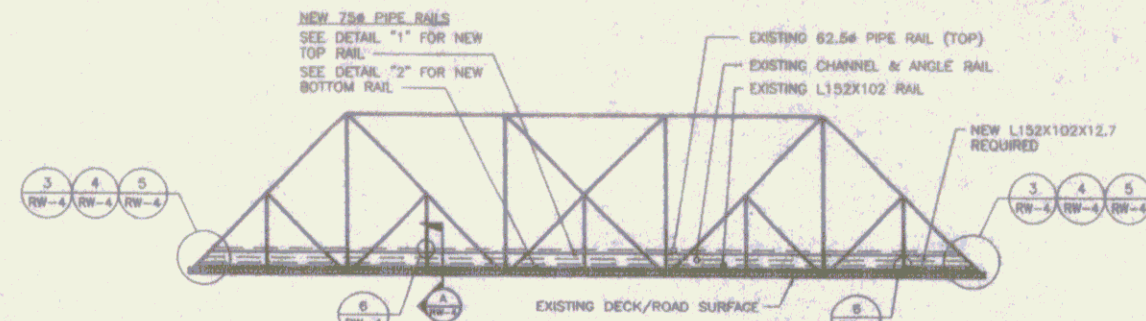


PADDOCK ROAD BRIDGE
SCALE: 1:200
(SCHEMATIC ELEVATION OF "EAST" TRUSS LOOKING EAST)

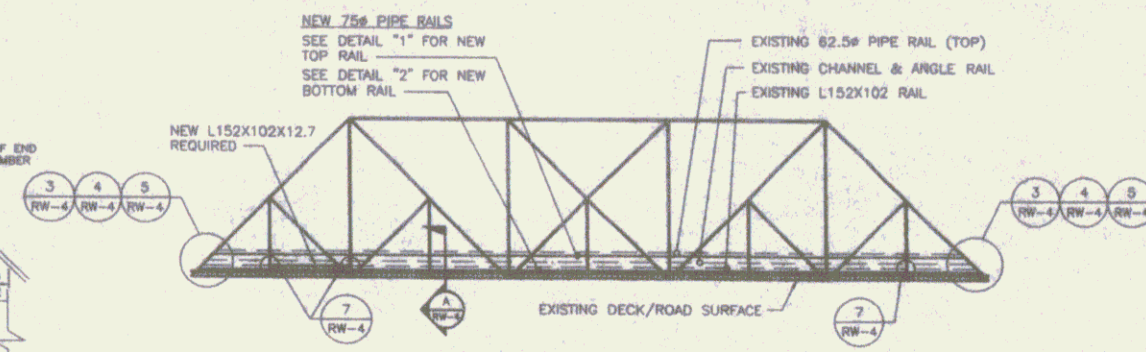


PADDOCK ROAD BRIDGE
SCALE: 1:200
(SCHEMATIC ELEVATION OF "WEST" TRUSS LOOKING WEST)

NOTES:

1. ALL WORK SHOWN ON THIS DRAWING SHALL BE PAID FOR UNDER ITEMS 506.60, 513.25, 513.30, 513.40, AND 513.41.
2. ALL NEW STEEL AND EXISTING STEEL WHICH IS PREPARED FOR WELDING SHALL BE PRIMED AND PAINTED IN ACCORDANCE WITH VDOT'S STANDARD SPECIFICATIONS. COLOR SHALL BE BROWN.
3. ALL EXPOSED EDGES OF NEW STEEL SHALL BE GROUND SMOOTH.
4. ALL NEW BOLT SHALL BE A325, GALVANIZED.
5. THERE SHALL BE NO DRILLING OR WELDING OF EXISTING TRUSS MEMBERS. WELDING AND BOLTING TO EXISTING RAIL MEMBERS SHALL BE ONLY AS DETAILED HEREIN, OR AS DIRECTED BY THE RESIDENT ENGINEER.

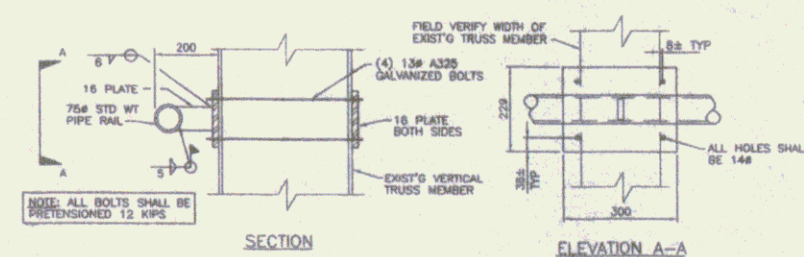

DETAIL
SCALE: 1:10
RW-4

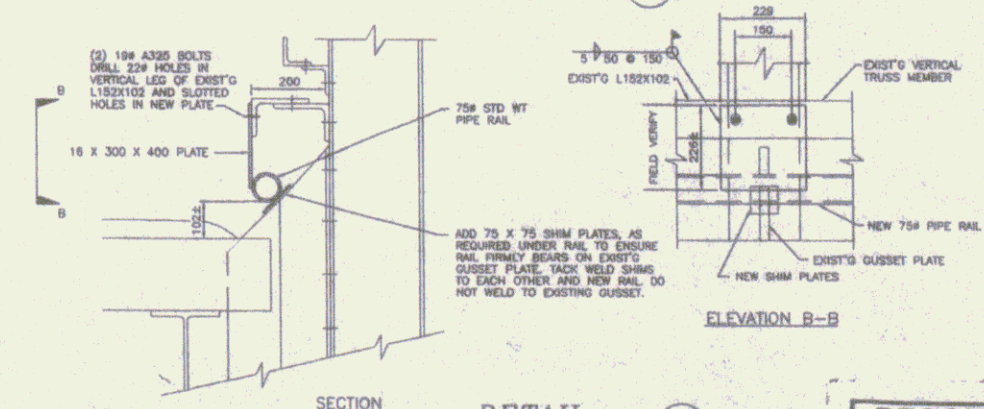

DETAIL
SCALE: 1:10
RW-4

RECORD
DRAWINGS

DESIGNED BY: [Signature]
CHECKED BY: [Signature]
DATE: [Date]
PROJECT: [Project Name]
SHEET: [Sheet Number]

NO.	DATE	REVISIONS
1		
2		
3		
4		
5		
6		
7		
8		
9		
10		



SPRINGFIELD TRAILS AND GREENWAYS
BICYCLE AND PEDESTRIAN PATH
PHASE 1
TOWN OF SPRINGFIELD, VERMONT
PADDOCK ROAD BRIDGE RAIL DETAILS

REVISION BY	DATE
DESIGNED BY	DATE
CHECKED BY	DATE
DATE	DATE
FILE	DATE
SCALE	DATE
METHOD	DATE
PROJECT (SHEET)	DATE

RW-4
SHEET 17