
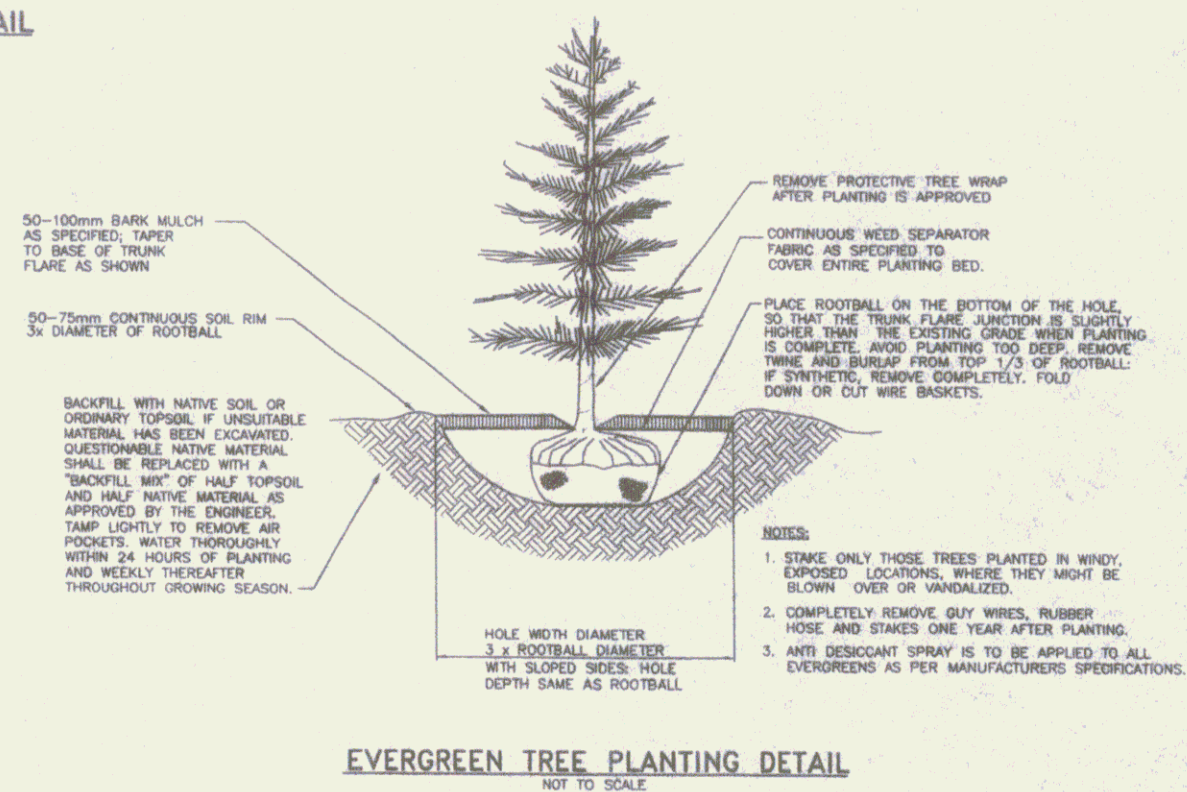
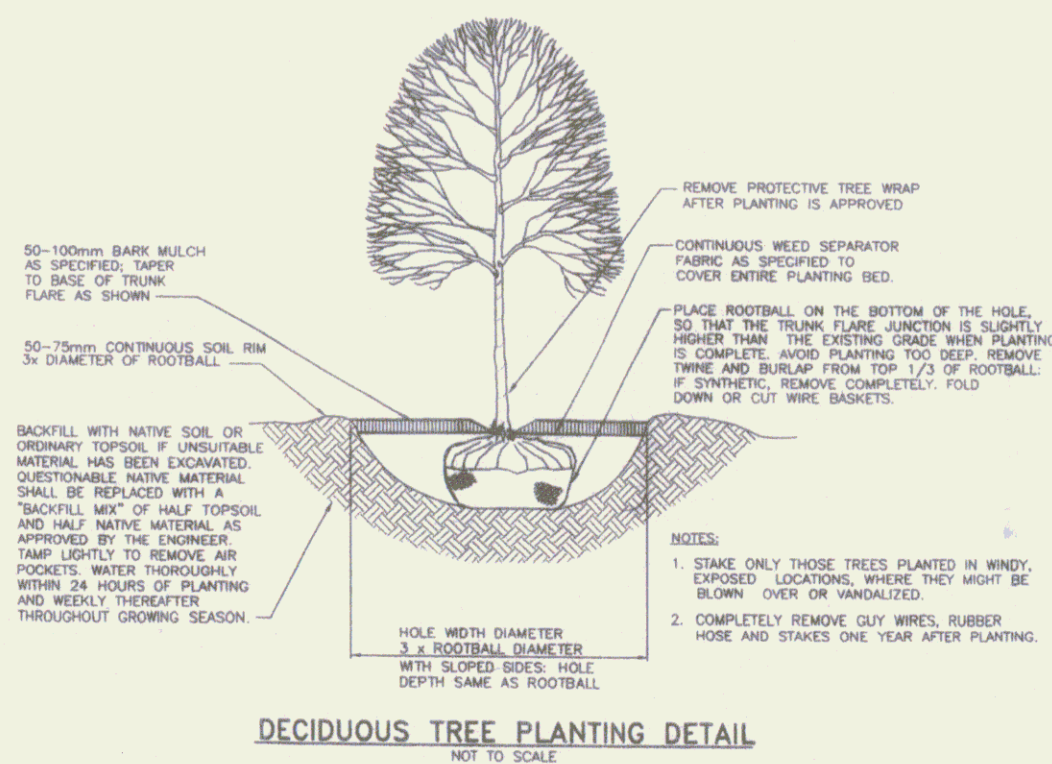
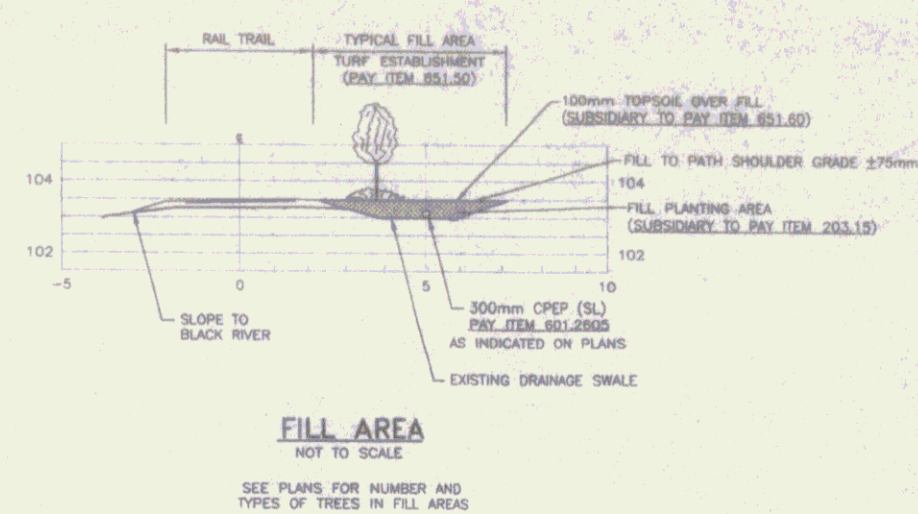
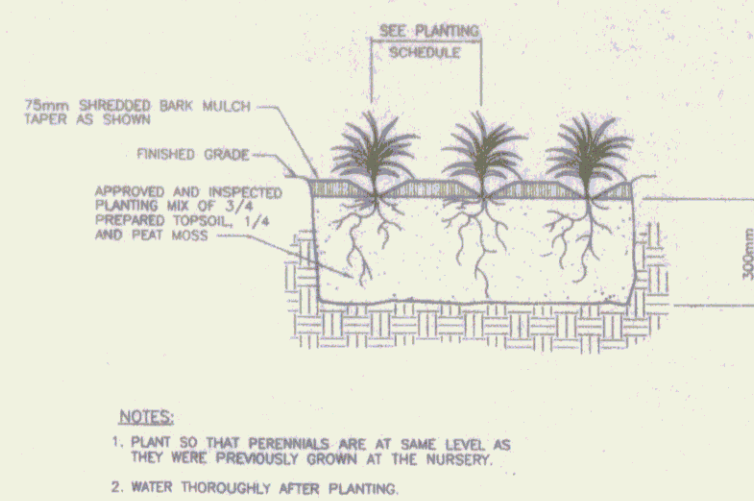


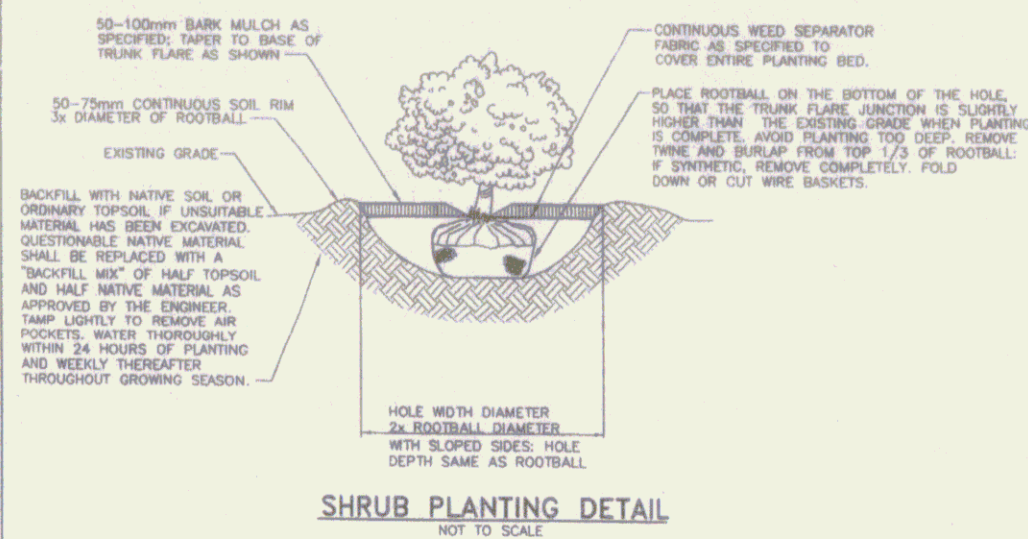

SEEDING FORMULAS

% WT.	kg/ha	NAME	PUR %	GER %
35.71	24.6	CREEPING RED FESCUE	98	85
35.71	24.6	TALL FESCUE	95	91
7.14	5.0	RED TOP	95	90
14.30	10.1	BIRDFOOT TREFOIL	98	85
7.14	5.8	ANNUAL RYE GRASS	95	85
100.0	69.1			

PLANT LIST

Quantity - See Plan Sheets For Details at Bid Time

QUANTITY	KEY	PAY ITEM NO.	BOTANICAL NAME / COMMON NAME	SIZE	ROOT
<u>TREES</u>					
10	FA	656.30	FRAXINUS AMERICANA / WHITE ASH - <i>Detached From Canopy</i>	45mm	B&B
20	FP	656.30	FRAXINUS PENNSYLVANICA / GREEN ASH	45mm	B&B
8	UA	656.30	ULNUS AMERICANA "PRINCETON" / "PRINCETON" AMERICAN ELM <i>Detached</i>	45mm	B&B
5	AR	656.30	ACER RUBRUM / RED MAPLE <i>Detached</i>	45mm	B&B
3	PS	656.20	PINUS STROBUS / WHITE PINE	1.5m HEIGHT	B&B
4	QR	656.30	QUERCUS RUBRA / NORTHERN RED OAK	45mm	B&B
<u>SHRUBS, GROUND COVER, PERENNIAL</u>					
20	CP	656.35	COMPTONIA PEREGRINA / SWEETFERN	600mm	B&B OR NO. 5 CONT
50	RR	656.35	ROSA RUGOSA / ROSA RUGOSA	500-600mm	NO. 3 CONT
50	VD	656.35	VIBURNUM DENTATUM / ARROWWOOD VIBURNUM	600mm	NO. 5 CONT

NOTES:

1. SEED MIXTURE SHALL NOT HAVE A WEED CONTENT EXCEEDING 0.40% BY WEIGHT AND SHALL BE FREE OF ALL NOXIOUS SEED.
2. FORMULA 5-10-10 FERTILIZER TO BE USED WITH SEED, APPLIED AT A RATE OF 340 kg/ha (HYDRO SEEDERS MAY USE 10-19-19 FORMULA).
3. PELLETED AGRICULTURAL LIMESTONE TO BE APPLIED AT THE RATE OF 4.9 t/ha OR AS DIRECTED BY THE ENGINEER.
4. AIR DRIED HAY OR STRAW, FREE FROM UNDESIRABLE SEEDS AND COARSE MATERIAL, TO BE APPLIED AT THE RATE OF 4.9 t/ha OR AS DIRECTED BY THE ENGINEER.
5. TOPSOIL TO BE USED WITH SEED AS INDICATED ON THE PLANS OR AS DIRECTED BY THE ENGINEER.
6. BACKFILLING SHALL BE COMPLETED USING NATIVE SOIL DUG FROM PLANTING HOLES, UNLESS THE SOIL IS POOR QUALITY (I.E. SANDY, EXCESSIVELY DRAINED SOIL OR CLAY, POORLY DRAINED SOIL OR OTHER UNDESIRABLE FILL MATERIAL). REPLACE POOR QUALITY SOIL WITH ORGANIC TOPSOIL OR A MIX OF NATIVE SOIL AND TOPSOIL, OR AS DIRECTED BY THE ENGINEER.

RECORD DRAWINGS

Metric

SHEET 21

21

SPRINGFIELD TRANSPORTATION PATH
PHASE 1
TOWN OF SPRINGFIELD
SPRINGFIELD, VERMONT
LANDSCAPE DETAILS

DATE	BY	REVISION
01/15/2010	LD	1. INITIAL

DESIGNED BY: LD
 CHECKED BY: LD
 DATE: 01/15/2010
 SCALE: 1/8" = 1'-0"

DATE: 01/15/2010
 BY: LD
 REVISION: 1. INITIAL
 SCALE: 1/8" = 1'-0"

METRIC

LD