




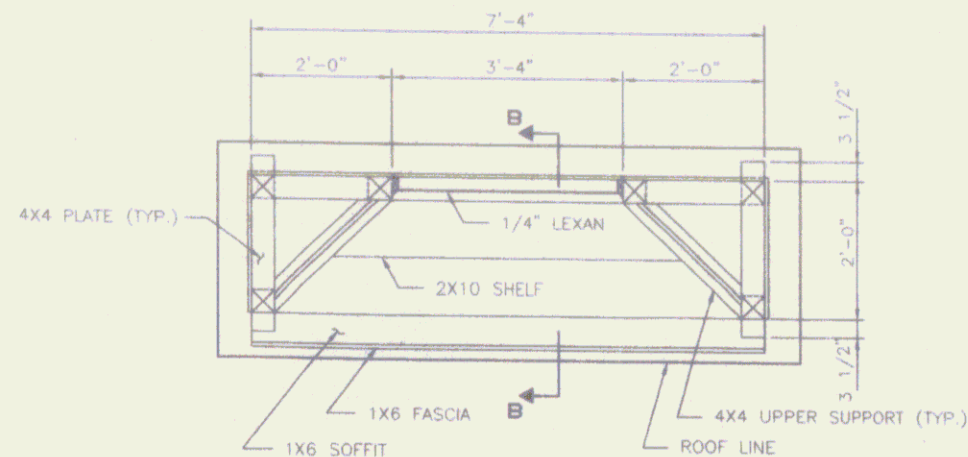


PLAN - (Below Roof)
SCALE: 3/4" = 1'-0"

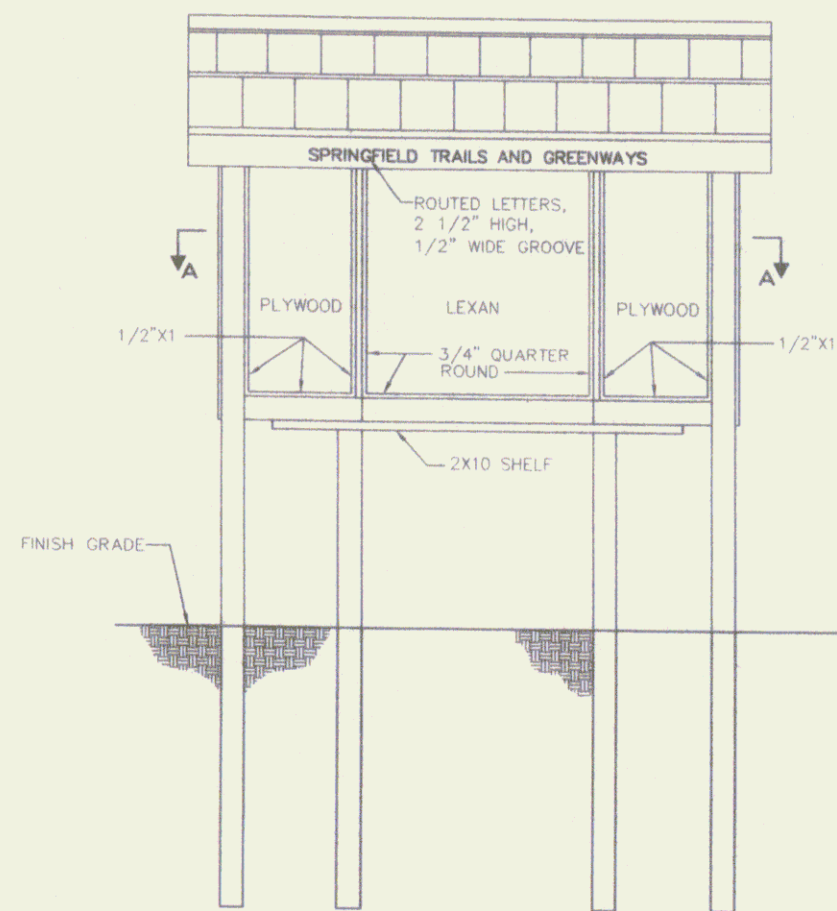


FRONT ELEVATION
SCALE: 3/4" = 1'-0"

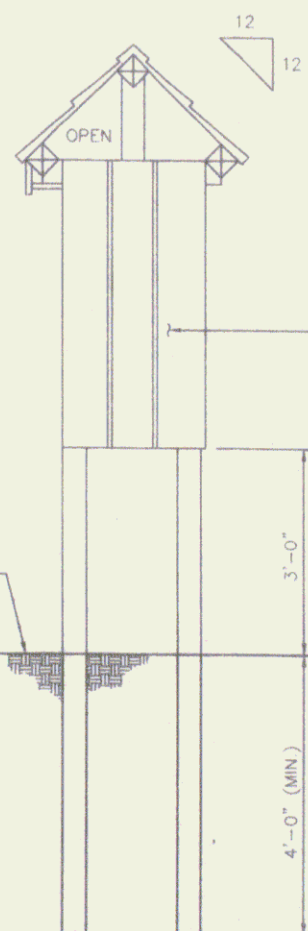


SIDE ELEVATION
SCALE: 3/4" = 1'-0"

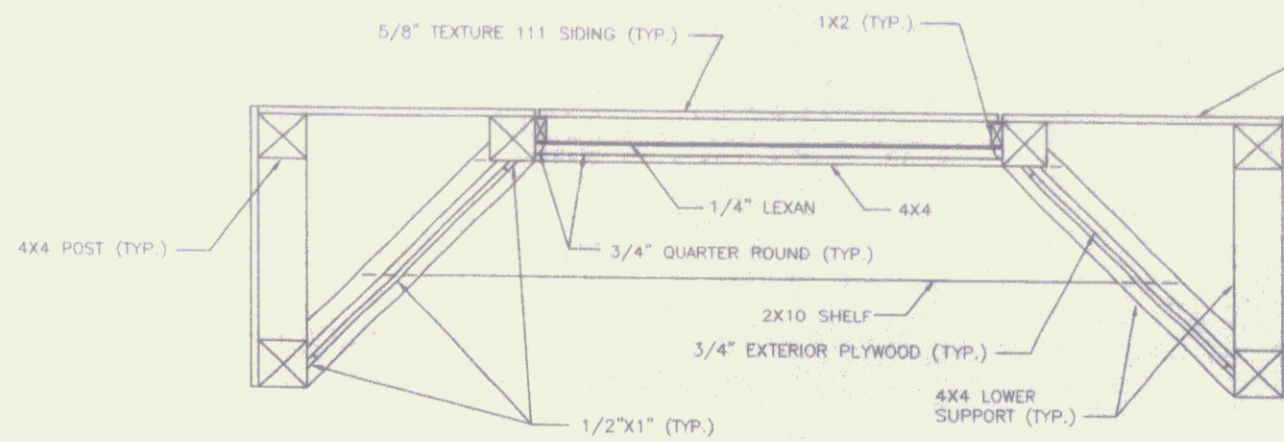

SECTION A-A
SCALE: 1 1/2" = 1'-0"

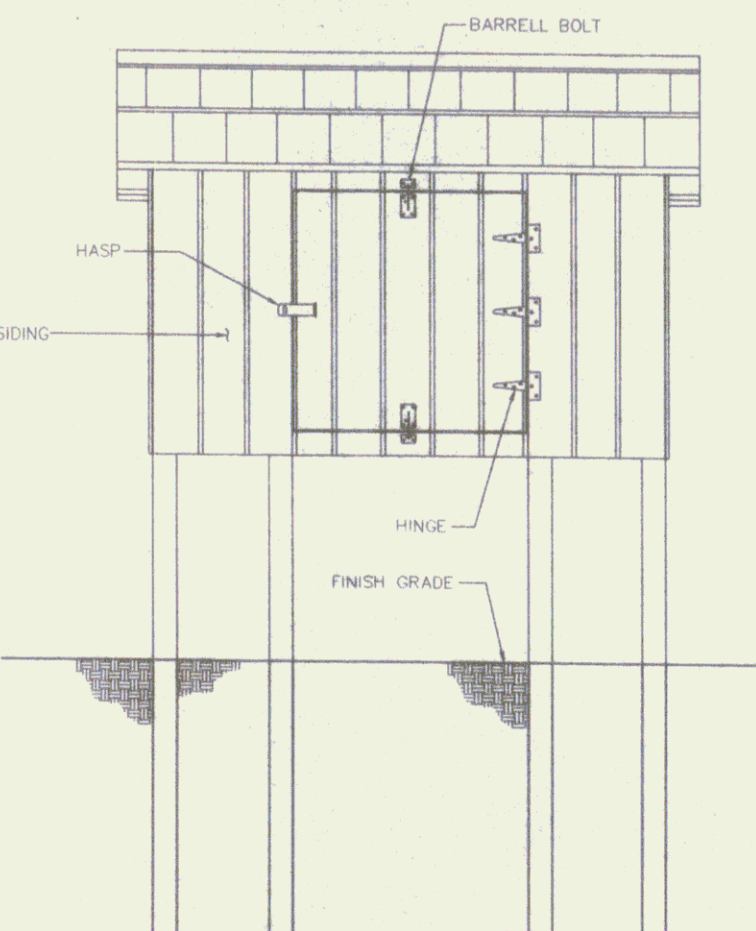

REAR ELEVATION
SCALE: 3/4" = 1'-0"

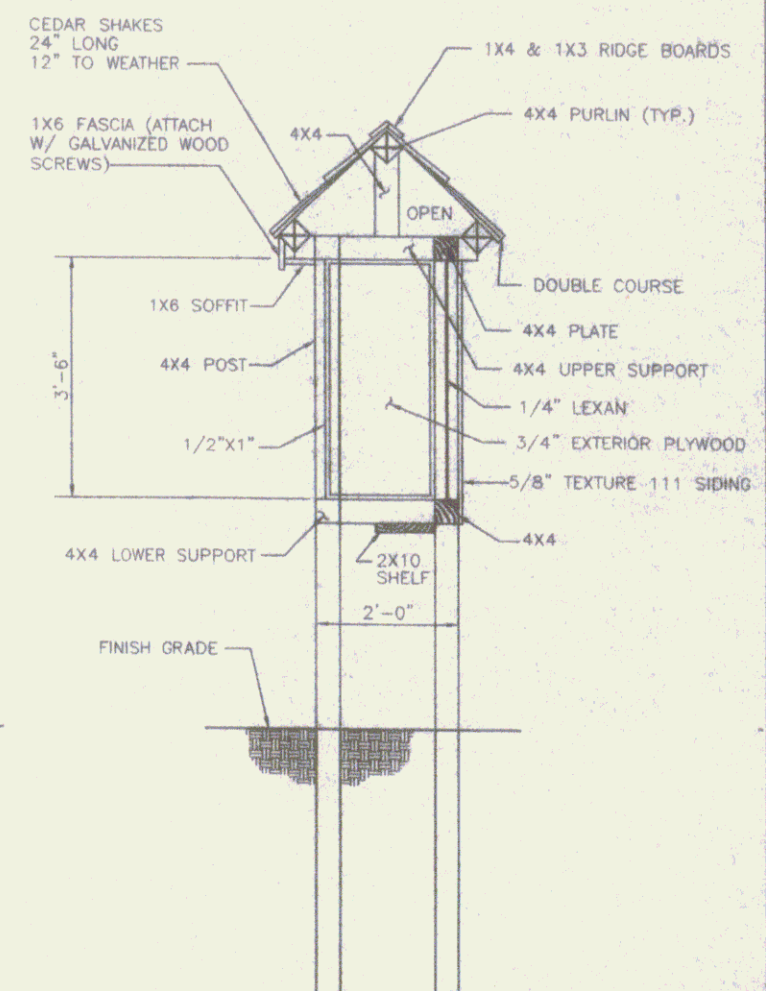

SECTION B-B
SCALE: 3/4" = 1'-0"

NOTES:

1. P.T. = PRESSURE TREATED
2. R.O. = ROUGH OPENING
3. INFORMATION ON THIS SHEET HAS BEEN ADOPTED FROM A U.S. DEPARTMENT OF AGRICULTURE SHEET, FILE NO. 7610-157 ENTITLED "REGISTER BULLETIN BOARD".

BILL OF MATERIALS

NO.	SIZE	FINISH / DESCRIPTION	USE	NO.	SIZE	FINISH / DESCRIPTION	USE
6	4X4X12'	S4S (P.T.)	POSTS	1	40"X42"X1/4" (R.O.)	LEXAN	BULLETIN BOARD
4	4X4X8'	S4S (P.T.)	PURLINS, PLATE (LONG)	2	BUNDLES	24"	HANDSPLIT CEDAR SHAKES
2	4X4X12'	S4S (P.T.)	SUPPORTS, PLATES	16	LIN. FT.	3/4"	QUARTER ROUND
1	2X10X5'	S4S (P.T.)	SHELF	24	LIN. FT.	1/2"X1"	S4S (WHITE PINE)
1	1X6X8'	S4S(WHITE PINE)	FASCIA	16		3/8"X6"	LAG SCREWS W/ WASHERS
1	1X6X8'	S4S (P.T.)	SOFFIT	2	LB. BOX	6P	GALVANIZED NAILS
1	1X4X9'	S4S (P.T.)	RIDGE BOARD	3		5"	T-HINGES
1	1X3X9'	S4S (P.T.)	RIDGE BOARD	1		3 1/4"	SAFETY HASP
2	1X2X8'	S4S (P.T.)	BULLETIN BOARD	2		3"	BARRELL BOLTS
2	4X9X5/8"	TEXTURE 111	SIDING				ROUTED LETTER-ENAMEL PAINT (LEMON YELLOW OR EQUAL)
1	4X8X3/4"	EXTERIOR PLYWOOD	BULLETIN BOARDS				WOOD STAIN (EXCEPT ROOF)-INTERIOR/EXTERIOR STAIN (DANISH WALNUT OR EQUAL)

*N. I. C.
Constructed by
Crown Point Builders
Set by J. P. Sicard Inc.*

NOTE:

ALL DIMENSIONS SHOWN ON THIS PLAN ARE IMPERIAL.

RECORD DRAWINGS

SPRINGFIELD TRANSPORTATION PATH

PHASE 1

TOWN OF SPRINGFIELD

SPRINGFIELD, VERMONT

KIOSK DETAILS

REVISIONS

NO.	DATE	BY	REVISIONS
1	11/09	J.P.	REVISION PER REVIEW COMMENTS
2	8/08	J.P.	REVISION PER REVIEW COMMENTS
3	3/08	J.P.	REVISION PER REVIEW COMMENTS

PROJECT DATA

DESIGNED BY: J.P. SICARD

DRAWN BY: J.P. SICARD

CHECKED BY: J.P. SICARD

SCALE: 1/4" = 1'-0"

SHEET 22

KD