

PLAN	DATE	BY
4-56	4-56	4-56
4-56	4-56	4-56
4-56	4-56	4-56

PROFILE	DATE	BY
4-56	4-56	4-56
4-56	4-56	4-56
4-56	4-56	4-56

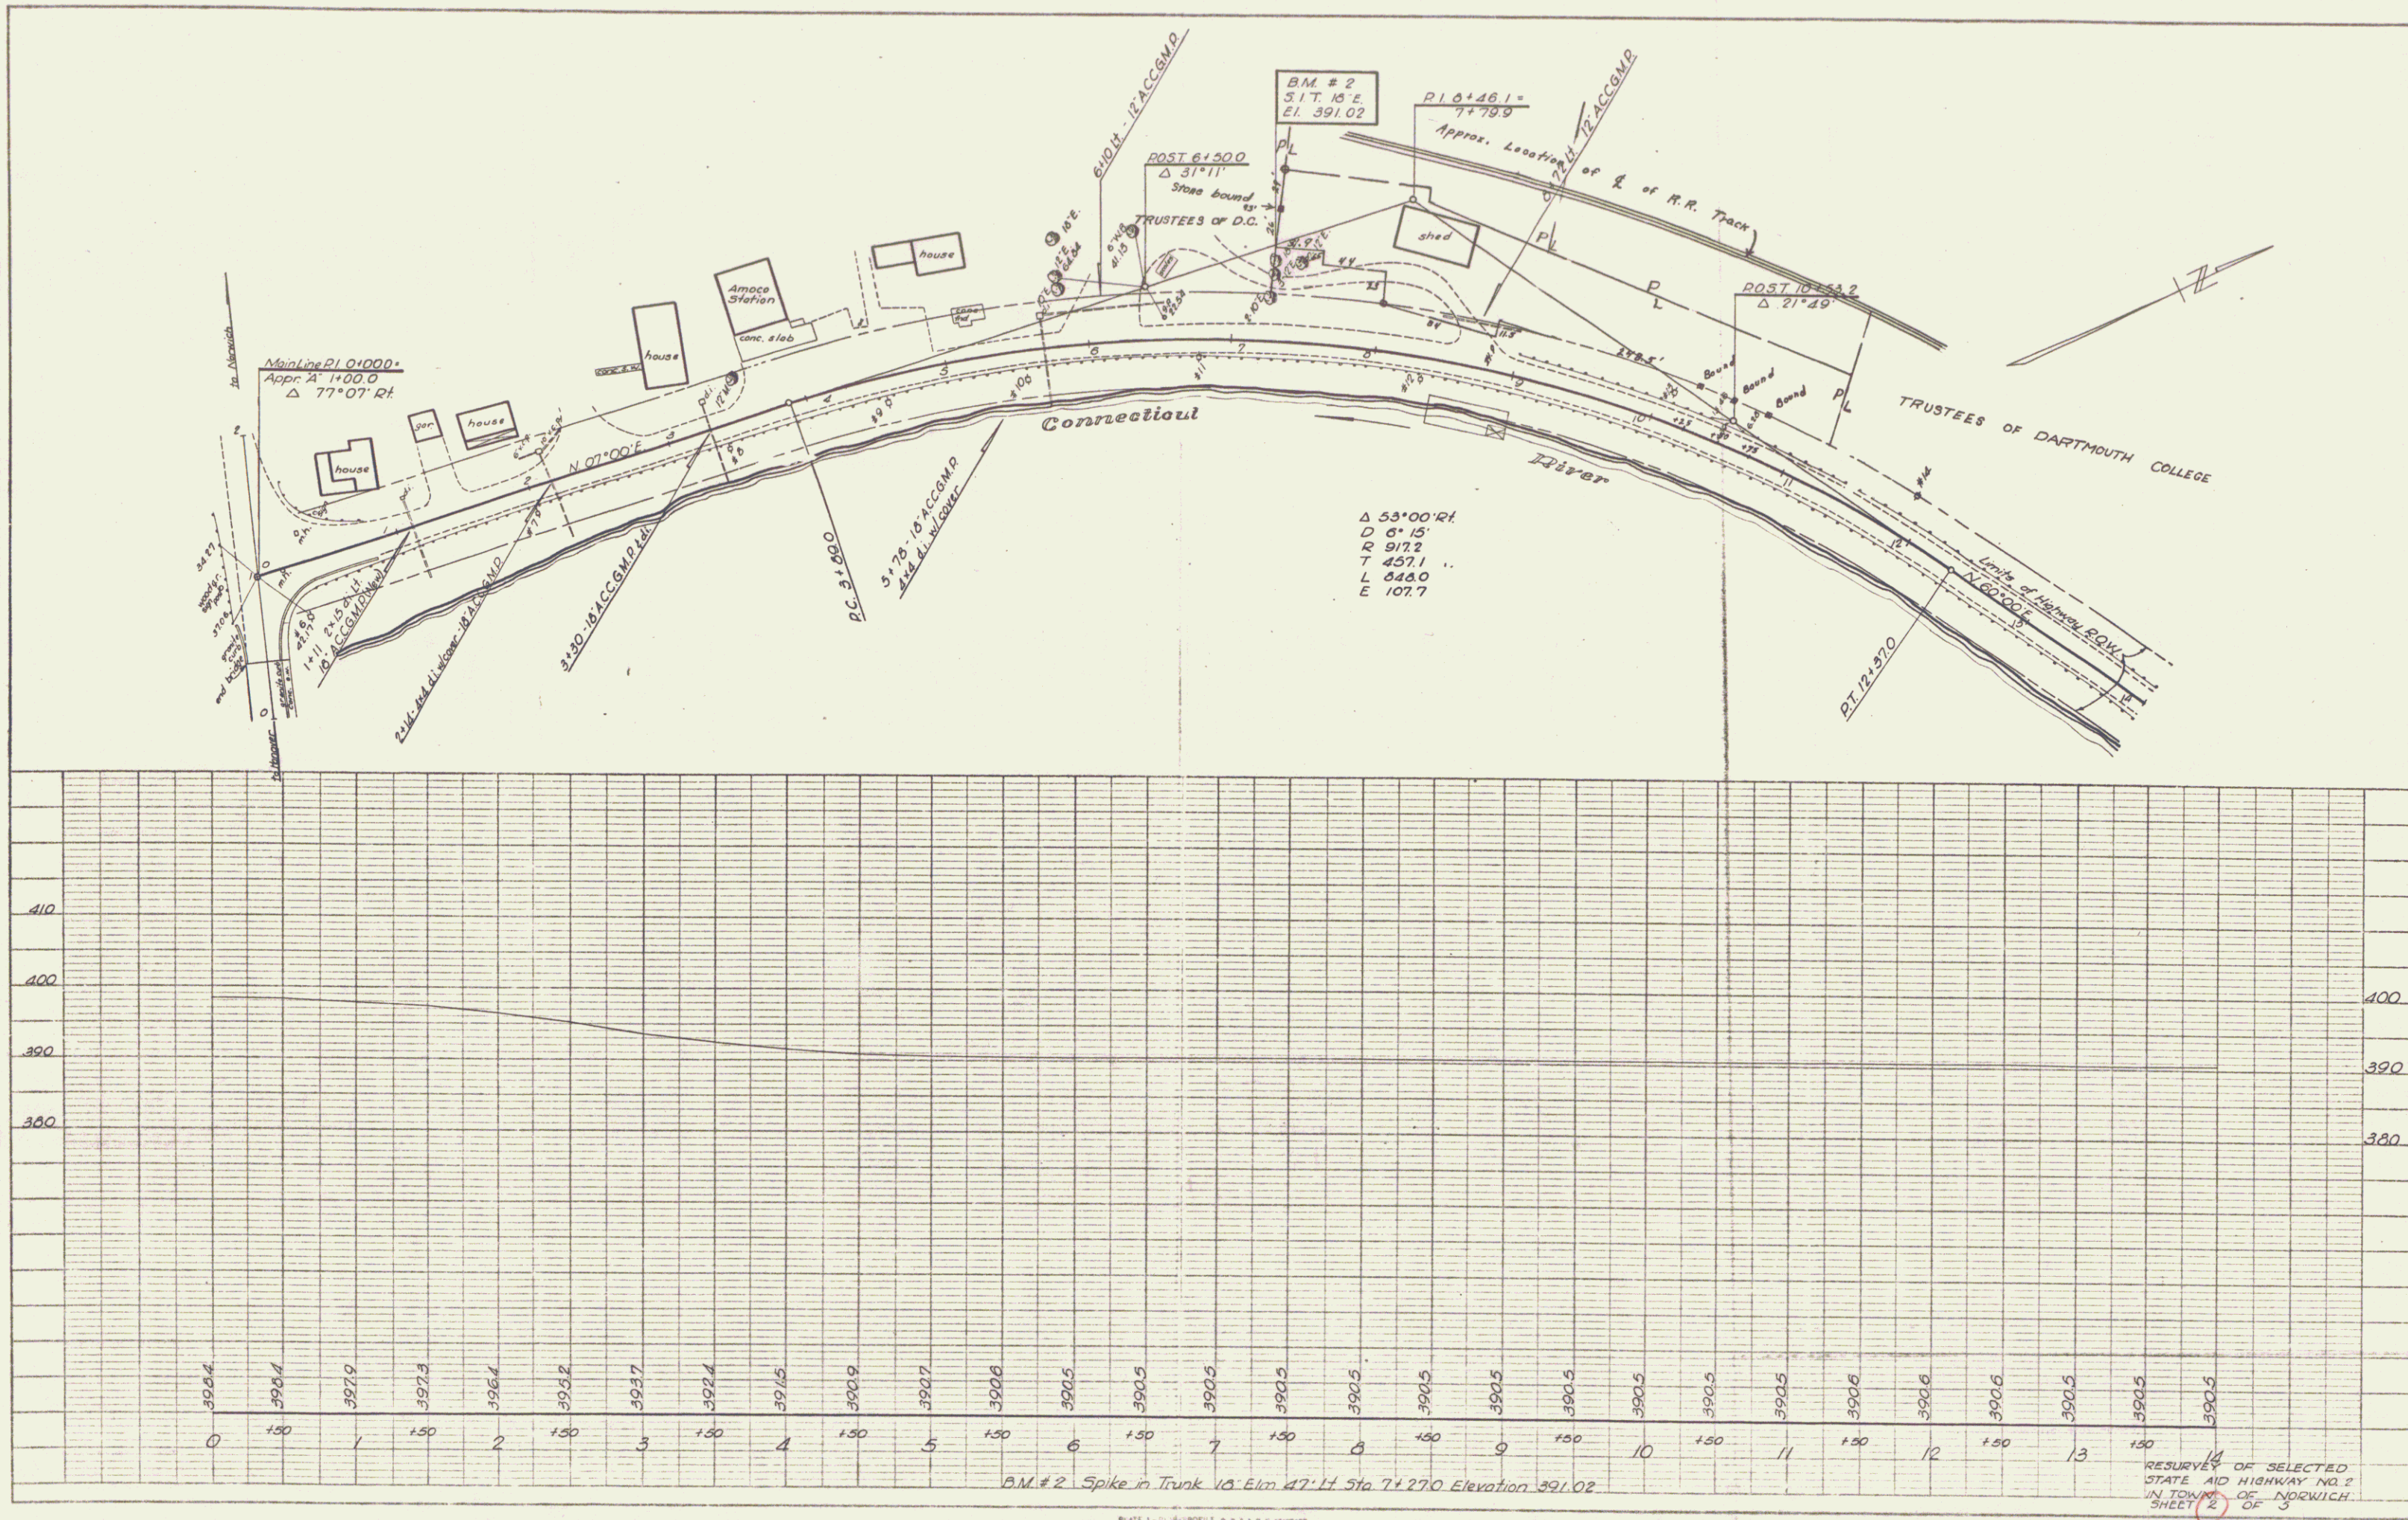


PLATE 1-11-11 PROFILE & P.A.R.R. STANDARD
 KELLOGG & BROWN CO. NEW YORK
 11-11-11

RESURVEY OF SELECTED
 STATE AID HIGHWAY NO. 2
 IN TOWN OF NORWICH
 SHEET 2 OF 3