

PLAN
 DATE: 10/1/54
 SHEET NO. 3 OF 3

PROFILE
 DATE: 10/1/54
 SHEET NO. 3 OF 3

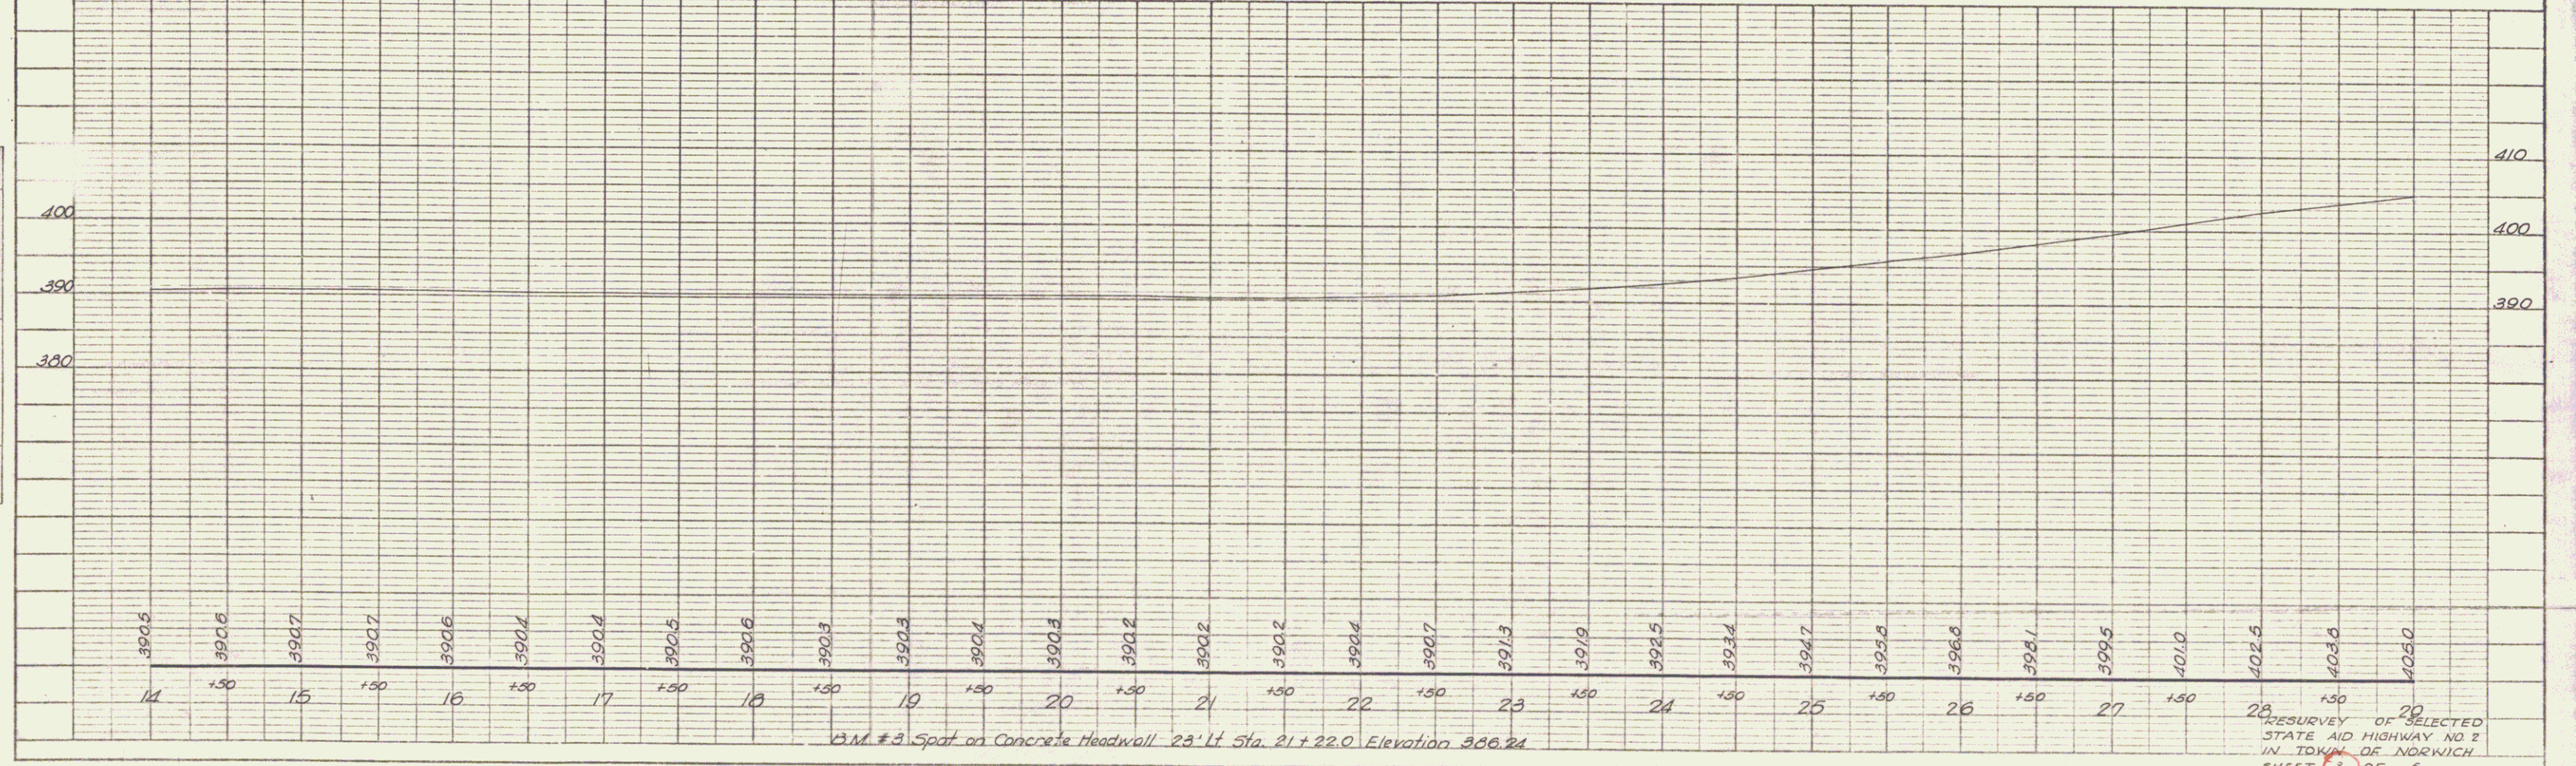
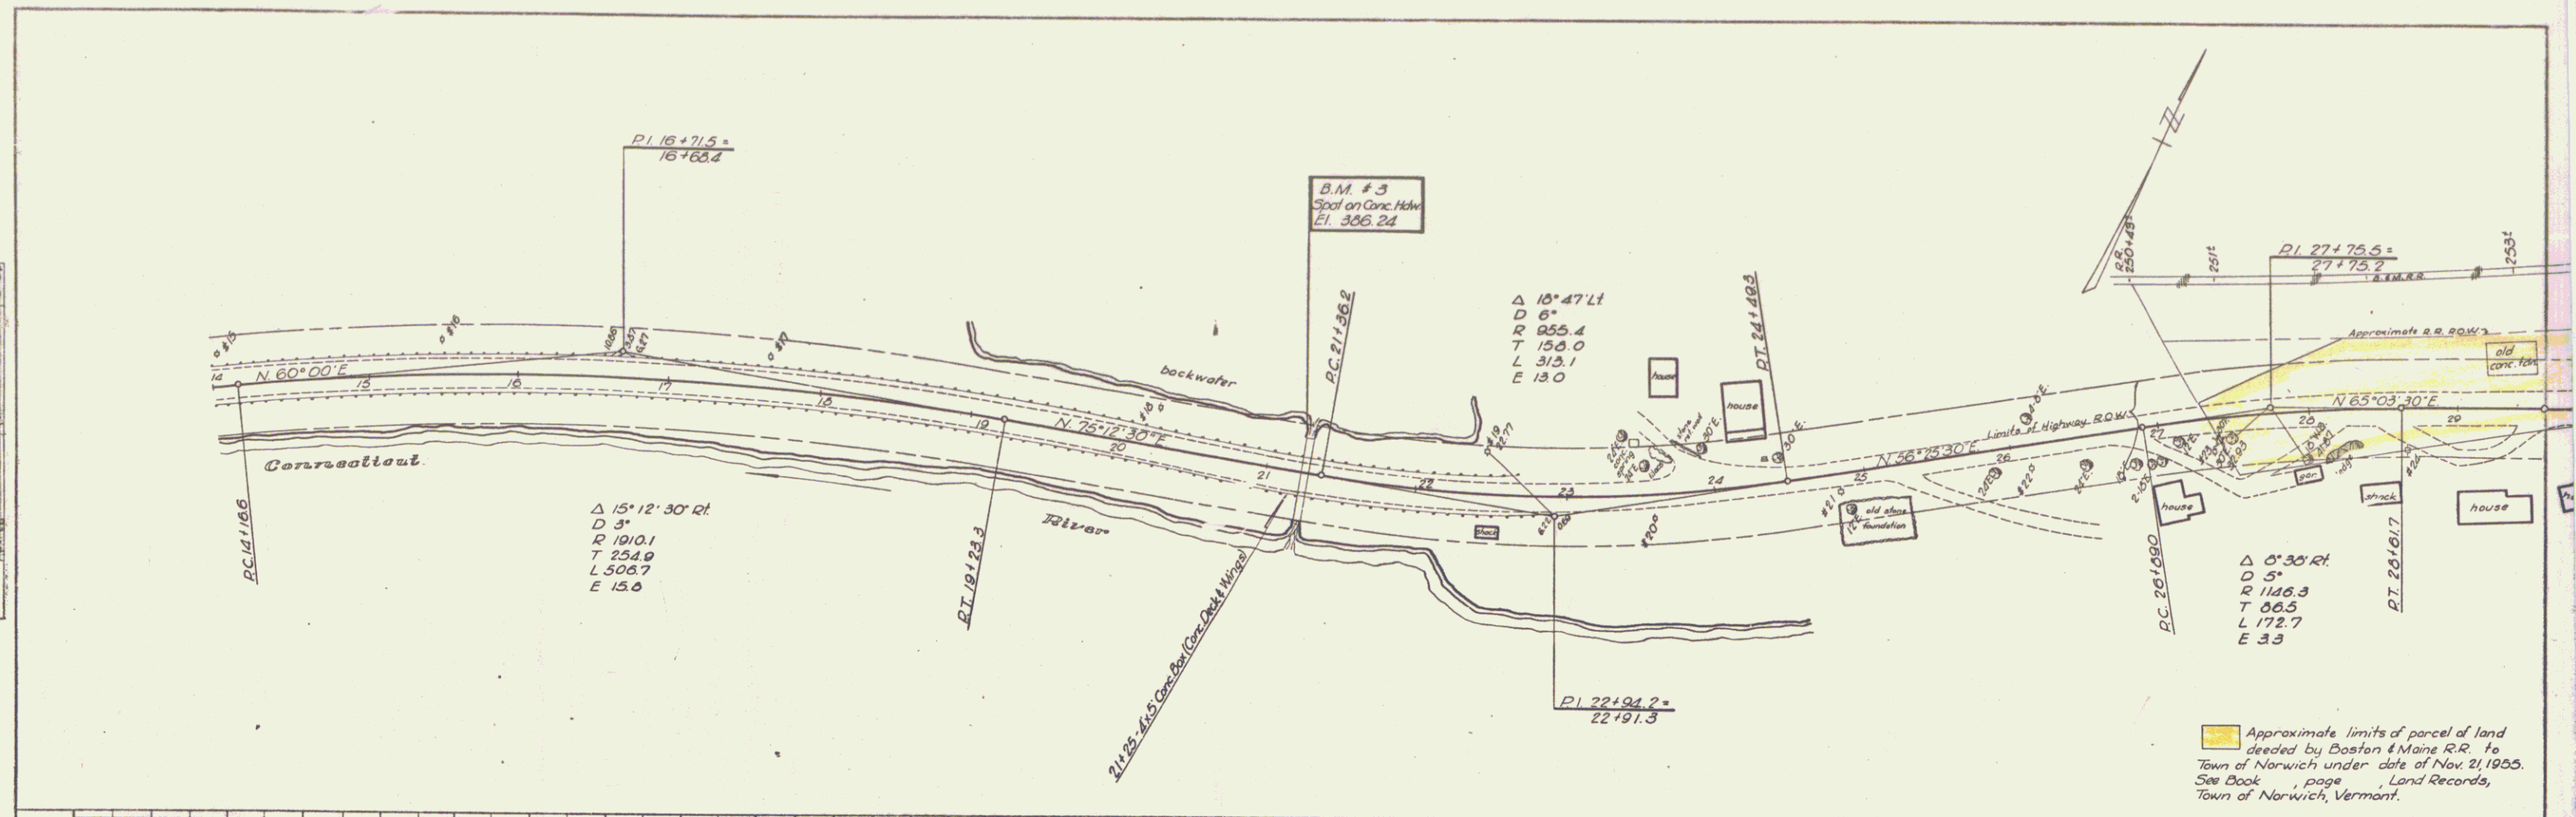


PLATE 1 - PLAN - PROFILE OF P. & R. E. STATION
 KEMPFL & ESTER CO., NEW YORK
 P.L.C. No. 348-10

RESURVEY OF SELECTED
 STATE AID HIGHWAY NO 2
 IN TOWN OF NORWICH
 SHEET 3 OF 3