


MP 0.614
243+25
BEGIN PROJECT

VERMONT ROUTE 5A

BEGINNING AT A POINT APPROXIMATELY 0.614 MILES
NORTHWESTERLY FROM THE NEWARK-WESTMORE
TOWN LINE AND EXTENDING NORTHWESTERLY 0.242 MILES

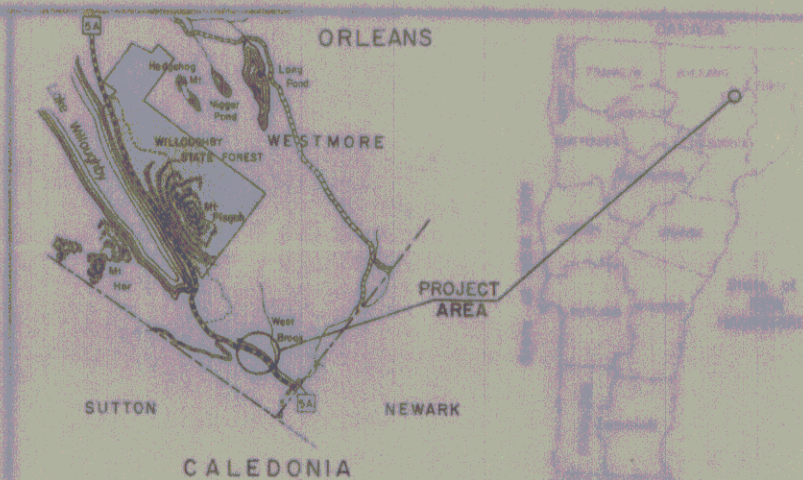

203.16 Solid Rock Excavation	C.Y.	300	(Est)	300
406.25 Bituminous Conc Pavement	Ton	10	(Est)	10
607.10 Roadway Patrol Maintenance	Hr.	5	(Est)	5

TRAFFIC DATA		
1975	ADT	25
	DHV	55
	D	63
	T	9
5 Year	Accident Rate	3.73

CONTRACTOR-STATE FORCES
ENGINEER--ERROUND
STARTED-20 MAY 1975
COMPLETED-10 JUNE 1975
ACCEPTED-13 AUGUST 1975

Note: Utility pole locations are approximate except offset from centerline where noted.

Project consists of roadside
boulder removal at ...

<u>Sta.</u>	<u>Lt.</u>	<u>Rt.</u>
243+45		20'
251+90	30'	
255+85	20'	

MP 0.856
256+05
END PROJECT

Pin# 13R243

APPROVED [Signature] DATE 3-25-78

WESTMORE 5A

LOW ETA: 39:50

SHANGHAI
CHECKED BY
DATE

RUS 0287 (1)

SHEET 1 of 1