



TOWN OF RUTLAND  
 Project: HOME DEPOT  
 SHOPPING CENTER  
 Pin # 13R384  
 Route US4  
 Date 10/1/2001  
 MP 0.00-0.188

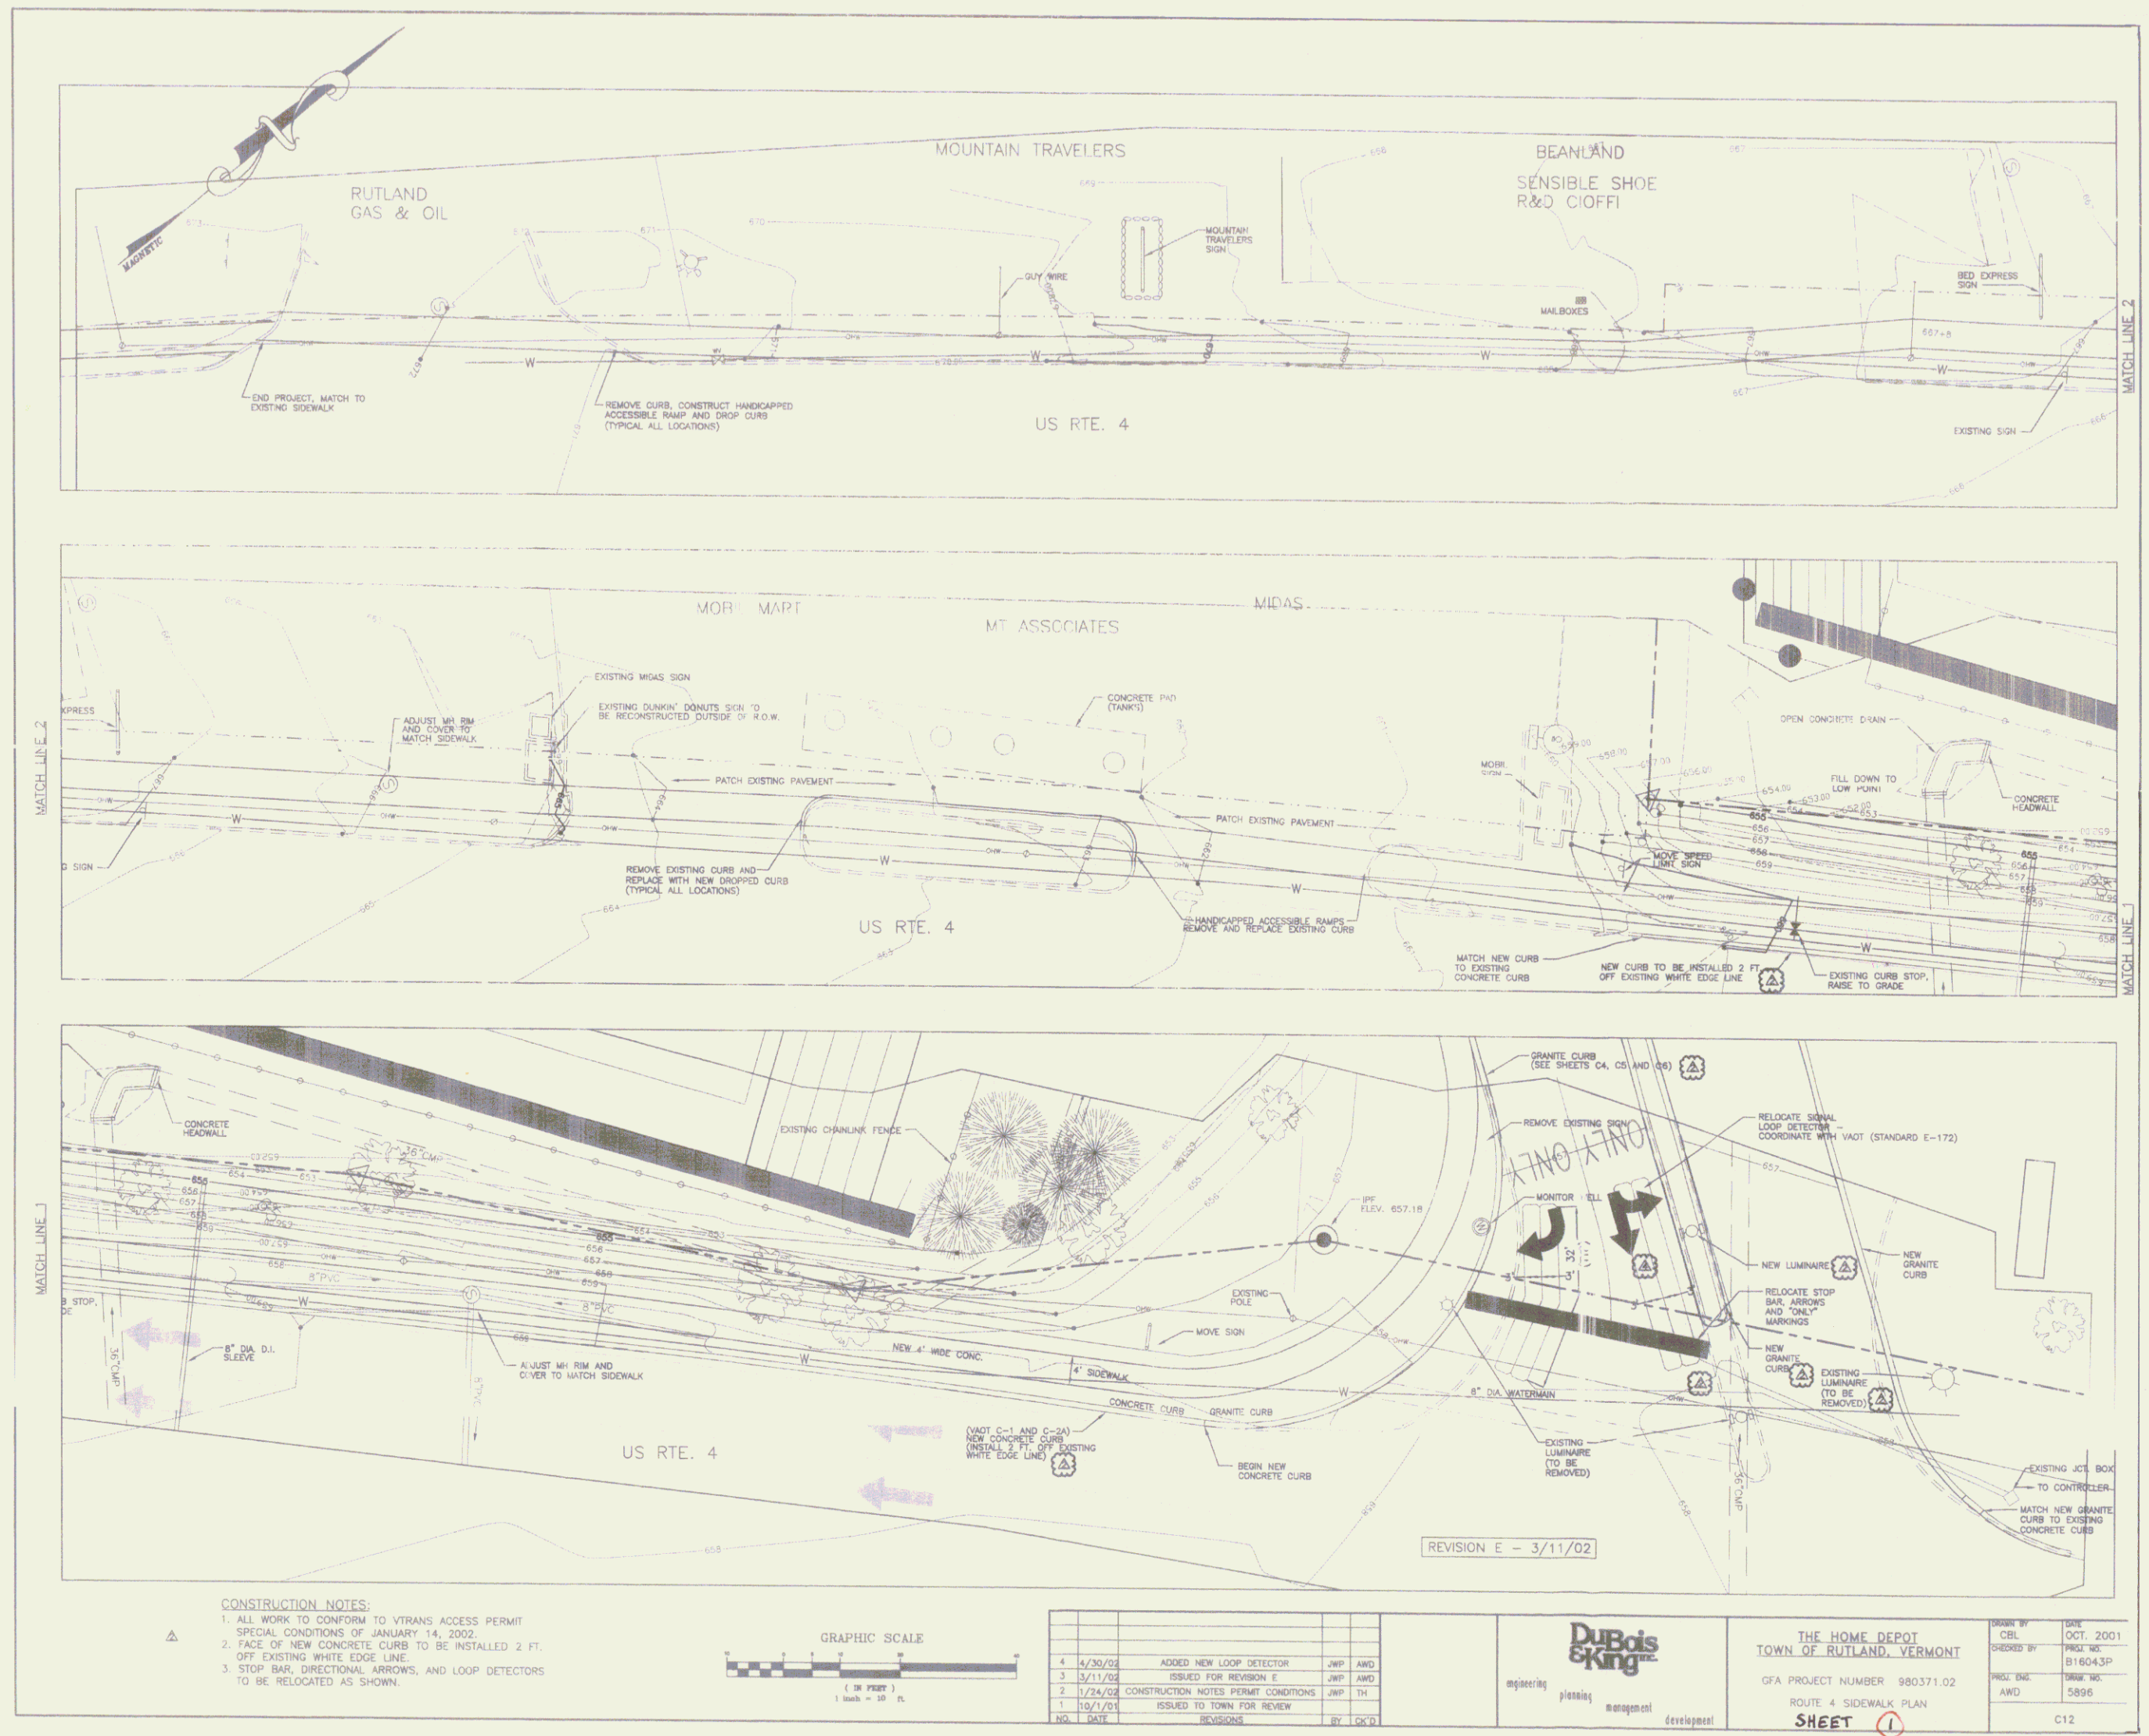

- CONSTRUCTION NOTES:
1. ALL WORK TO CONFORM TO VTRANS ACCESS PERMIT SPECIAL CONDITIONS OF JANUARY 14, 2002.
  2. FACE OF NEW CONCRETE CURB TO BE INSTALLED 2 FT. OFF EXISTING WHITE EDGE LINE.
  3. STOP BAR, DIRECTIONAL ARROWS, AND LOOP DETECTORS TO BE RELOCATED AS SHOWN.

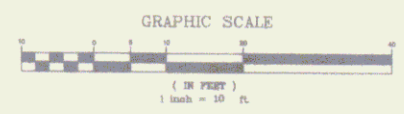

NO.	DATE	REVISIONS	BY	CHK'D
4	4/30/02	ADDED NEW LOOP DETECTOR	JWP	AWD
3	3/11/02	ISSUED FOR REVISION E	JWP	AWD
2	1/24/02	CONSTRUCTION NOTES PERMIT CONDITIONS	JWP	TH
1	10/1/01	ISSUED TO TOWN FOR REVIEW	JWP	TH



THE HOME DEPOT  
 TOWN OF RUTLAND, VERMONT  
 GFA PROJECT NUMBER 980371.02  
 ROUTE 4 SIDEWALK PLAN  
**SHEET 1**

DESIGNED BY	DATE	SCALE
CHK'D BY	OCT. 2001	
PROJECT NO.		
BY 1604.SP		
PROJ. ENG.		
AWD	5896	
		C12