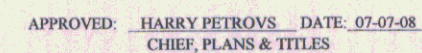


9/24/2009

32