


PLAN  
 DRAWN BY: A. Lavin  
 CHECKED BY: J. J. [unclear]  
 DATE: 11/84  
 PROJECT: [unclear]

PROFILE  
 DRAWN BY: A. Lavin  
 CHECKED BY: J. J. [unclear]  
 DATE: 11/83  
 PROJECT: [unclear]

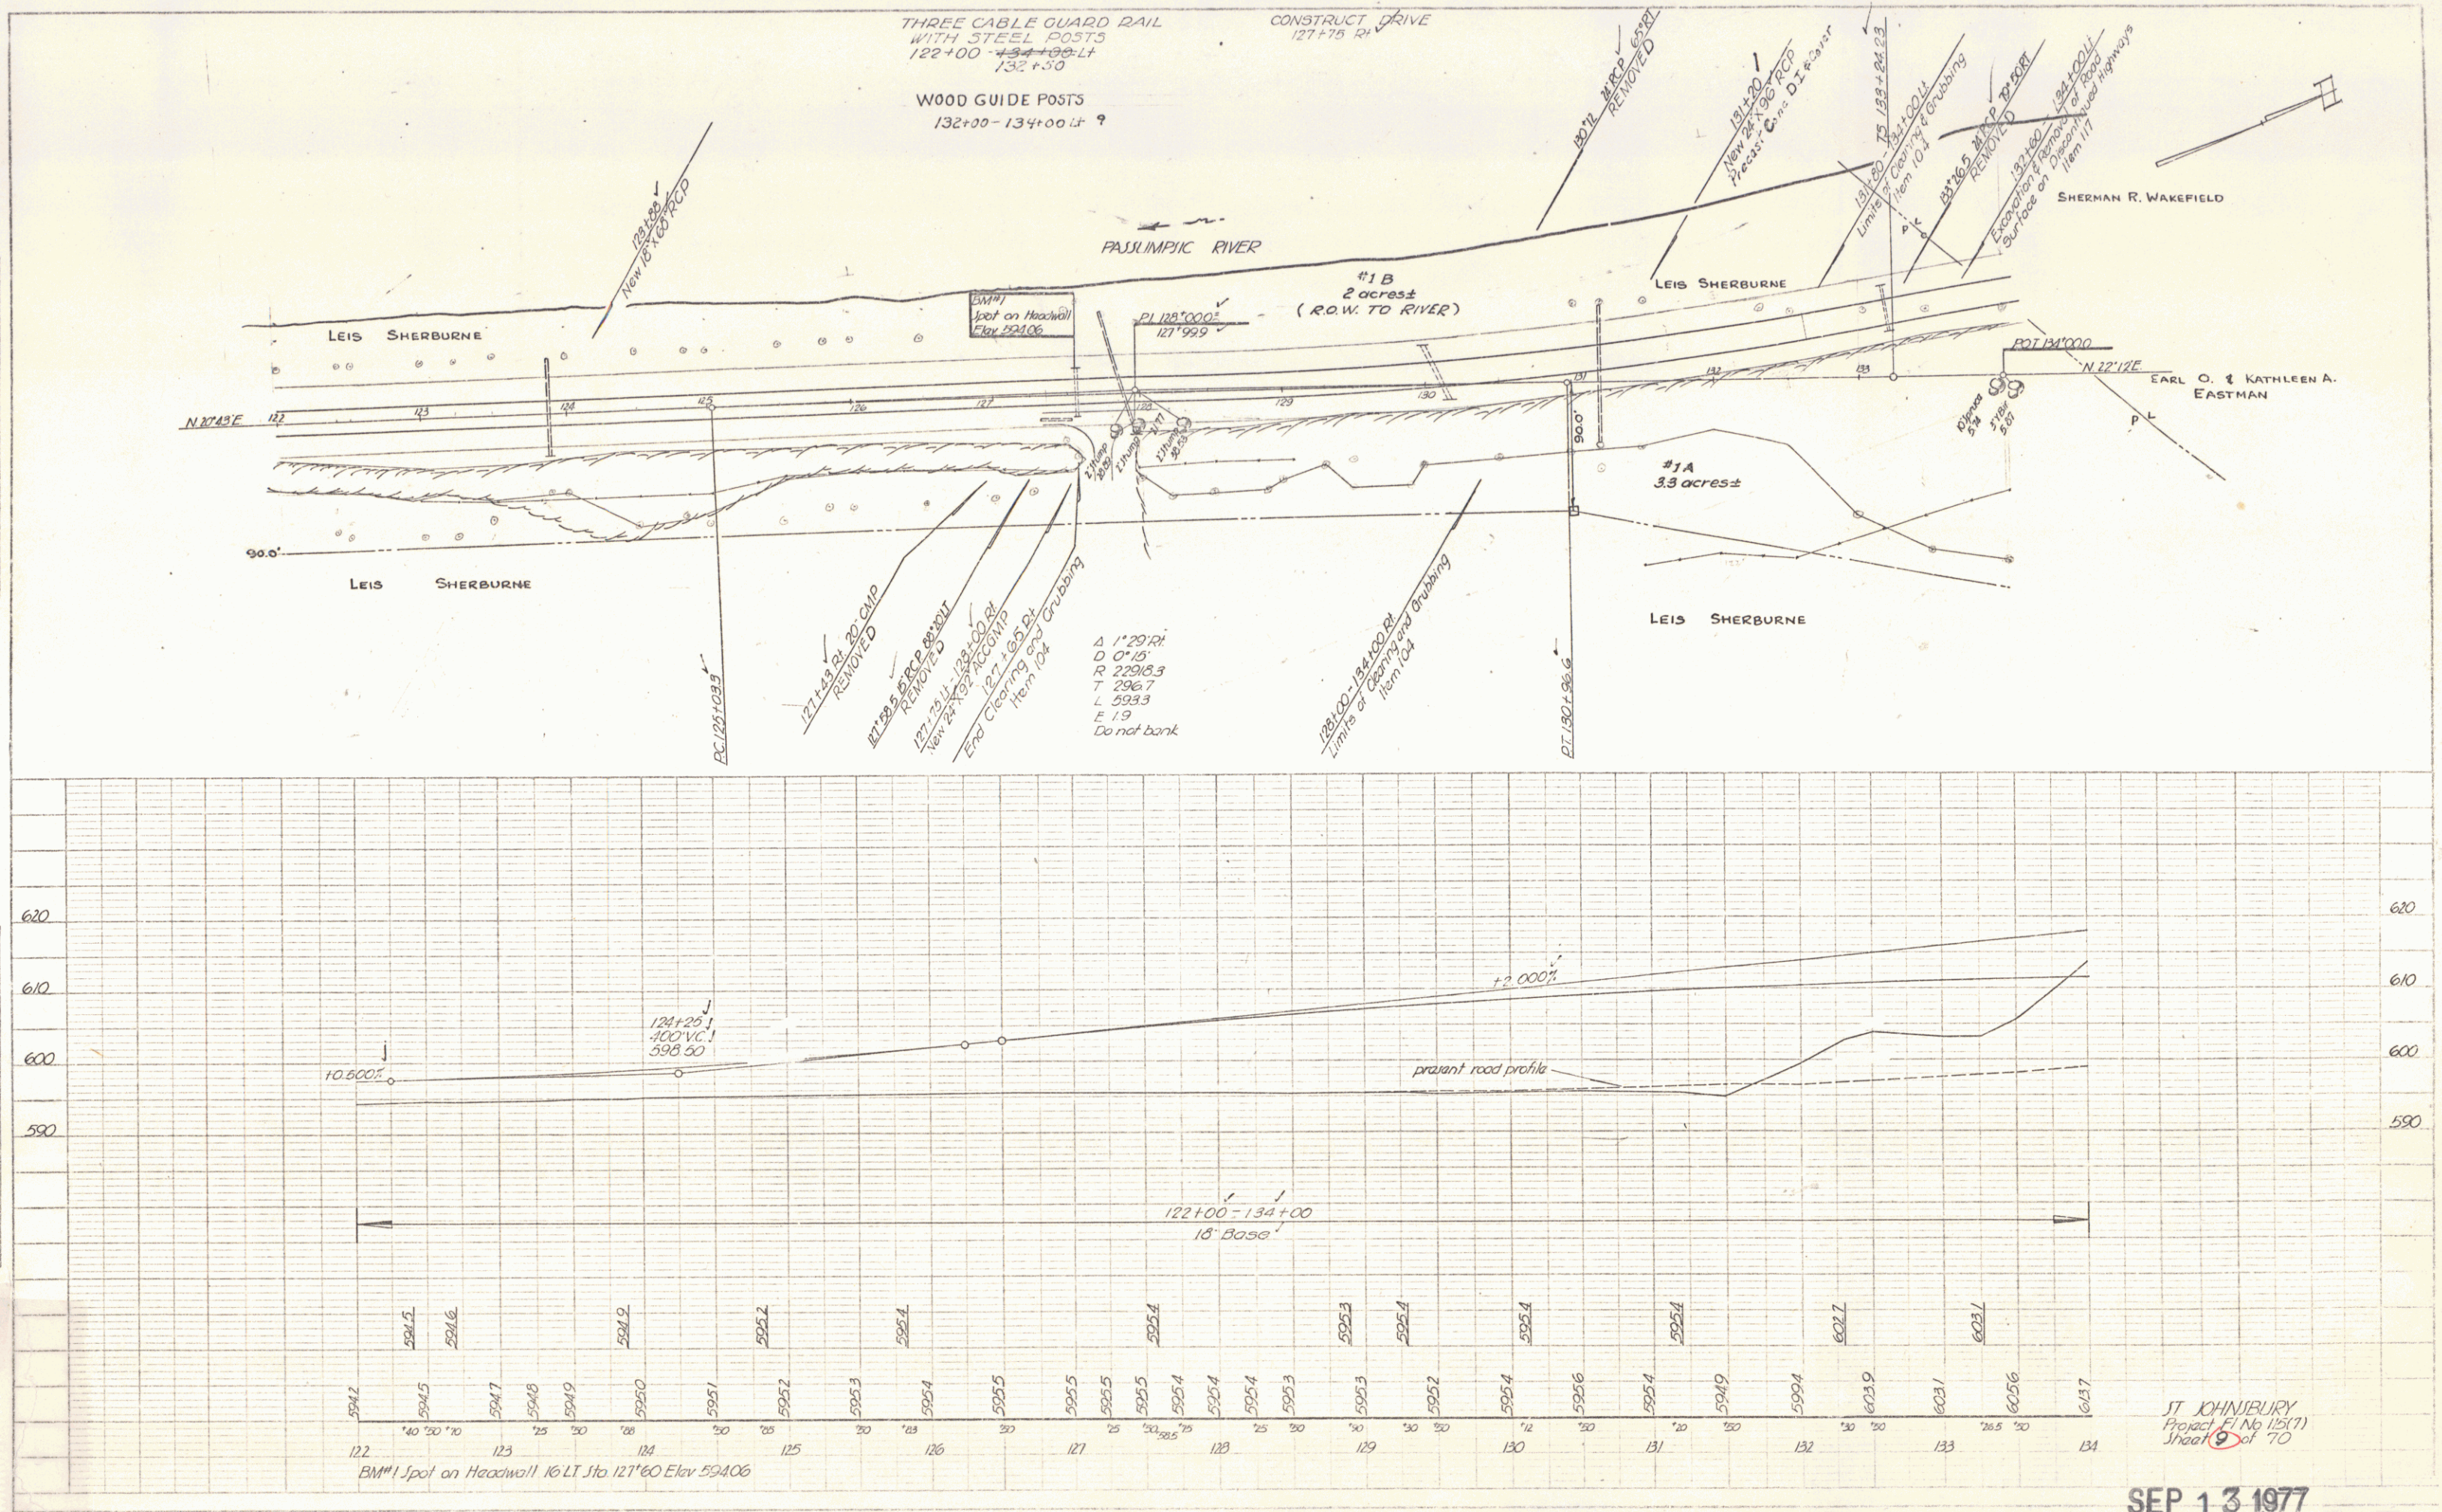

SEP 13 1977

JT JOHNIEURY  
 Project #1 No 125(1)  
 Sheet 9 of 70