


REMOVAL AND DISPOSAL
OF GUARD RAIL
153+37 LT ~ 157+00 LT
APP. 9+16 LT ~ 11+38 LT

STEEL BEAM GUARD RAIL
155+75.5 LT ~ 157+00 LT
APP. 9+06 LT ~ 10+27 LT

EROSION MATTING
Surv 153+50 LT ~ Rev 156+05 LT

Construct Drive
VT 104 App 8+20
(Match Existing)

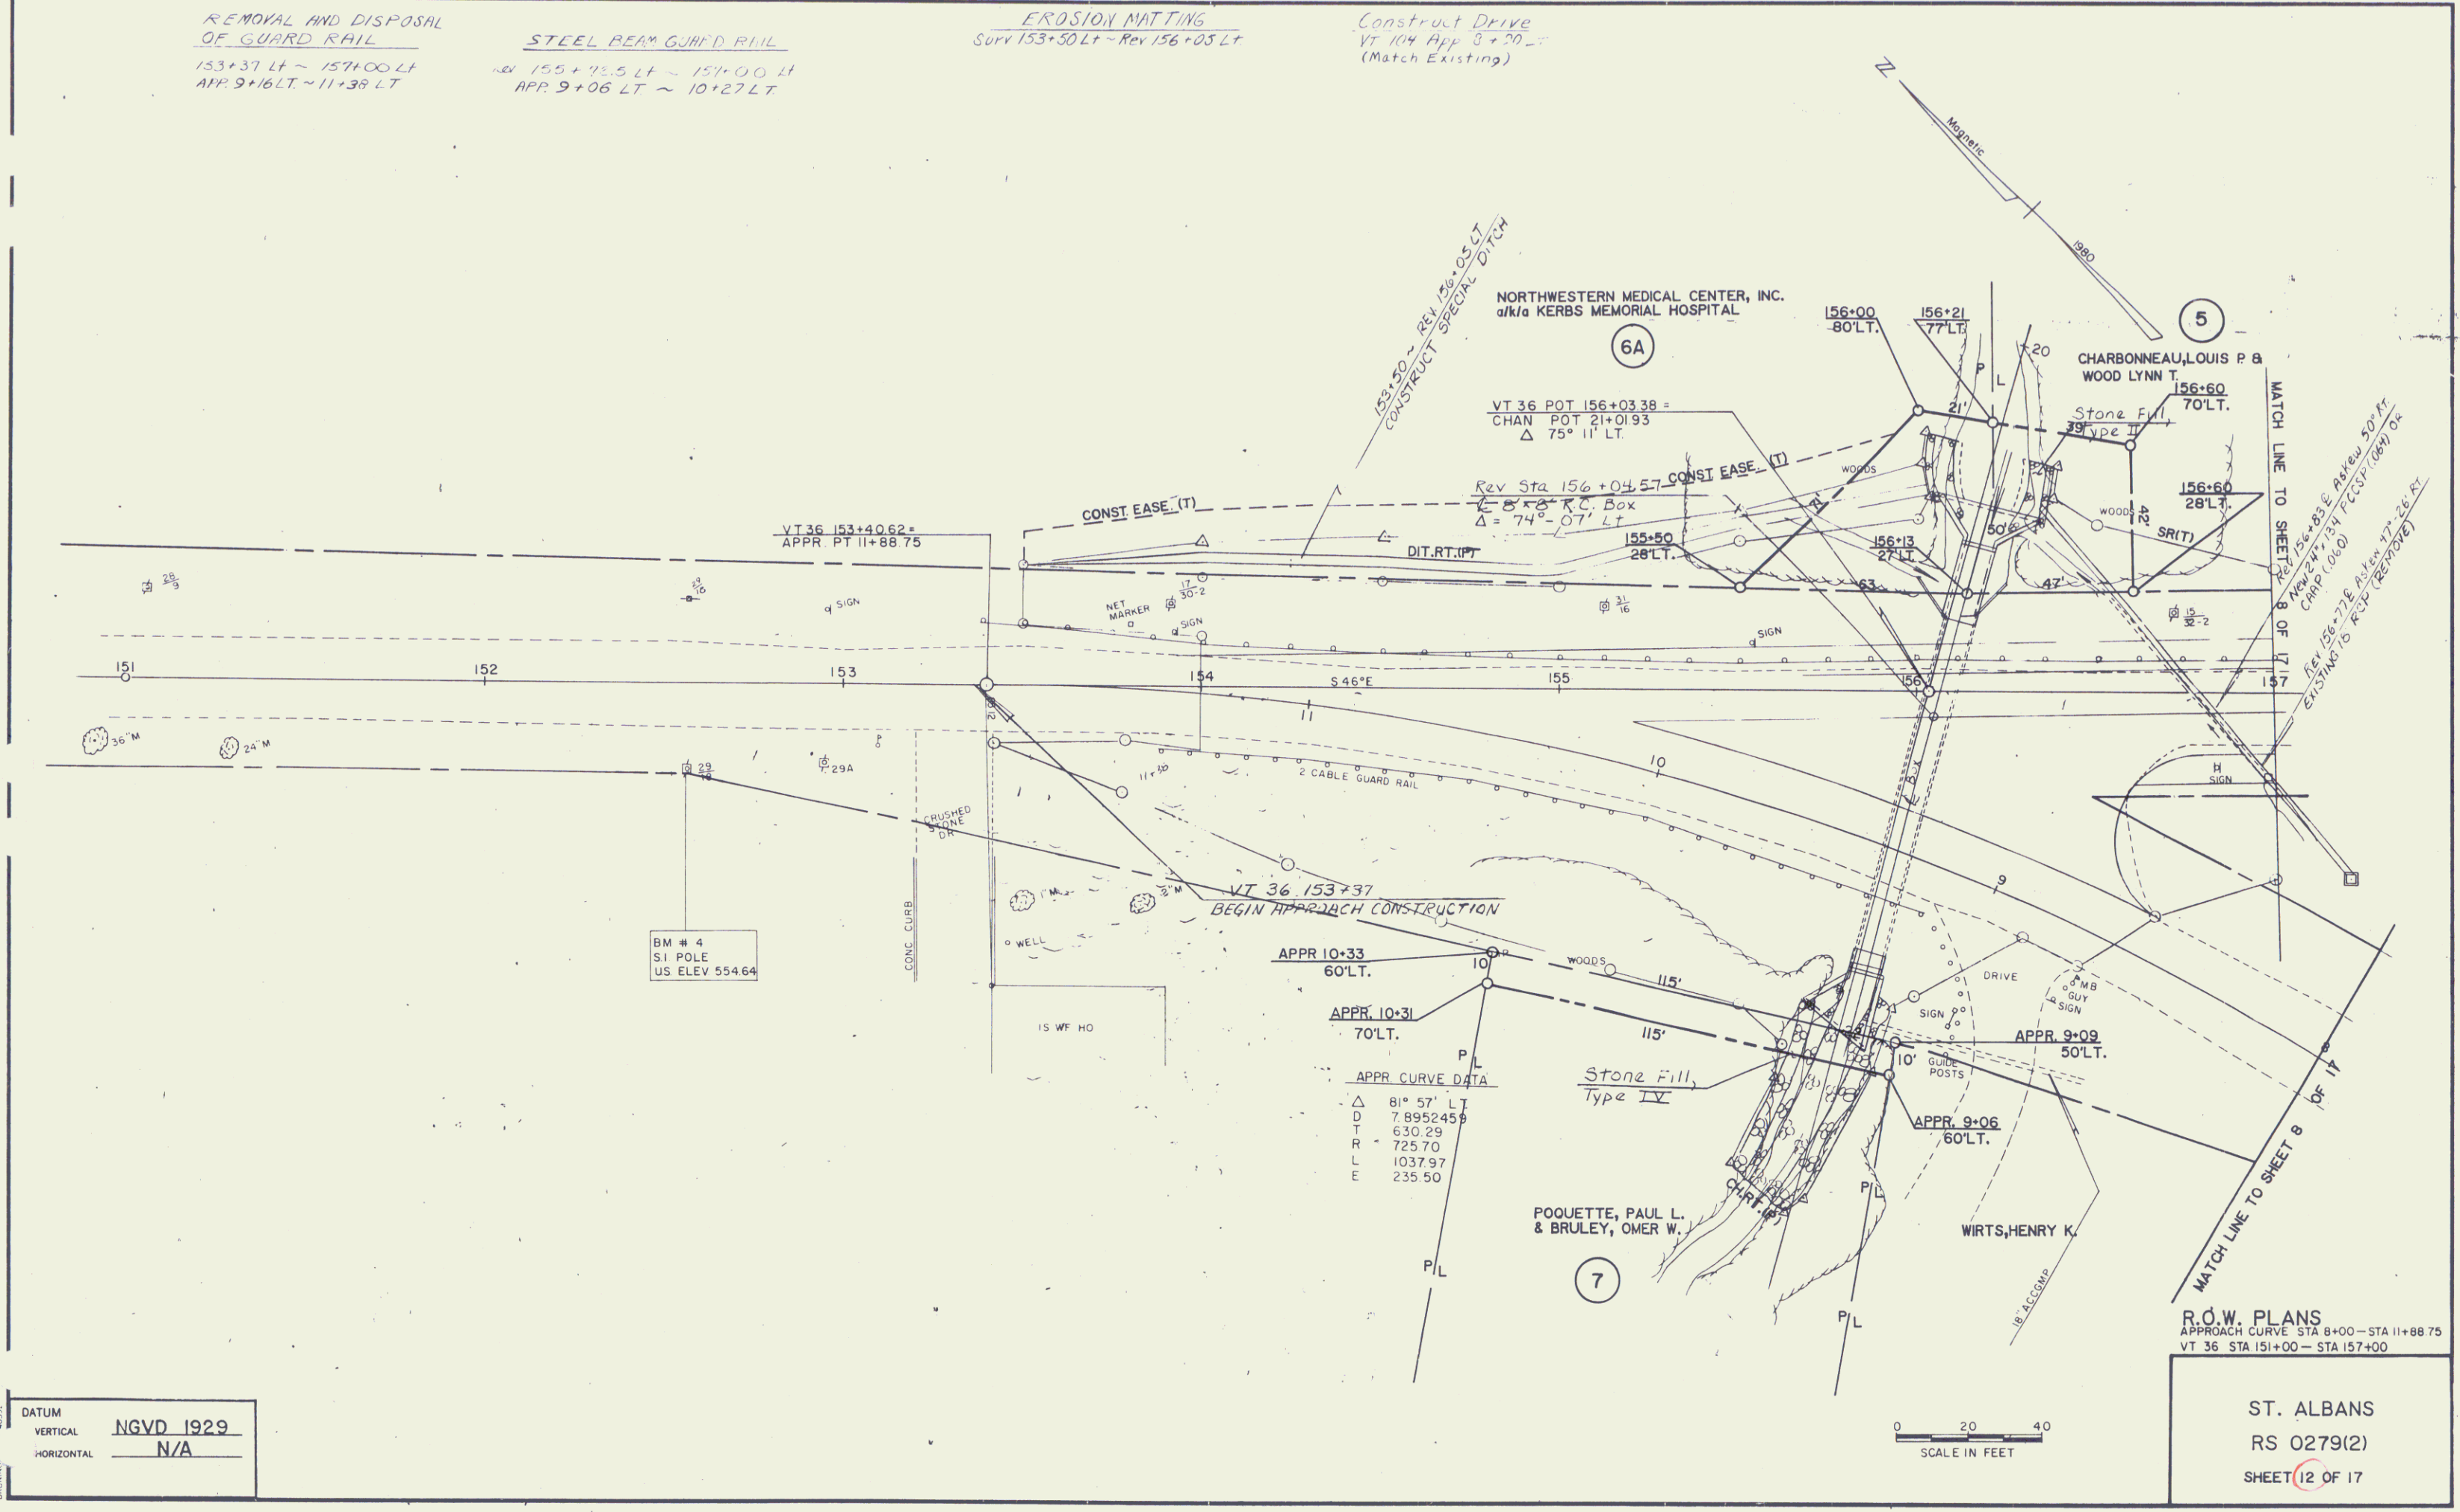

BM # 4
S.I. POLE
US. ELEV. 554.64

APPR CURVE DATA

Δ	81° 57' LT
D	7.8952459
T	630.29
R	725.70
L	1037.97
E	235.50

R.O.W. PLANS
APPROACH CURVE STA 8+00 - STA 11+88.75
VT 36 STA 151+00 - STA 157+00

DATUM
VERTICAL NGVD 1929
HORIZONTAL N/A



ST. ALBANS
RS 0279(2)
SHEET 12 OF 17