


Construct Drive
 VT 36 Rev 158+33 LT
 161+41 RT
 161+65 RT
 162+62 RT
 VT 104 115+85 LT
 116+07 RT
 118+72 LT

REMOVAL AND DISPOSAL OF GUARD RAIL
 VT 36 REV 157+00 LT - REV 157+43 LT
 VT 104 113+50 LT - 113+57 LT
 VT 104 116+09 LT - 117+39 LT
 CONSTRUCT WAREHOUSE ENTRANCE
 162+50 RT

STEEL BEAM GUARD RAIL
 VT 36 REV 157+00 LT - REV 157+80.5 LT
 VT 104 116+06 LT - 117+36 LT

Bituminous Concrete Curb
 Type A
 VT 36 158+48 F - VT 104 118+38 LT
 VT 104 119+02 RT - VT 36 161+04 LT

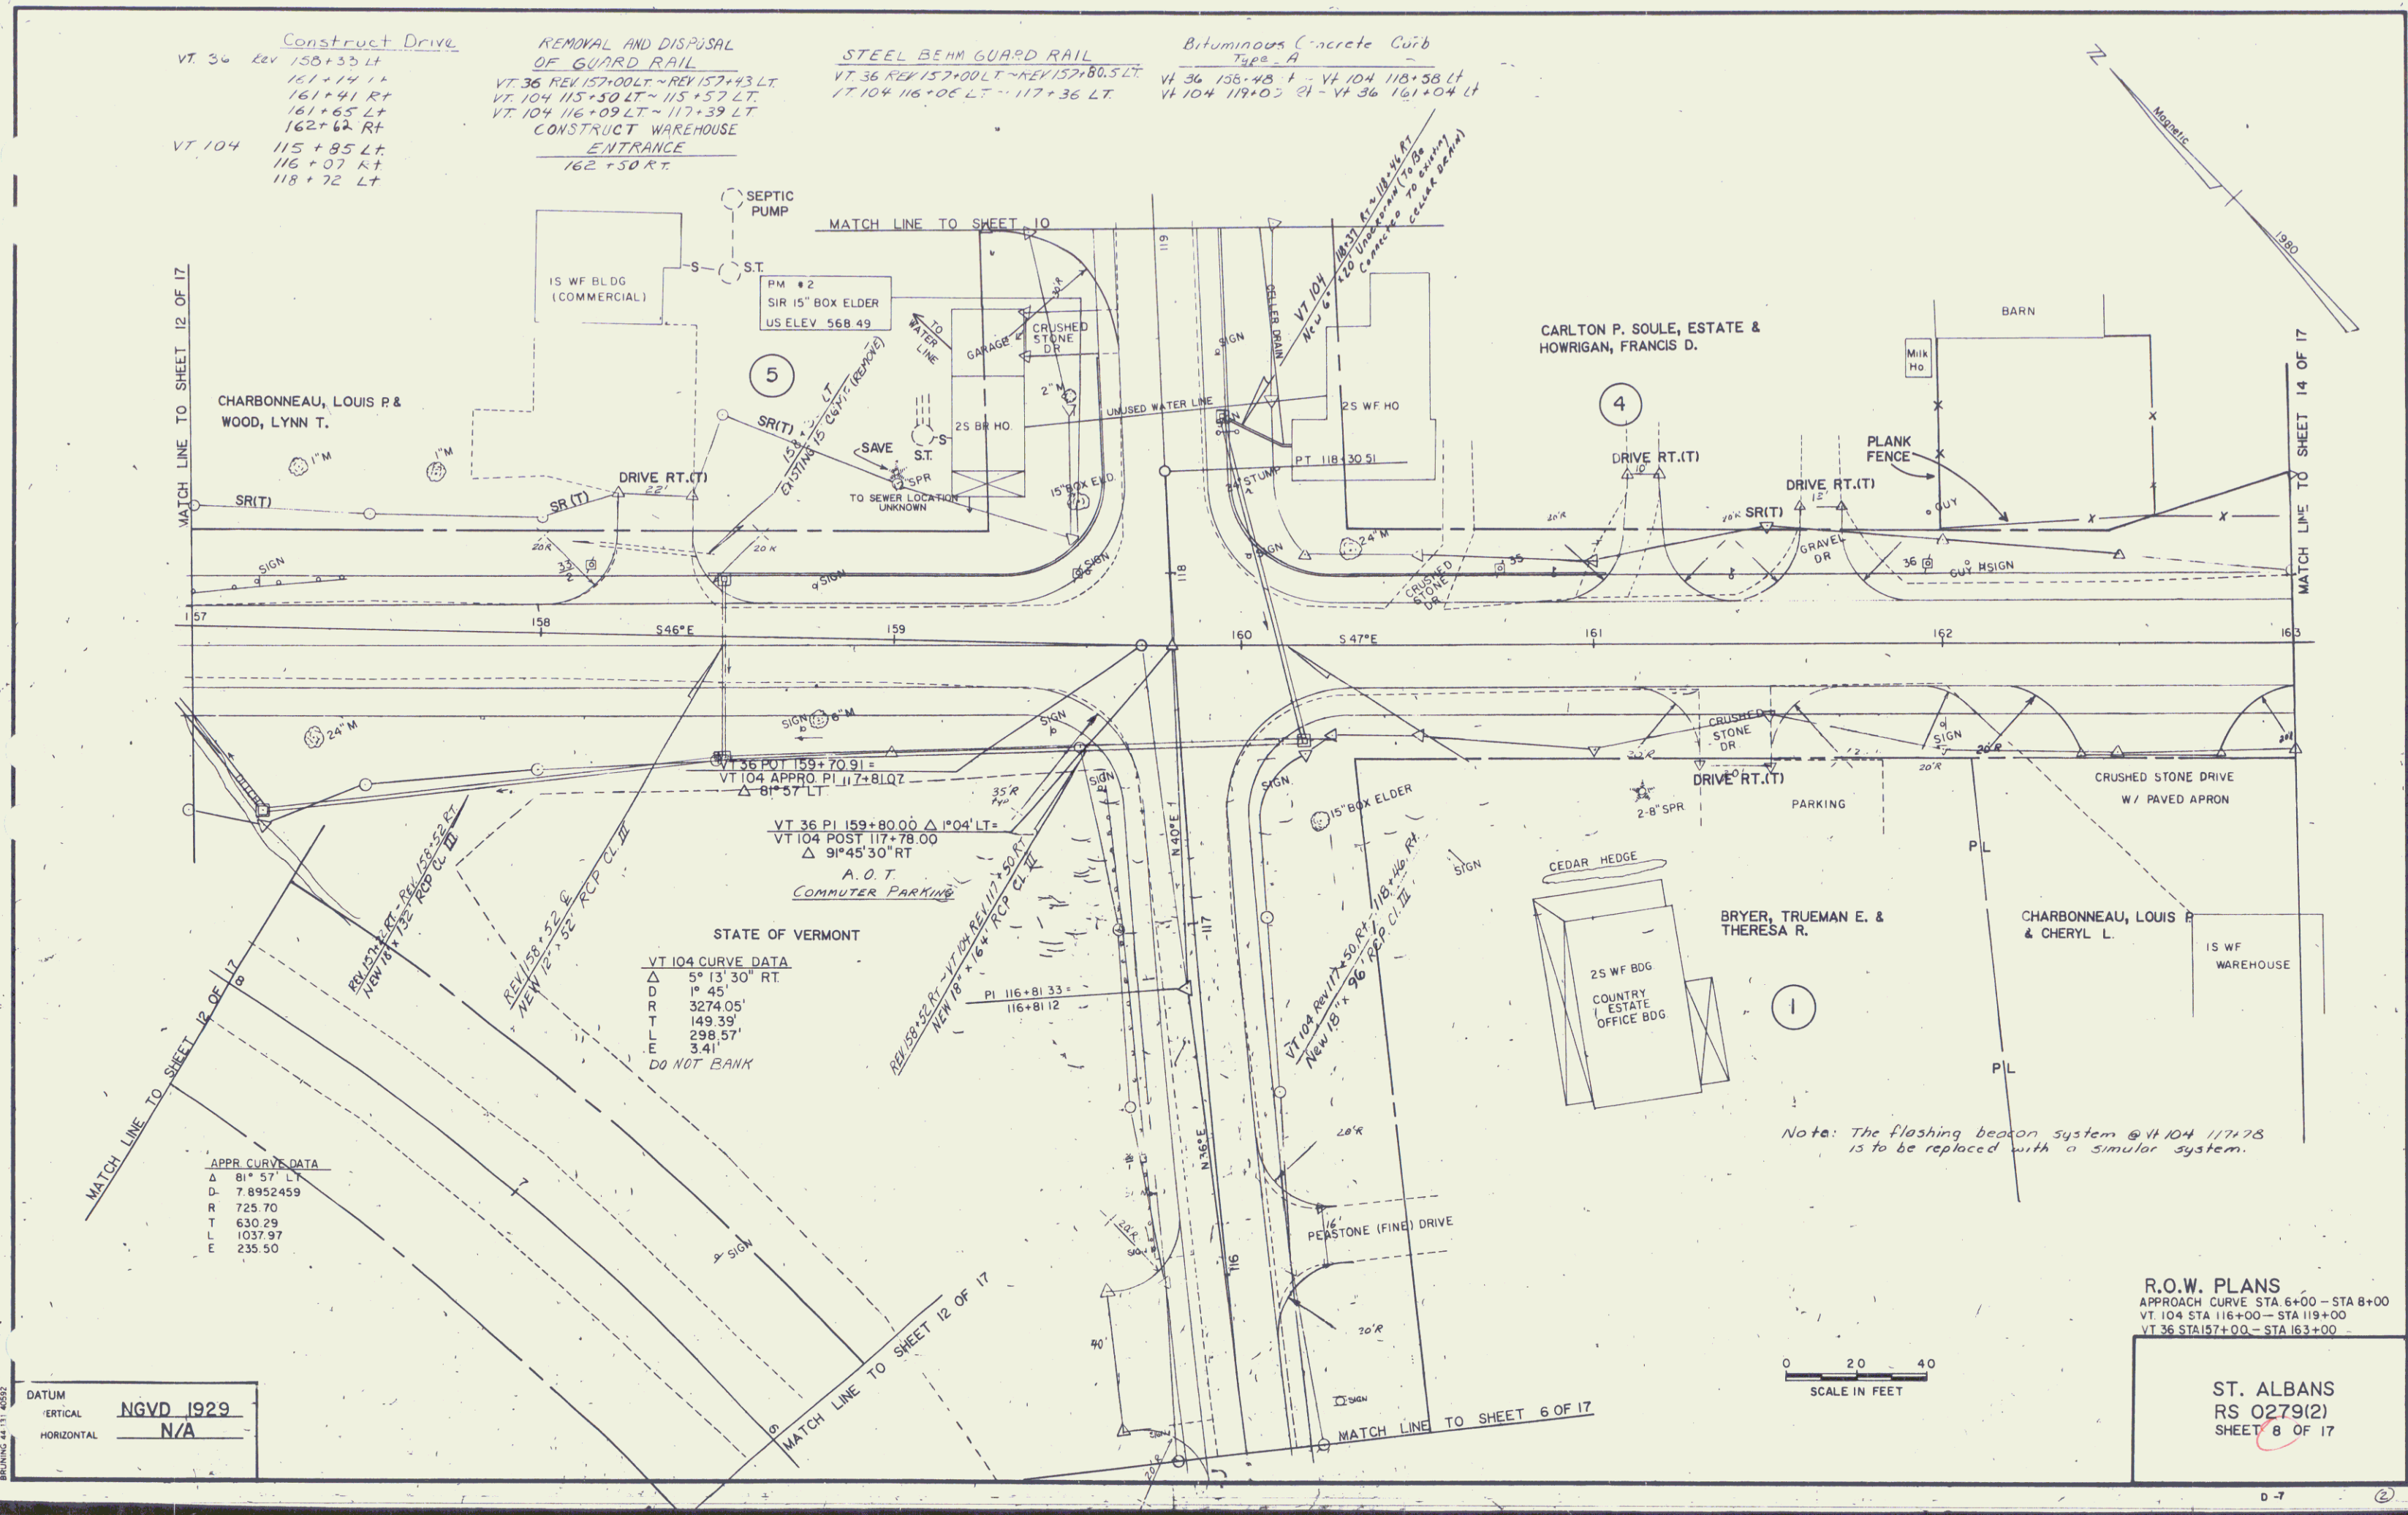

MATCH LINE TO SHEET 12 OF 17

MATCH LINE TO SHEET 14 OF 17

MATCH LINE TO SHEET 12 OF 17

MATCH LINE TO SHEET 12 OF 17

MATCH LINE TO SHEET 6 OF 17

APPR CURVE DATA

Δ	81° 57' LT
D	7.8952459
R	725.70
T	630.29
L	1037.97
E	235.50

STATE OF VERMONT
 VT 104 CURVE DATA


Δ	5° 13' 30" RT
D	1° 45'
R	3274.05'
T	149.39'
L	298.57'
E	3.41'

DO NOT BANK

Note: The flashing beacon system @ VT 104 117+78 is to be replaced with a similar system.

DATUM

VERTICAL	NGVD 1929
HORIZONTAL	N/A

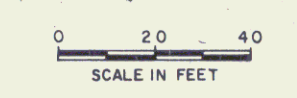

R.O.W. PLANS
 APPROACH CURVE STA 6+00 - STA 8+00
 VT 104 STA 116+00 - STA 119+00
 VT 36 STA 157+00 - STA 163+00


ST. ALBANS
 RS 0279(2)
 SHEET 8 OF 17

REMOVAL AND DISPOSAL
OF GUARD RAIL
153+37 LT ~ 157+00 LT
APP. 9+16 LT ~ 11+38 LT

STEEL BEAM GUARD RAIL
155+75.5 LT ~ 157+00 LT
APP. 9+06 LT ~ 10+27 LT

EROSION MATTING
Surv 153+50 LT ~ Rev 156+03 LT

Construct Drive
VT 104 App 8+20
(Match Existing)

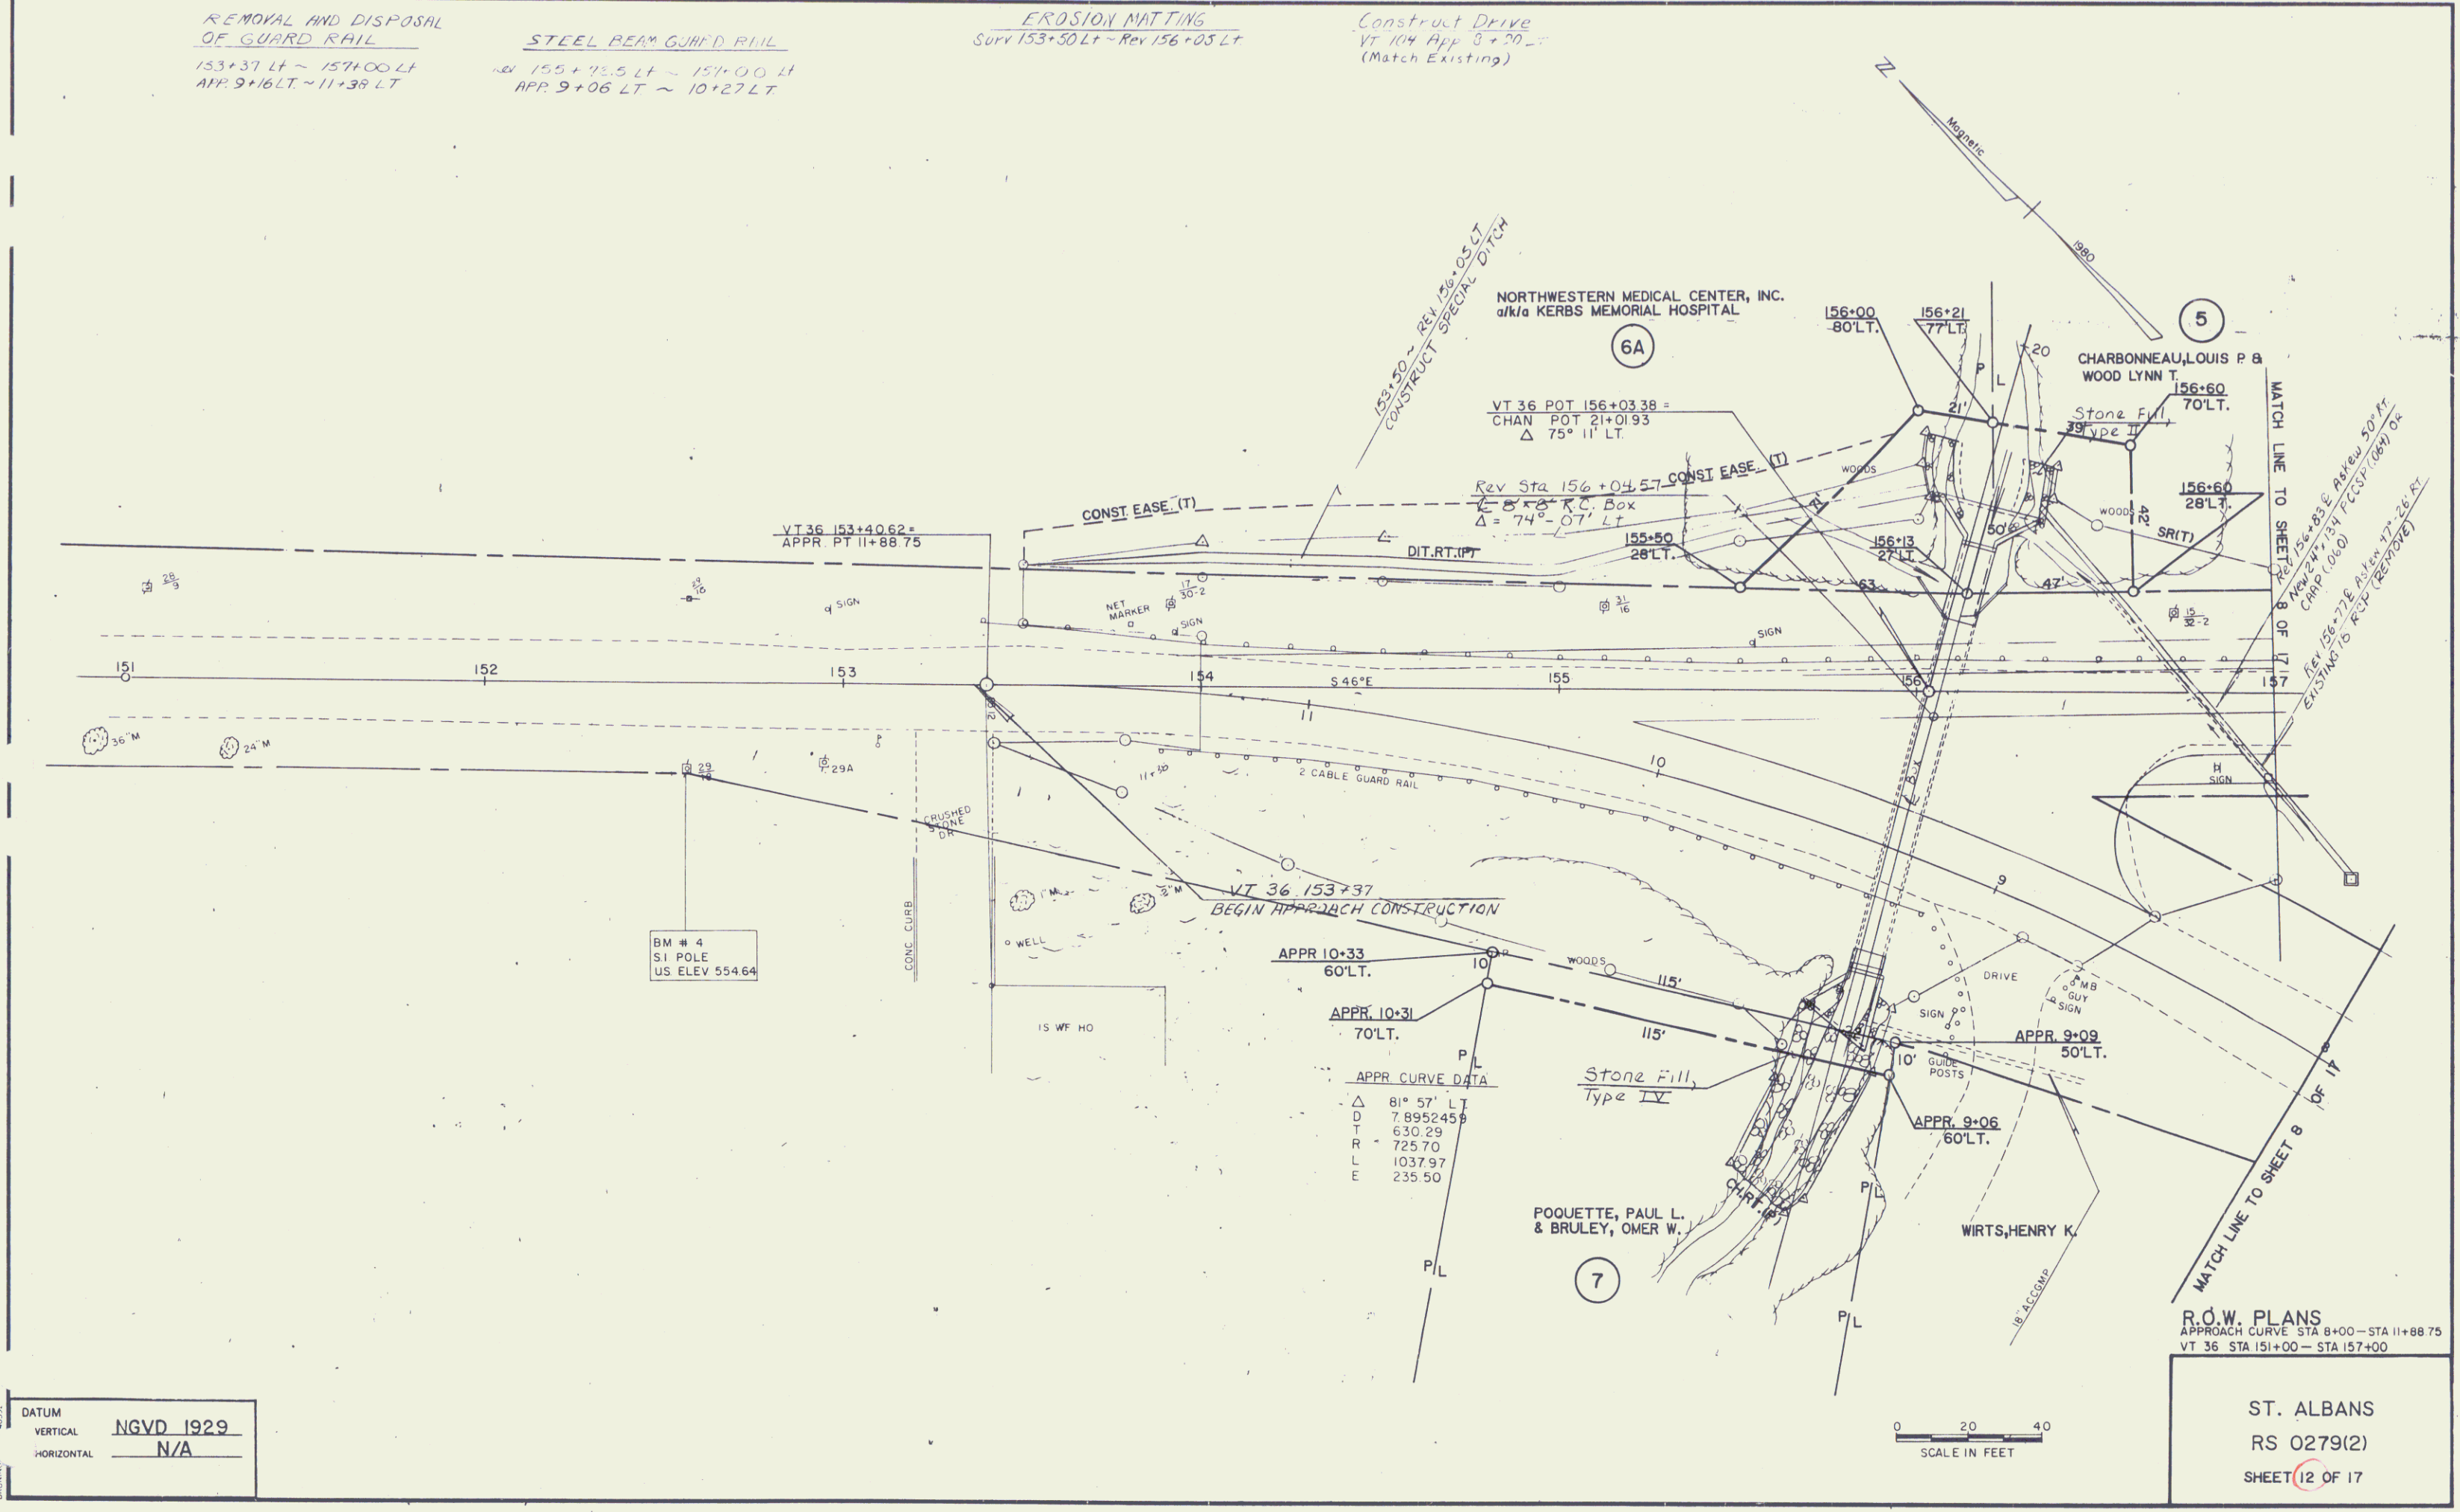

BM # 4
S.I. POLE
US. ELEV. 554.64

APPR CURVE DATA

Δ	81° 57' LT
D	7.8952459
T	630.29
R	725.70
L	1037.97
E	235.50

R.O.W. PLANS
APPROACH CURVE STA 8+00 - STA 11+88.75
VT 36 STA 151+00 - STA 157+00

DATUM
VERTICAL NGVD 1929
HORIZONTAL N/A



ST. ALBANS
RS 0279(2)
SHEET 12 OF 17


REMOVING & RESETTING
GUARD RAIL
163+99 ~ 167+00 RT
164+13.5 ~ 167+00 LT

165+00 ~ 167+00
Remove existing Bituminous material
and add Subbase, Base, and surface
courses as necessary.


CONSTRUCT DRIVE
163+25 RT

TREATED TIMBER CURB
166+41 LT ~ 167+00 LT
166+41 RT ~ 167+00 RT

CHANGING ELEVATION OF DROP INLETS
CATCH BASINS OR MANHOLES
166+41 LT
166+41 RT

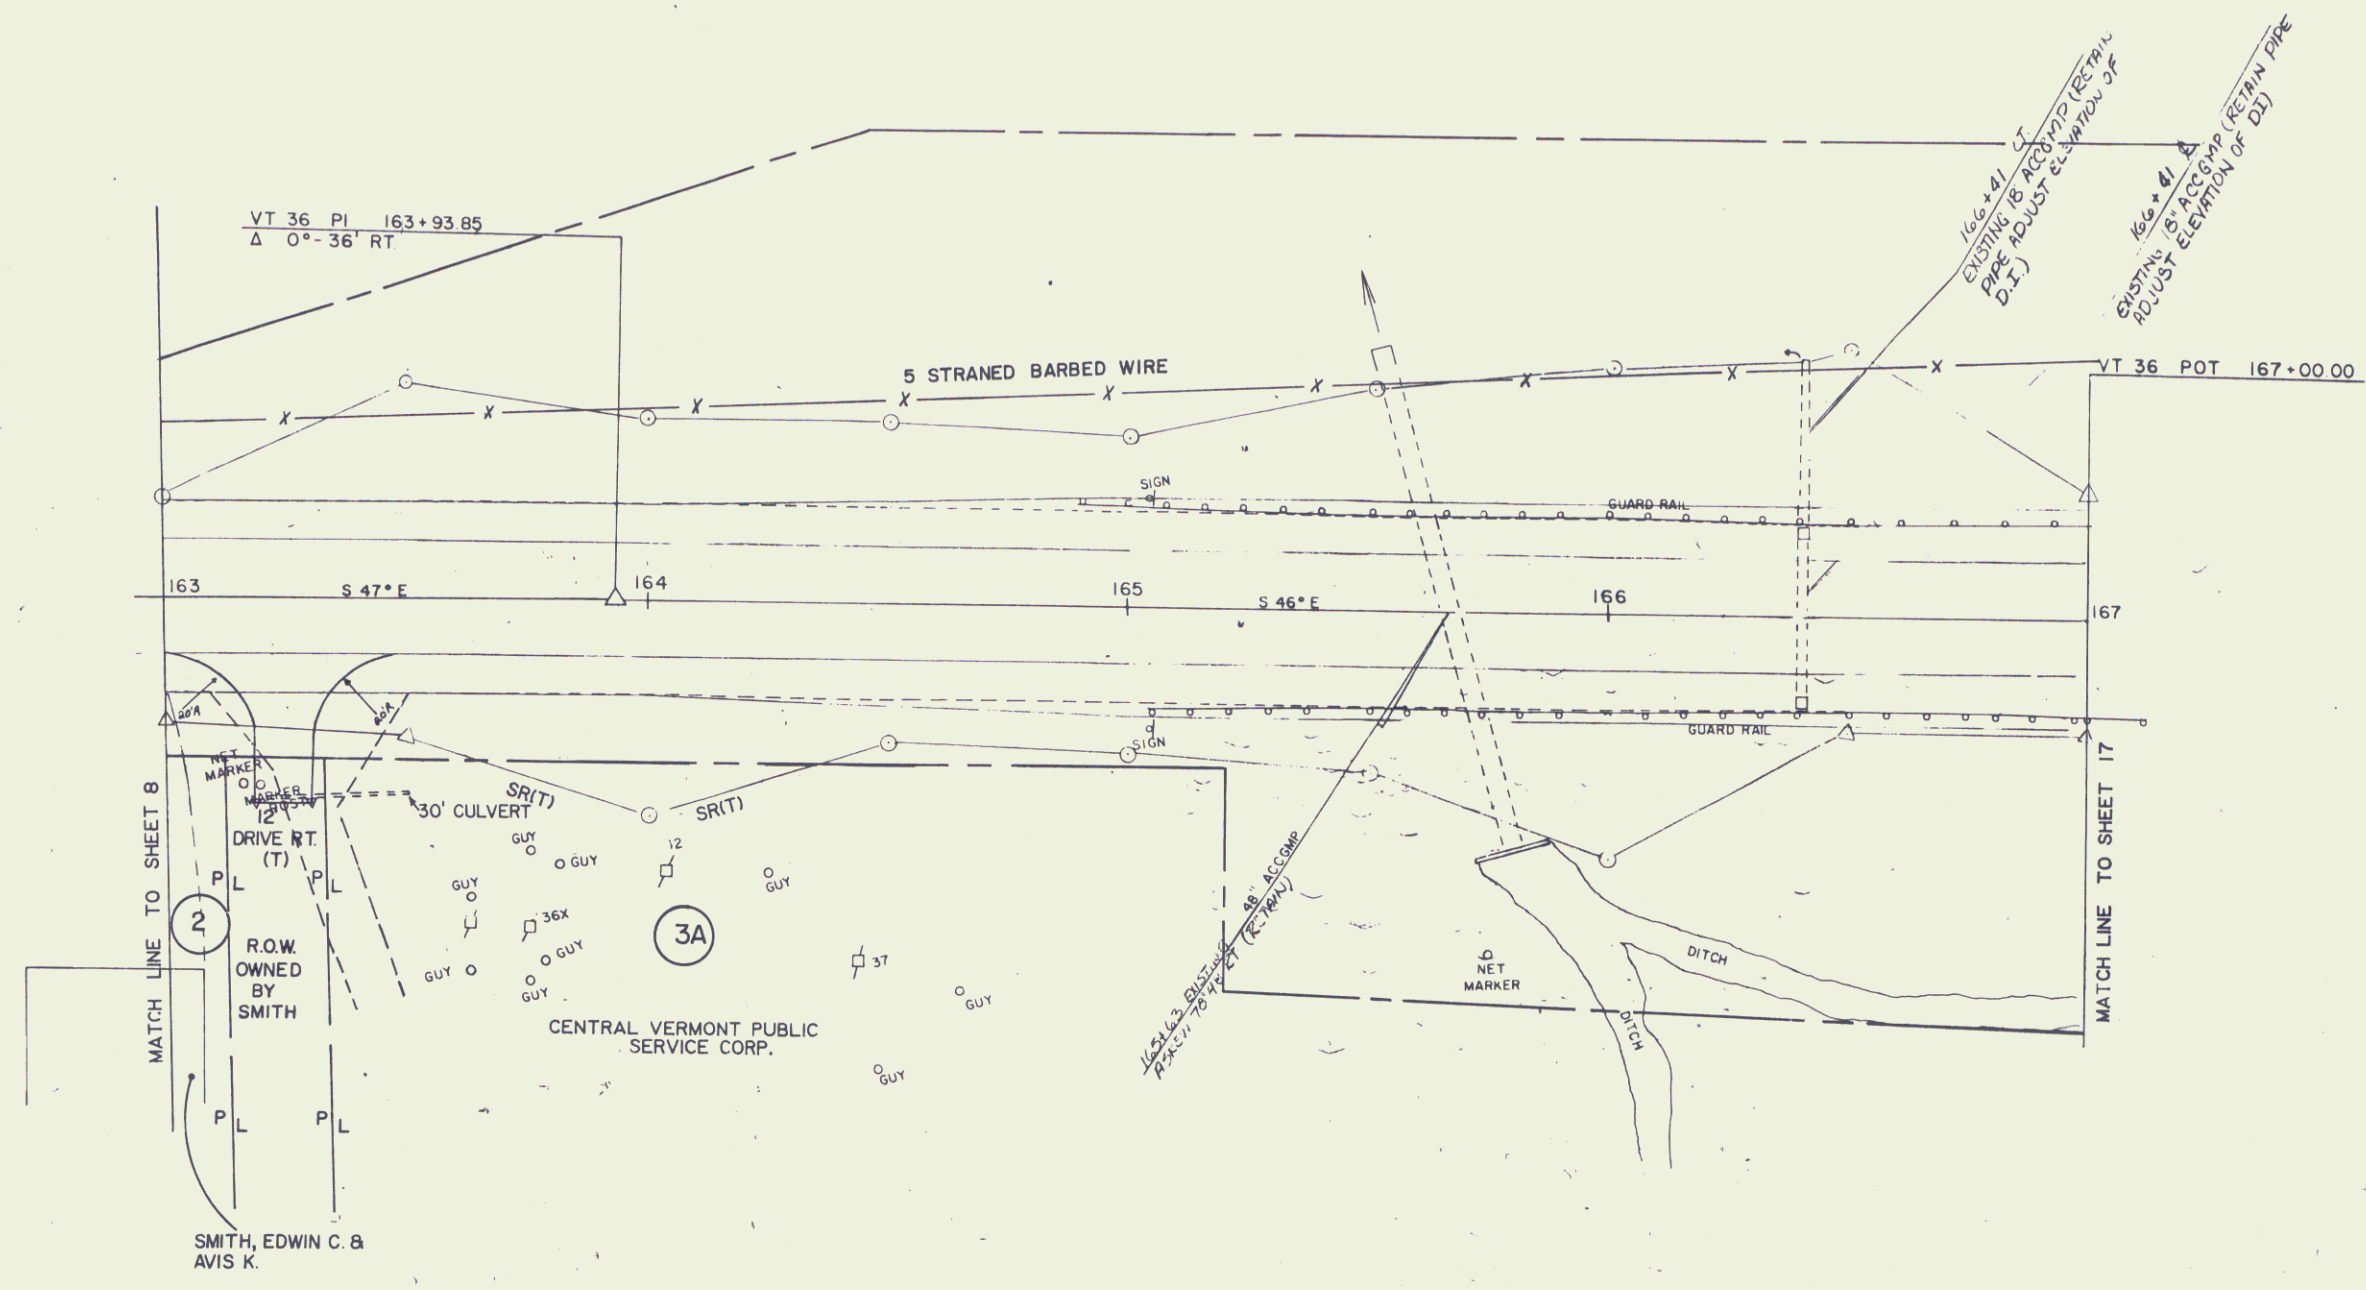

DATUM
VERTICAL NGVD 1929
HORIZONTAL N/A

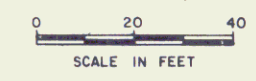

R.O.W. PLANS
VT 36 STA 163+00 - STA 167+00

ST. ALBANS
RS 0279(2)
SHEET 14 OF 17