

MATCH LINE SHEET 1

MATCH LINE SHEET 3

PIN ID# 16x605

**MONUMENT DETAIL TABLE**


MON. NO.	COORDINATE	STATION	DESCRIPTION
2516	N 848987.18 E 1489931.87	9+91.32 49.50' RIGHT	UNMONUMENTED POINT
2517	N 849001.69 E 1489833.94	9+91.32 49.50' LEFT	5/8" REBAR SET AT GRADE
2561	N 848996.97 E 1489933.25	10+00.85 49.50' RIGHT	5/8" REBAR SET AT GRADE
2518	N 849590.75 E 1490016.82	16+00.48 49.50' RIGHT	FENO TYPE MONUMENT SET AT GRADE
2519	N 849604.55 E 1489918.79	16+00.48 49.50' LEFT	FENO TYPE MONUMENT SET AT GRADE

**MONUMENT DETAIL TABLE**

MON. NO.	COORDINATE	STATION	DESCRIPTION
10001	N 849078.13 E 1489844.04	10+68.78 50.15' LEFT	5/8" REBAR FOUND 0.7' ABOVE GRADE
10007	N 849591.16 E 1490018.37	16+01.10 50.98' RIGHT	5/8" REBAR FOUND AT GRADE W/CAP MARKED "CROSS CONSTRUCTION"


NATHAN P. NADEAU, LS

I CERTIFY THAT THIS IS A CORRECT SURVEY TO THE BEST OF MY KNOWLEDGE BASED UPON AN EDM TOTAL STATION AND GPS FIELD SURVEY AND TOWN OF SAINT ALBANS, TOWN OF SWANTON AND REFERENCED LAND AND HIGHWAY RECORDS. THIS PLAT MEETS THE REQUIREMENTS OF 27 VSA SECTION 1403.

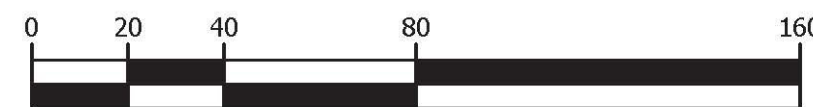

SCALE IN FEET

© 2017  
**horizons**  
Engineering Inc.  
All rights reserved



17 Sunset Terrace  
Newport, Vermont 05855  
Phone 802.334.6434 - Fax 802.334.5602

STATUTORY SURVEY PREPARED FOR

**VERMONT AGENCY  
OF TRANSPORTATION**

1 NATIONAL LIFE DRIVE  
MONTPELIER, VT 05633-5001

OF U.S. ROUTE 7  
TOWN OF ST. ALBANS, TOWN OF SWANTON  
FRANKLIN COUNTY, VERMONT

DATE: 1/12/2017	PROJECT #: 15522
SURV'D BY: JN, AN, JB	DRAWN BY: JN, NN
CHECK'D BY: AN	SCALE: 1"=40'

SHEET 2 OF 43

HORIZONS ENGINEERING INC. CERTIFIES THAT THIS DRAWING WAS PRODUCED AS AN ORIGINAL INK ON MYLAR SIGNATURE