

MATCH LINE SHEET 3


MATCH LINE SHEET 5

PIN ID# 16x605

HORIZONS ENGINEERING, INC. CERTIFIES THAT THIS DRAWING WAS PRODUCED AS AN ORIGINAL INK ON MYLAR


SIGNATURE

MONUMENT DETAIL TABLE			
MON. NO.	COORDINATE	STATION	DESCRIPTION
2522	N 850575.31 E 1490161.92	25+96.27 49.50' RIGHT	FENO TYPE MONUMENT SET AT GRADE
2523	N 850590.25 E 1490064.06	25+96.27 49.50' LEFT	FENO TYPE MONUMENT SET AT GRADE
2524	N 851201.05 E 1490257.43	32+29.25 49.50' RIGHT	5/8" REBAR SET AT GRADE
2525	N 851215.98 E 1490159.56	32+29.25 49.50' LEFT	5/8" REBAR SET AT GRADE
10004	N 850629.84 E 1490069.84	26+36.28 49.76' LEFT	5/8" REBAR FOUND 0.2' ABOVE GRADE W/CAP MARKED "060709"

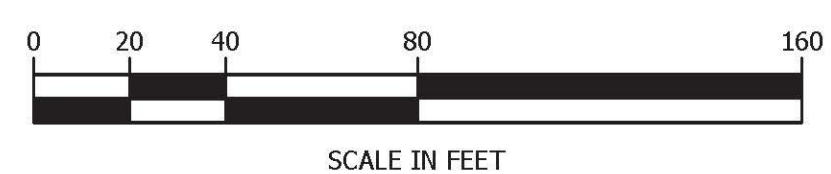

NATHAN P. NADEAU, LS
 I CERTIFY THAT THIS IS A CORRECT SURVEY TO THE BEST OF MY KNOWLEDGE BASED UPON AN EDM TOTAL STATION AND GPS FIELD SURVEY AND TOWN OF SAINT ALBANS, TOWN OF SWANTON AND REFERENCED LAND AND HIGHWAY RECORDS. THIS PLAT MEETS THE REQUIREMENTS OF 27 VSA SECTION 1403.

© 2017
 horizons Engineering
 All rights reserved



17 Sunset Terrace
 Newport, Vermont 05855
 Phone 802.334.6434 - Fax 802.334.5602

STATUTORY SURVEY PREPARED FOR
VERMONT AGENCY OF TRANSPORTATION
 1 NATIONAL LIFE DRIVE
 MONTPELIER, VT 05633-5001

OF U.S. ROUTE 7
 TOWN OF ST. ALBANS, TOWN OF SWANTON
 FRANKLIN COUNTY, VERMONT

DATE: 1/12/2017	PROJECT #: 15522
SURV'D BY: JN, AN, JB	DRAWN BY: JN, NN
CHECK'D BY: AN	SCALE: 1"=40'

SHEET 4 OF 43

