


MONUMENT DETAIL TABLE			
MON. NO.	COORDINATE	STATION	DESCRIPTION
2526	N 851445.79 E 1490227.79	31+51.89 49.50' RIGHT	5/8" REBAR SET AT GRADE
2529	N 851407.89 E 1490136.32	31+51.89 49.50' LEFT	5/8" REBAR SET AT GRADE
2528	N 851525.30 E 1490194.87	35+36.79 49.50' RIGHT	5/8" REBAR SET AT GRADE
2529	N 851485.25 E 1490104.30	35+36.79 49.50' LEFT	UNMONUMENTED POINT
2560	N 851555.98 E 1490070.99	36+16.15 49.50' LEFT	5/8" REBAR SET AT GRADE
2530	N 852058.76 E 1489943.62	41+25.28 49.50' RIGHT	FENO TYPE MONUMENT SET AT GRADE
2531	N 852016.57 E 1489854.05	41+25.28 49.50' LEFT	FENO TYPE MONUMENT SET AT GRADE




NATHAN P. NADEAU, LS

I CERTIFY THAT THIS IS A CORRECT SURVEY TO THE BEST OF MY KNOWLEDGE BASED UPON AN EDM TOTAL STATION AND GPS FIELD SURVEY AND TOWN OF SAINT ALBANS, TOWN OF SWANTON AND REFERENCED LAND AND HIGHWAY RECORDS. THIS PLAT MEETS THE REQUIREMENTS OF 27 VSA SECTION 1403.

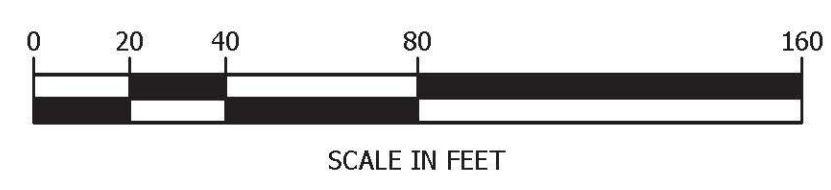

PIN ID# 16x605



17 Sunset Terrace  
Newport, Vermont 05855  
Phone 802.334.6434 - Fax 802.334.5602

STATUTORY SURVEY PREPARED FOR

**VERMONT AGENCY OF TRANSPORTATION**

1 NATIONAL LIFE DRIVE  
MONTPELIER, VT 05633-5001

OF U.S. ROUTE 7  
TOWN OF ST. ALBANS, TOWN OF SWANTON  
FRANKLIN COUNTY, VERMONT

DATE:	PROJECT #:
1/12/2017	15522
SURV'D BY:	DRAWN BY:
JN, AN, JB	JN, NN
CHECK'D BY:	SCALE:
AN	1"=40'

SHEET 5 OF 43

HORIZONS ENGINEERING, INC. CERTIFIES THAT THIS DRAWING WAS PRODUCED AS AN ORIGINAL INK ON MYLAR. SIGNATURE