


MONUMENT DETAIL TABLE			
MON. NO.	COORDINATE	STATION	DESCRIPTION
90	N 856414.78 E 1487942.03	89+19.97 49.50' RIGHT	5/8" REBAR SET AT GRADE
1875	N 856373.86 E 1487851.88	89+19.97 49.50' LEFT	5/8" REBAR SET 0.3' ABOVE GRADE
2509	N 856590.09 E 1487862.45	91+12.49 49.50' RIGHT	FENO TYPE MONUMENT SET 0.5' ABOVE GRADE
2508	N 856549.17 E 1487772.31	91+12.49 49.50' LEFT	FENO TYPE MONUMENT SET 0.5' ABOVE GRADE



NATHAN P. NADEAU, LS
 I CERTIFY THAT THIS IS A CORRECT SURVEY TO THE BEST OF MY KNOWLEDGE BASED UPON AN EDM TOTAL STATION AND GPS FIELD SURVEY AND TOWN OF SAINT ALBANS, TOWN OF SWANTON AND REFERENCED LAND AND HIGHWAY RECORDS. THIS PLAT MEETS THE REQUIREMENTS OF 27 VSA SECTION 1403.

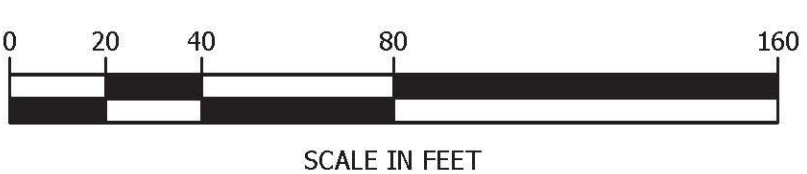

PIN ID# 16x605

17 Sunset Terrace
Newport, Vermont 05855
Phone 802.334.6434 - Fax 802.334.5602

STATUTORY SURVEY PREPARED FOR

VERMONT AGENCY OF TRANSPORTATION

1 NATIONAL LIFE DRIVE
MONTPELIER, VT 05633-5001

OF U.S. ROUTE 7
TOWN OF ST. ALBANS, TOWN OF SWANTON
FRANKLIN COUNTY, VERMONT

DATE: 1/12/2017	PROJECT #: 15522
SURV'D BY: JN, AN, JB	DRAWN BY: JN, NN
CHECK'D BY: AN	SCALE: 1"=40'

SHEET 11 OF 43

HORIZONS ENGINEERING INC. CERTIFIES THAT THIS DRAWING WAS PRODUCED AS AN ORIGINAL INK ON MYLAR
 SIGNATURE