

PIN ID# 16x605

horizons
Engineering Inc.

17 Sunset Terrace
Newport, Vermont 05855
Phone 802.334.6434 - Fax 802.334.5602

STATUTORY SURVEY PREPARED FOR


VERMONT AGENCY OF TRANSPORTATION

1 NATIONAL LIFE DRIVE
MONTPELIER, VT 05633-5001

OF U.S. ROUTE 7
TOWN OF ST. ALBANS, TOWN OF SWANTON
FRANKLIN COUNTY, VERMONT

DATE:	PROJECT #:
1/12/2017	15522
SURV'D BY:	DRAWN BY:
JN, AN, JB	JN, NN
CHECK'D BY:	SCALE:
AN	1"=40'
SHEET 15 OF 43	


MON. NO.	COORDINATE	STATION	DESCRIPTION
97	N 859218.12 E 1486664.51	120+00.23 49.50' RIGHT	FENO TYPE MONUMENT SET 0.3' ABOVE GRADE
1881	N 859176.28 E 1486574.78	120+00.23 49.50' LEFT	5/8" REBAR SET AT GRADE
98	N 859626.51 E 1486474.09	124+50.83 49.50' RIGHT	FENO TYPE MONUMENT SET 0.5' ABOVE GRADE
1882	N 859584.68 E 1486384.36	124+50.83 49.50' LEFT	5/8" REBAR SET AT GRADE

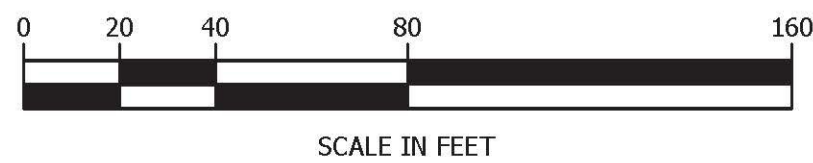

NATHAN P. NADEAU, LS

I CERTIFY THAT THIS IS A CORRECT SURVEY TO THE BEST OF MY KNOWLEDGE BASED UPON AN EDM TOTAL STATION AND GPS FIELD SURVEY AND TOWN OF SAINT ALBANS, TOWN OF SWANTON AND REFERENCED LAND AND HIGHWAY RECORDS. THIS PLAT MEETS THE REQUIREMENTS OF 27 VSA SECTION 1403.

© 2017
horizons
Engineering Inc.
All rights reserved

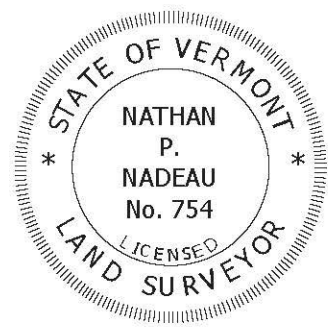

HORIZONS ENGINEERING INC. CERTIFIES THAT THIS DRAWING WAS PRODUCED AS AN ORIGINAL INK ON MYLAR SIGNATURE