


MONUMENT DETAIL TABLE			
MON. NO.	COORDINATE	STATION	DESCRIPTION
99	N 860192.96	130+75.83	FENO TYPE MONUMENT SET AT GRADE
	E 1486209.97	49.50' RIGHT	
1883	N 860151.13	130+75.83	FENO TYPE MONUMENT SET AT GRADE
	E 1486120.25	49.50' LEFT	
20602	N 860222.67	131+08.35	5/8" REBAR FOUND 1' ABOVE GRADE
	E 1486196.74	50.06' RIGHT	W/CAP MARKED "THETFORD 569"

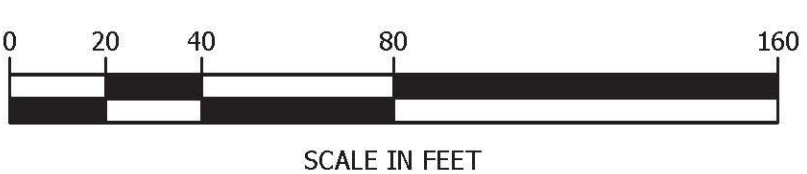

NATHAN P. NADEAU, LS  
 I CERTIFY THAT THIS IS A CORRECT SURVEY TO THE BEST OF MY KNOWLEDGE BASED UPON AN EDM TOTAL STATION AND GPS FIELD SURVEY AND TOWN OF SAINT ALBANS, TOWN OF SWANTON AND REFERENCED LAND AND HIGHWAY RECORDS. THIS PLAT MEETS THE REQUIREMENTS OF 27 VSA SECTION 1403.

© 2017  
 horizons  
 Engineering Inc.  
 All rights reserved

**horizons**  
 Engineering Inc.  
 17 Sunset Terrace  
 Newport, Vermont 05855  
 Phone 802.334.6434 - Fax 802.334.5602

STATUTORY SURVEY PREPARED FOR  
**VERMONT AGENCY OF TRANSPORTATION**  
 1 NATIONAL LIFE DRIVE  
 MONTPELIER, VT 05633-5001  
 OF U.S. ROUTE 7  
 TOWN OF ST. ALBANS, TOWN OF SWANTON  
 FRANKLIN COUNTY, VERMONT

	DATE:	PROJECT #:
	1/12/2017	15522
	SURV'D BY:	DRAWN BY:
	JN, AN, JB	JN, NN
CHECK'D BY:	SCALE:	
AN	1"=40'	
SHEET 16 OF 43		

HORIZONS ENGINEERING INC. CERTIFIES THAT THIS DRAWING WAS PRODUCED AS AN ORIGINAL INK ON MYLAR  
 SIGNATURE