


PIN ID# 16x605

horizons Engineering Inc.
 17 Sunset Terrace
 Newport, Vermont 05855
 Phone 802.334.6434 - Fax 802.334.5602

STATUTORY SURVEY PREPARED FOR
VERMONT AGENCY OF TRANSPORTATION
 1 NATIONAL LIFE DRIVE
 MONTPELIER, VT 05633-5001
 OF U.S. ROUTE 7
 TOWN OF ST. ALBANS, TOWN OF SWANTON
 FRANKLIN COUNTY, VERMONT

	DATE:	PROJECT #:
	1/12/2017	15522
	SURV'D BY:	DRAWN BY:
	JN, AN, JB	JN, NN
CHECK'D BY:	SCALE:	
AN	1"=40'	
SHEET 19 OF 43		

MONUMENT DETAIL TABLE			
MON. NO.	COORDINATE	STATION	DESCRIPTION
1811	N 862441.98 E 1485415.65	154+88.49 49.50' RIGHT	5/8" REBAR SET 1.0' ABOVE GRADE
1888	N 862423.49 E 1485318.39	154+88.49 49.50' LEFT	5/8" REBAR SET BELOW GRADE
1812	N 862827.66 E 1485362.62	158+83.04 49.50' RIGHT	FENO TYPE MONUMENT SET 1.5' ABOVE GRADE
1889	N 862819.21 E 1485263.98	158+83.04 49.50' LEFT	5/8" REBAR SET BELOW GRADE
1813	N 863055.77 E 1485343.09	161+11.99 49.50' RIGHT	5/8" REBAR SET 0.8' ABOVE GRADE
1890	N 863047.33 E 1485244.45	161+11.99 49.50' LEFT	FENO TYPE MONUMENT SET 1.2' ABOVE GRADE
20246	N 862601.01 E 1485388.64	156+51.90 49.25' RIGHT	1/2" REBAR FOUND 1.0' ABOVE GRADE

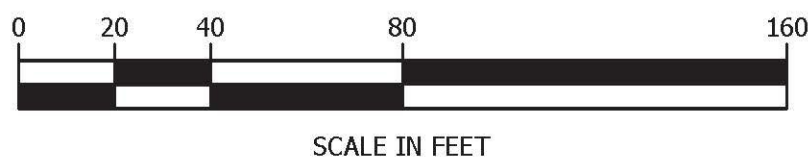

NATHAN P. NADEAU, LS

I CERTIFY THAT THIS IS A CORRECT SURVEY TO THE BEST OF MY KNOWLEDGE BASED UPON AN EDM TOTAL STATION AND GPS FIELD SURVEY AND TOWN OF SAINT ALBANS, TOWN OF SWANTON AND REFERENCED LAND AND HIGHWAY RECORDS. THIS PLAT MEETS THE REQUIREMENTS OF 27 VSA SECTION 1403.

© 2017 horizons Engineering
 All rights reserved

HORIZONS ENGINEERING INC. CERTIFIES THAT THIS DRAWING WAS PRODUCED AS AN ORIGINAL INK ON MYLAR

SIGNATURE