

MATCH LINE SHEET 20


MATCH LINE SHEET 22

PIN ID# 16x605

MONUMENT DETAIL TABLE			
MON. NO.	COORDINATE	STATION	DESCRIPTION
1816	N 864066.16 E 1485368.27	171+29.89 49.50 RIGHT	5/8" REBAR SET AT GRADE
1893	N 864070.69 E 1485269.38	171+29.89 49.50' LEFT	5/8" REBAR SET AT GRADE
10072	N 864649.89 E 1485394.99	177+14.32 49.50' RIGHT	5/8" REBAR SET AT GRADE
1817	N 864690.51 E 1485396.85	177+54.89 49.50' RIGHT	UNMONUMENTED POINT
1894	N 864695.04 E 1485297.95	177+54.89 49.50 LEFT	FENO TYPE MONUMENT SET AT GRADE
1818	N 864765.22 E 1485400.07	178+29.40 49.50' RIGHT	UNMONUMENTED POINT
1895	N 864769.21 E 1485301.15	178+29.40 49.50' LEFT	5/8" REBAR SET AT GRADE
10069	N 864776.41 E 1485400.52	178+40.60 49.50' RIGHT	FENO TYPE MONUMENT SET AT GRADE

MONUMENT DETAIL TABLE			
MON. NO.	COORDINATE	STATION	DESCRIPTION
2431	N 864319.34 E 1485280.59	173+78.79 49.67' LEFT	1/2" REBAR FOUND 1' ABOVE GRADE
2435	N 864352.19 E 1485381.30	174+16.21 49.44' RIGHT	2" I.D. IRON PIPE FOUND 0.1' BELOW GRADE
2432	N 864513.59 E 1485289.44	175+73.25 49.71' LEFT	1/2" REBAR FOUND 0.2' ABOVE GRADE

NATHAN P. NADEAU, LS
 I CERTIFY THAT THIS IS A CORRECT SURVEY TO THE BEST OF MY KNOWLEDGE BASED UPON AN EDM TOTAL STATION AND GPS FIELD SURVEY AND TOWN OF SAINT ALBANS, TOWN OF SWANTON AND REFERENCED LAND AND HIGHWAY RECORDS. THIS PLAT MEETS THE REQUIREMENTS OF 27 VSA SECTION 1403.

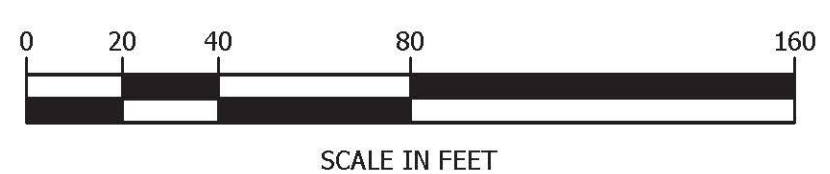

SCALE IN FEET

horizons
Engineering Inc.

17 Sunset Terrace
Newport, Vermont 05855
Phone 802.334.6434 - Fax 802.334.5602

STATUTORY SURVEY PREPARED FOR
VERMONT AGENCY OF TRANSPORTATION
 1 NATIONAL LIFE DRIVE
 MONTPELIER, VT 05633-5001
 OF U.S. ROUTE 7
 TOWN OF ST. ALBANS, TOWN OF SWANTON
 FRANKLIN COUNTY, VERMONT

	DATE:	PROJECT #:
	1/12/2017	15522
	SURV'D BY:	DRAWN BY:
	JN, AN, JB	JN, NN
CHECK'D BY:	SCALE:	
AN	1"=40'	
SHEET 21 OF 43		

© 2017
horizons
 Engineering Inc.
 All rights reserved

HORIZONS ENGINEERING INC. CERTIFIES THAT THIS DRAWING WAS PRODUCED AS AN ORIGINAL INK ON MYLAR SIGNATURE