

MATCH LINE SHEET 21


MATCH LINE SHEET 23

PIN ID# 16x605

MONUMENT DETAIL TABLE

MON. NO.	COORDINATE	STATION	DESCRIPTION
10067	N 865269.07 E 1485420.39	183+33.66 49.50' RIGHT	FENO TYPE MONUMENT SET AT GRADE
1896	N 865326.90 E 1485323.64	183+87.54 49.50' LEFT	FENO TYPE MONUMENT SET AT GRADE
1819	N 865339.52 E 1485423.23	184+04.17 49.50' RIGHT	UNMONUMENTED POINT
1819A	N 865343.51 E 1485324.31	184+04.17 49.50' LEFT	UNMONUMENTED POINT
2337	N 864970.58 E 1485410.55	180+35.02 51.69' RIGHT	5/8" REBAR FOUND AT GRADE W/CAP MARKED "RLS 509"

NATHAN P. NADEAU, LS
 I CERTIFY THAT THIS IS A CORRECT SURVEY TO THE BEST OF MY KNOWLEDGE BASED UPON AN EDM TOTAL STATION AND GPS FIELD SURVEY AND TOWN OF SAINT ALBANS, TOWN OF SWANTON AND REFERENCED LAND AND HIGHWAY RECORDS. THIS PLAT MEETS THE REQUIREMENTS OF 27 VSA SECTION 1403.

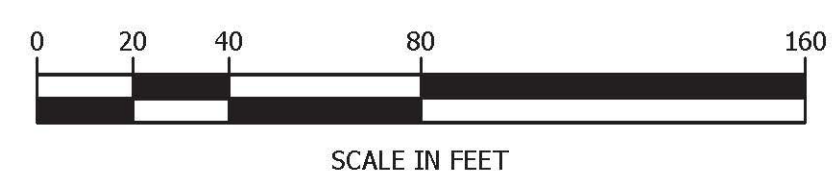

17 Sunset Terrace
Newport, Vermont 05855
Phone 802.334.6434 - Fax 802.334.5602

STATUTORY SURVEY PREPARED FOR

VERMONT AGENCY OF TRANSPORTATION

1 NATIONAL LIFE DRIVE
MONTPELIER, VT 05633-5001

OF U.S. ROUTE 7
TOWN OF ST. ALBANS, TOWN OF SWANTON
FRANKLIN COUNTY, VERMONT

	DATE:	PROJECT #:
	1/12/2017	15522
	SURV'D BY:	DRAWN BY:
	JN, AN, JB	JN, NN
CHECK'D BY:	SCALE:	
AN	1"=40'	

SHEET 22 OF 43

HORIZONS ENGINEERING INC. CERTIFIES THAT THIS DRAWING WAS PRODUCED AS AN ORIGINAL INK ON MYLAR

SIGNATURE

© 2017 horizons Engineering
All rights reserved