

NEW ENGLAND CENTRAL RAILROAD
TRACS

CHERYL DECELLE
BOOK 253, PAGE 112


CLIFFORD BOUCHARD
LIFE ESTATE
BOOK 261, PAGE 61
BR 44

ERIC CHEVALIER &
DIANE CHEVALIER
BOOK 215, PAGE 568
BR 43

NATHAN P. NADEAU, LS

I CERTIFY THAT THIS IS A CORRECT SURVEY TO THE BEST OF MY KNOWLEDGE BASED UPON AN EDM TOTAL STATION AND GPS FIELD SURVEY AND TOWN OF SAINT ALBANS, TOWN OF SWANTON AND REFERENCED LAND AND HIGHWAY RECORDS. THIS PLAT MEETS THE REQUIREMENTS OF 27 VSA SECTION 1403.

MONUMENT DETAIL TABLE			
MON. NO.	COORDINATE	STATION	DESCRIPTION
2552	N 867677.60 E 1485444.20	208+05.51 49.50' RIGHT	FENO TYPE MONUMENT SET AT GRADE
2551	N 867737.04 E 1485365.03	208+05.51 49.50' LEFT	FENO TYPE MONUMENT SET AT GRADE

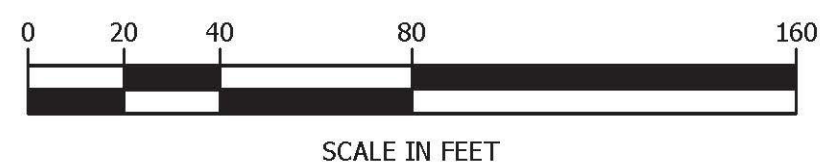

PIN ID# 16x605

17 Sunset Terrace
Newport, Vermont 05855
Phone 802.334.6434 - Fax 802.334.5602

STATUTORY SURVEY PREPARED FOR
VERMONT AGENCY OF TRANSPORTATION
1 NATIONAL LIFE DRIVE
MONTPELIER, VT 05633-5001
OF U.S. ROUTE 7
TOWN OF ST. ALBANS, TOWN OF SWANTON
FRANKLIN COUNTY, VERMONT

DATE: 1/12/2017	PROJECT #: 15522
SURV'D BY: JN, AN, JB	DRAWN BY: JN, NN
CHECK'D BY: AN	SCALE: 1"=40'

SHEET 25 OF 43

HORIZONS ENGINEERING INC. CERTIFIES THAT THIS DRAWING WAS PRODUCED AS AN ORIGINAL INK ON MYLAR

SIGNATURE

© 2017
horizons
Engineering
All rights reserved