

MATCH LINE SHEET 25

MATCH LINE SHEET 27

HORIZONS ENGINEERING INC. CERTIFIES THAT THIS DRAWING WAS PRODUCED AS AN ORIGINAL INK ON MYLAR

SIGNATURE

**MONUMENT DETAIL TABLE**


| MON. NO. | COORDINATE                  | STATION                   | DESCRIPTION                     |
|----------|-----------------------------|---------------------------|---------------------------------|
| 1825     | N 868132.95<br>E 1485786.05 | 213+74.90<br>49.50' RIGHT | FENO TYPE MONUMENT SET AT GRADE |
| 2458     | N 868192.51<br>E 1485706.98 | 213+75.06<br>49.50' LEFT  | FENO TYPE MONUMENT SET AT GRADE |
| 1825A    | N 868137.83<br>E 1485789.72 | 218+03.35<br>49.50' RIGHT | UNMONUMENTED POINT              |
| 2458A    | N 868197.27<br>E 1485710.55 | 218+03.35<br>49.50' LEFT  | UNMONUMENTED POINT              |
| 1826     | N 868492.28<br>E 1486028.30 | 218+03.35<br>49.50' RIGHT | 5/8" REBAR SET AT GRADE         |
| 2459     | N 868543.26<br>E 1485943.43 | 218+03.35<br>49.50' LEFT  | 5/8" REBAR SET AT GRADE         |

**MONUMENT DETAIL TABLE**

| MON. NO. | COORDINATE                  | STATION                   | DESCRIPTION                                 |
|----------|-----------------------------|---------------------------|---|
| 1992     | N 868186.95<br>E 1485703.07 | 213+68.26<br>49.29' LEFT  | 1" I.D. IRON PIPE FOUND<br>2' ABOVE GRADE   |
| 1903     | N 868683.60<br>E 1486139.47 | 220+91.92<br>52.19' RIGHT | 1" I.D. IRON PIPE FOUND<br>AT GRADE         |
| 1901     | N 868840.92<br>E 1486140.19 | 221+61.91<br>18.50' LEFT  | 1" I.D. IRON PIPE FOUND<br>1.2' ABOVE GRADE |
| 1902     | N 868821.05<br>E 1486206.97 | 221+73.16<br>50.26' RIGHT | 1" I.D. IRON PIPE FOUND<br>AT GRADE         |

NATHAN P. NADEAU, LS

I CERTIFY THAT THIS IS A CORRECT SURVEY TO THE BEST OF MY KNOWLEDGE BASED UPON AN EDM TOTAL STATION AND GPS FIELD SURVEY AND TOWN OF SAINT ALBANS, TOWN OF SWANTON AND REFERENCED LAND AND HIGHWAY RECORDS. THIS PLAT MEETS THE REQUIREMENTS OF 27 VSA SECTION 1403.

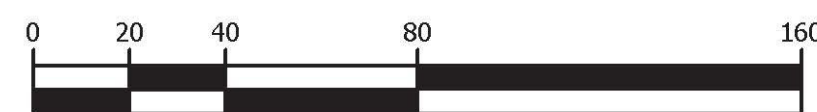

SCALE IN FEET

© 2017  
horizons  
Engineering  
All rights reserved

PIN ID# 16x605

17 Sunset Terrace  
Newport, Vermont 05855  
Phone 802.334.6434 - Fax 802.334.5602

STATUTORY SURVEY PREPARED FOR

**VERMONT AGENCY  
OF TRANSPORTATION**

1 NATIONAL LIFE DRIVE  
MONTPELIER, VT 05633-5001

OF U.S. ROUTE 7  
TOWN OF ST. ALBANS, TOWN OF SWANTON  
FRANKLIN COUNTY, VERMONT

|             |            |            |
|-------------|------------|------------|
|             | DATE:      | PROJECT #: |
|             | 1/12/2017  | 15522      |
|             | SURV'D BY: | DRAWN BY:  |
|             | JN, AN, JB | JN, NN     |
| CHECK'D BY: | SCALE:     |            |
| AN          | 1"=40'     |            |

SHEET 26 OF 43