

MATCH LINE SHEET 26

MATCH LINE SHEET 28

PIN ID# 16x605


**horizons**  
Engineering Inc.

17 Sunset Terrace  
Newport, Vermont 05855  
Phone 802.334.6434 - Fax 802.334.5602

STATUTORY SURVEY PREPARED FOR  
**VERMONT AGENCY  
OF TRANSPORTATION**  
1 NATIONAL LIFE DRIVE  
MONTPELIER, VT 05633-5001  
OF U.S. ROUTE 7  
TOWN OF ST. ALBANS, TOWN OF SWANTON  
FRANKLIN COUNTY, VERMONT

	DATE:	PROJECT #:
	1/12/2017	15522
	SURV'D BY:	DRAWN BY:
	JN, AN, JB	JN, NN
CHECK'D BY:	SCALE:	
AN	1"=40'	
<b>SHEET 27 OF 43</b>		

NATHAN P. NADEAU, LS  
I CERTIFY THAT THIS IS A CORRECT SURVEY TO THE BEST OF MY KNOWLEDGE BASED UPON AN EDM TOTAL STATION AND GPS FIELD SURVEY AND TOWN OF SAINT ALBANS, TOWN OF SWANTON AND REFERENCED LAND AND HIGHWAY RECORDS. THIS PLAT MEETS THE REQUIREMENTS OF 27 VSA SECTION 1403.

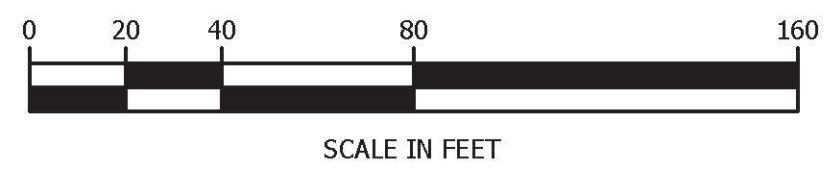

© 2017  
**horizons**  
Engineering Inc.  
All rights reserved

MONUMENT DETAIL TABLE

MON. NO.	COORDINATE	STATION	DESCRIPTION
1827	N 868996.89 E 1486286.23	223+63.74 49.50' RIGHT	UNMONUMENTED POINT
2460	N 869035.82 E 1486195.20	223+63.74 49.50' LEFT	UNMONUMENTED POINT
10054	N 869043.16 E 1486198.34	223+71.72 49.50' LEFT	FENO TYPE MONUMENT SET AT GRADE
10055	N 869032.30 E 1486301.37	224+02.24 49.50' RIGHT	FENO TYPE MONUMENT SET AT GRADE
1828	N 869332.59 E 1486429.80	227+28.85 49.50' RIGHT	5/8" REBAR SET AT GRADE
2461	N 869371.52 E 1486338.78	227+28.85 49.50' LEFT	5/8" REBAR SET AT GRADE

MONUMENT DETAIL TABLE

MON. NO.	COORDINATE	STATION	DESCRIPTION
1717	N 869317.28 E 1486349.75	226+83.30 18.08' LEFT	1" I.D. IRON PIPE FOUND 0.4' BELOW GRADE
1716	N 869432.91 E 1486397.86	228+08.52 19.31' LEFT	1-1/4" I.D. IRON PIPE FOUND 0.1' BELOW GRADE

HORIZONS ENGINEERING INC. CERTIFIES THAT THIS DRAWING WAS PRODUCED AS AN ORIGINAL INK ON MYLAR SIGNATURE