

PIN ID# 16x605

horizons
Engineering Inc.

17 Sunset Terrace
Newport, Vermont 05855
Phone 802.334.6434 - Fax 802.334.5602

STATUTORY SURVEY PREPARED FOR

**VERMONT AGENCY
OF TRANSPORTATION**


1 NATIONAL LIFE DRIVE
MONTPELIER, VT 05633-5001

OF U.S. ROUTE 7
TOWN OF ST. ALBANS, TOWN OF SWANTON
FRANKLIN COUNTY, VERMONT

	DATE:	PROJECT #:
	1/12/2017	15522
	SURV'D BY:	DRAWN BY:
	JN, AN, JB	JN, NN
CHECK'D BY:	SCALE:	
AN	1"=40'	
SHEET 28 OF 43		

NATHAN P. NADEAU, LS

I CERTIFY THAT THIS IS A CORRECT SURVEY TO THE BEST OF MY KNOWLEDGE BASED UPON AN EDM TOTAL STATION AND GPS FIELD SURVEY AND TOWN OF SAINT ALBANS, TOWN OF SWANTON AND REFERENCED LAND AND HIGHWAY RECORDS. THIS PLAT MEETS THE REQUIREMENTS OF 27 VSA SECTION 1403.

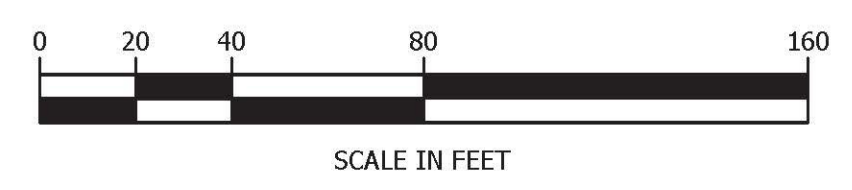

© 2017
horizons
Engineering Inc.
All rights reserved

MONUMENT DETAIL TABLE

MON. NO.	COORDINATE	STATION	DESCRIPTION
2553	N 869627.69 E 1486556.01	230+49.80 49.50' RIGHT	FENO TYPE MONUMENT SET AT GRADE
1829	N 869668.19 E 1486573.33	230+93.85 49.50' RIGHT	UNMONUMENTED POINT
2462	N 869707.12 E 1486482.30	230+93.85 49.50' LEFT	FENO TYPE MONUMENT SET AT GRADE
1830	N 870227.14 E 1486847.82	237+22.03 49.50' RIGHT	5/8" REBAR SET AT GRADE
2463	N 870275.37 E 1486761.36	237+22.03 49.50' LEFT	5/8" REBAR SET AT GRADE

MONUMENT DETAIL TABLE

MON. NO.	COORDINATE	STATION	DESCRIPTION
1550	N 869841.75 E 1486646.18	232+83.54 45.26' RIGHT	1/2" REBAR FOUND 0.7' ABOVE GRADE W/CAP MARKED "BROOKS RLS 557"
1549	N 869959.32 E 1486621.31	233+79.19 27.68' LEFT	3/4" IRON SPIKE FOUND AT GRADE
1548	N 869952.80 E 1486692.95	234+04.76 39.57' RIGHT	5/8" REBAR FOUND AT GRADE
1438	N 870387.99 E 1486846.42	238+61.82 30.08' LEFT	1-1/2" IRON ROD FOUND 0.4' ABOVE GRADE

HORIZONS ENGINEERING INC. CERTIFIES THAT THIS DRAWING WAS PRODUCED AS AN ORIGINAL INK ON MYLAR SIGNATURE