

MATCH LINE SHEET 28

MATCH LINE SHEET 30

PIN ID# 16x605

**horizons**  
Engineering Inc.

17 Sunset Terrace  
Newport, Vermont 05855  
Phone 802.334.6434 - Fax 802.334.5602

STATUTORY SURVEY PREPARED FOR

**VERMONT AGENCY OF TRANSPORTATION**


1 NATIONAL LIFE DRIVE  
MONTPELIER, VT 05633-5001

OF U.S. ROUTE 7  
TOWN OF ST. ALBANS, TOWN OF SWANTON  
FRANKLIN COUNTY, VERMONT

	DATE:	PROJECT #:
	1/12/2017	15522
	SURV'D BY:	DRAWN BY:
	JN, AN, JB	JN, NN
CHECK'D BY:	SCALE:	
AN	1"=40'	
SHEET 29 OF 43		

NATHAN P. NADEAU, LS

I CERTIFY THAT THIS IS A CORRECT SURVEY TO THE BEST OF MY KNOWLEDGE BASED UPON AN EDM TOTAL STATION AND GPS FIELD SURVEY AND TOWN OF SAINT ALBANS, TOWN OF SWANTON AND REFERENCED LAND AND HIGHWAY RECORDS. THIS PLAT MEETS THE REQUIREMENTS OF 27 VSA SECTION 1403.

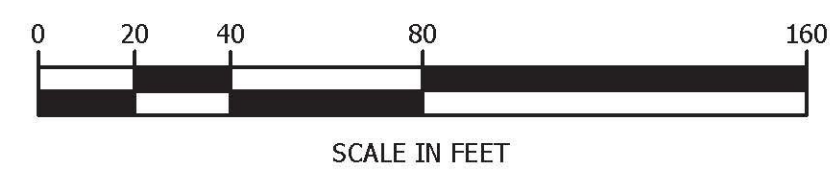

© 2017  
**horizons**  
Engineering Inc.  
All rights reserved

MONUMENT DETAIL TABLE

MON. NO.	COORDINATE	STATION	DESCRIPTION
1831	N 870536.55 E 1487020.42	240+76.32 49.50' RIGHT	5/8" REBAR SET AT GRADE
2464	N 870584.78 E 1486933.96	240+76.32 49.50' RIGHT	5/8" REBAR SET AT GRADE
10044	N 870884.89 E 1487101.37	244+19.98 49.50' LEFT	FENO TYPE MONUMENT SET AT GRADE
2465	N 870890.44 E 1487104.47	244+26.32 49.50' LEFT	UNMONUMENTED POINT
1832	N 870842.21 E 1487190.92	244+26.32 49.50' RIGHT	FENO TYPE MONUMENT SET AT GRADE

MONUMENT DETAIL TABLE

MON. NO.	COORDINATE	STATION	DESCRIPTION
1393	N 870724.88 E 1487089.87	242+74.63 18.41' RIGHT	1" IRON U-POST FOUND 0.1' BELOW GRADE
1347	N 870831.48 E 1487105.05	243+75.12 20.27' LEFT	1-1/2" I.D. IRON PIPE FOUND 0.1' BELOW GRADE
1345	N 871035.41 E 1487258.26	246+26.49 21.39' RIGHT	2" I.D. IRON PIPE FOUND 0.2' BELOW GRADE

SIGNATURE

HORIZONS ENGINEERING INC. CERTIFIES THAT THIS DRAWING WAS PRODUCED AS AN ORIGINAL INK ON MYLAR