

MATCH LINE SHEET 29

MATCH LINE SHEET 31

STANLEY CAPSEY &
MARGARET CAPSEY
BOOK 142, PAGES 244-245

ROBERT CYR &
BEVERLY CYR
BOOK 87, PAGE 13

RANDALL BEGINS
BOOK 323, PAGES 449-450

MARK STENTA &
CYNTHIA STENTA
BOOK 215, PAGE 622

REGENCY HOUSING LLC
BOOK 333, PAGES 259-260
BR 48 & 49

MILTON ROBISON
BOOK 271, PAGES 64-65

DANIEL MOORE &
TRACI MOORE
BOOK 238, PAGE 247

BRIAN HAYS &
KELLY HAYS
BOOK 283, PAGES 141-143

MILTON ROBISON
BOOK 271, PAGES 64-65

ROBERT QUILLIAM &
SHIRLEY QUILLIAM
BOOK 98, PAGE 76

RONALD SEYMOUR &
AVIS SEYMOUR
BOOK 215, PAGES 42-43
BR 49

REGENCY HOUSING LLC
BOOK 333, PAGES 259-260
BR 48 & 49

PIN ID# 16x605

MONUMENT DETAIL TABLE


MON. NO.	COORDINATE	STATION	DESCRIPTION
1833	N 871287.15 E 1487391.28	249+06.40 49.50' RIGHT	UNMONUMENTED POINT
2466	N 871319.92 E 1487297.86	249+06.40 49.50' LEFT	FENO TYPE MONUMENT SET AT GRADE
2605	N 8714470.35 E 1487350.63	250+65.83 49.50' LEFT	5/8" REBAR SET AT GRADE
1834	N 871465.92 E 1487453.99	250+95.86 49.50' RIGHT	FENO TYPE MONUMENT SET AT GRADE
2467	N 871498.69 E 1487360.58	250+95.86 49.50' LEFT	UNMONUMENTED POINT

MONUMENT DETAIL TABLE

MON. NO.	COORDINATE	STATION	DESCRIPTION
1304	N 871269.14 E 1487357.79	248+78.56 24.00' RIGHT	1" I.D. IRON PIPE FOUND AT GRADE
1248	N 871680.25 E 1487494.91	253+01.51 46.94' RIGHT	1/2" IRON ROD FOUND 1.8' ABOVE GRADE
1212	N 871893.57 E 1487485.92	255+02.19 53.07' RIGHT	5/8" IRON ROD FOUND 0.8' ABOVE GRADE - THETFORD

NATHAN P. NADEAU, LS

I CERTIFY THAT THIS IS A CORRECT SURVEY TO THE BEST OF MY KNOWLEDGE BASED UPON AN EDM TOTAL STATION AND GPS FIELD SURVEY AND TOWN OF SAINT ALBANS, TOWN OF SWANTON AND REFERENCED LAND AND HIGHWAY RECORDS. THIS PLAT MEETS THE REQUIREMENTS OF 27 VSA SECTION 1403.

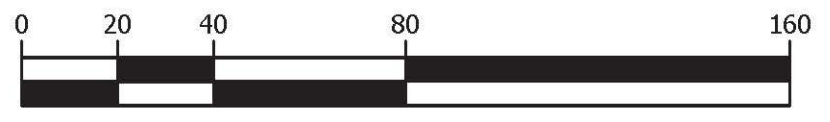

SCALE IN FEET

© 2017
horizons
Engineering
All rights reserved

horizons
Engineering Inc.


17 Sunset Terrace
Newport, Vermont 05855
Phone 802.334.6434 - Fax 802.334.5602

STATUTORY SURVEY PREPARED FOR

VERMONT AGENCY OF TRANSPORTATION

1 NATIONAL LIFE DRIVE
MONTPELIER, VT 05633-5001

OF U.S. ROUTE 7
TOWN OF ST. ALBANS, TOWN OF SWANTON
FRANKLIN COUNTY, VERMONT

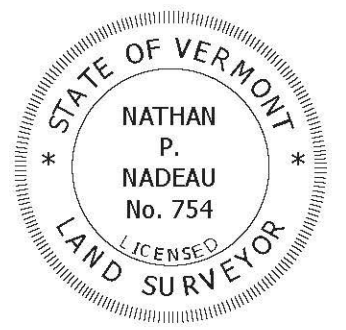

DATE:	PROJECT #:
1/12/2017	15522
SURV'D BY:	DRAWN BY:
JN, AN, JB	JN, NN
CHECK'D BY:	SCALE:
AN	1"=40'

SHEET 30 OF 43

HORIZONS ENGINEERING INC. CERTIFIES THAT THIS DRAWING WAS PRODUCED AS AN ORIGINAL INK ON MYLAR

SIGNATURE