

MATCH LINE SHEET 33

MATCH LINE SHEET 35

PIN ID# 16x605

horizons
Engineering Inc.

17 Sunset Terrace
Newport, Vermont 05855
Phone 802.334.6434 - Fax 802.334.5602

STATUTORY SURVEY PREPARED FOR

VERMONT AGENCY OF TRANSPORTATION


1 NATIONAL LIFE DRIVE
MONTPELIER, VT 05633-5001

OF U.S. ROUTE 7
TOWN OF ST. ALBANS, TOWN OF SWANTON
FRANKLIN COUNTY, VERMONT

	DATE:	PROJECT #:
	1/12/2017	15522
	SURV'D BY:	DRAWN BY:
	JN, AN, JB	JN, NN
CHECK'D BY:	SCALE:	
AN	1"=40'	
SHEET 34 OF 43		

NATHAN P. NADEAU, LS

I CERTIFY THAT THIS IS A CORRECT SURVEY TO THE BEST OF MY KNOWLEDGE BASED UPON AN EDM TOTAL STATION AND GPS FIELD SURVEY AND TOWN OF SAINT ALBANS, TOWN OF SWANTON AND REFERENCED LAND AND HIGHWAY RECORDS. THIS PLAT MEETS THE REQUIREMENTS OF 27 VSA SECTION 1403.

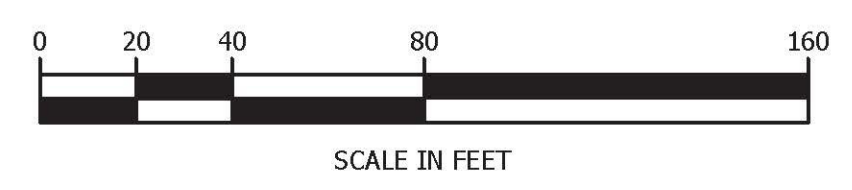

© 2017
horizons
Engineering
All rights reserved

MONUMENT DETAIL TABLE

MON. NO.	COORDINATE	STATION	DESCRIPTION
1842	N 874405.61 E 1486465.85	282+03.88 49.50' RIGHT	5/8" REBAR SET AT GRADE
2475	N 874366.92 E 1486374.73	282+03.88 49.50' LEFT	UNMONUMENTED POINT
2476	N 874476.73 E 1486328.09	283+23.18 49.50' LEFT	FENO TYPE MONUMENT SET AT GRADE
1843	N 874550.96 E 1486404.12	283+61.79 49.50' RIGHT	FENO TYPE MONUMENT SET AT GRADE
1844	N 874995.56 E 1486215.31	288+44.82 49.50' RIGHT	5/8" REBAR SET AT GRADE
2477	N 874956.86 E 1486124.19	288+44.82 49.50' LEFT	5/8" REBAR SET AT GRADE

MONUMENT DETAIL TABLE

MON. NO.	COORDINATE	STATION	DESCRIPTION
937	N 874371.93 E 1486464.94	281+73.32 35.53' RIGHT	1" I.D. IRON PIPE FOUND 2' ABOVE GRADE
938	N 874561.76 E 1486400.25	283+73.25 50.16' RIGHT	6"X6" CONCRETE BOUND 0.3' ABOVE GRADE
891	N 874658.12 E 1486280.32	285+08.82 22.57' LEFT	1" I.D. IRON PIPE FOUND 2' ABOVE GRADE
841	N 874731.99 E 1486329.18	285+57.71 51.28' RIGHT	5/8" REBAR FOUND 0.5' ABOVE GRADE W/CAP MARKED "SCOTT TAYLOR"

HORIZONS ENGINEERING INC. CERTIFIES THAT THIS DRAWING WAS PRODUCED AS AN ORIGINAL INK ON MYLAR SIGNATURE