


MONUMENT DETAIL TABLE			
MON. NO.	COORDINATE	STATION	DESCRIPTION
1845	N 875248.18 E 1486100.80	291+19.83 49.50' RIGHT	5/8" REBAR SET AT GRADE
2478	N 875205.15 E 1486011.64	291+19.83 49.50' LEFT	5/8" REBAR SET AT GRADE
1846	N 875480.03 E 1485988.92	293+77.27 49.50' RIGHT	UNMONUMENTED POINT
2479	N 875437.01 E 1485899.76	293+77.27 49.50' LEFT	FENO TYPE MONUMENT SET AT GRADE
1847	N 875609.80 E 1485933.91	295+23.08 49.50' RIGHT	UNMONUMENTED POINT
2480	N 875575.63 E 1485840.99	295+23.08 49.50' LEFT	5/8" REBAR SET AT GRADE

MONUMENT DETAIL TABLE			
MON. NO.	COORDINATE	STATION	DESCRIPTION
807	N 875307.85 E 1485993.54	292+20.19 21.16' LEFT	1" I.D. IRON PIPE FOUND 0.6' ABOVE GRADE - (LEANING)
753	N 875539.60 E 1485863.38	294+82.66 41.48' LEFT	1/2" IRON ROD 4' ABOVE GRADE
752	N 875715.85 E 1485787.34	296+73.20 51.46' LEFT	5/8" REBAR FOUND 0.1' BELOW GRADE

NATHAN P. NADEAU, LS  
 I CERTIFY THAT THIS IS A CORRECT SURVEY TO THE BEST OF MY KNOWLEDGE BASED UPON AN EDM TOTAL STATION AND GPS FIELD SURVEY AND TOWN OF SAINT ALBANS, TOWN OF SWANTON AND REFERENCED LAND AND HIGHWAY RECORDS. THIS PLAT MEETS THE REQUIREMENTS OF 27 VSA SECTION 1403.

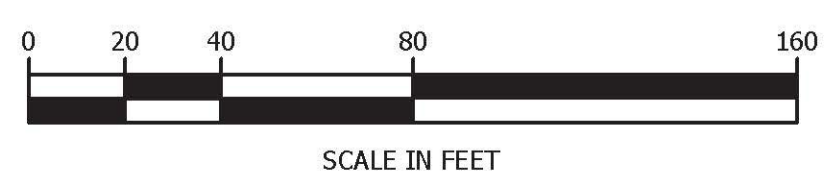

PIN ID# 16x605

**horizons**  
Engineering Inc.

17 Sunset Terrace  
Newport, Vermont 05855  
Phone 802.334.6434 - Fax 802.334.5602

STATUTORY SURVEY PREPARED FOR  
**VERMONT AGENCY  
 OF TRANSPORTATION**  
 1 NATIONAL LIFE DRIVE  
 MONTPELIER, VT 05633-5001  
 OF U.S. ROUTE 7  
 TOWN OF ST. ALBANS, TOWN OF SWANTON  
 FRANKLIN COUNTY, VERMONT

	DATE:	PROJECT #:
	1/12/2017	15522
	SURV'D BY:	DRAWN BY:
	JN, AN, JB	JN, NN
CHECK'D BY:	SCALE:	
AN	1"=40'	
<b>SHEET 35 OF 43</b>		

HORIZONS ENGINEERING INC. CERTIFIES THAT THIS DRAWING WAS PRODUCED AS AN ORIGINAL INK ON MYLAR  
 SIGNATURE

© 2017  
 horizons  
 Engineering  
 All rights reserved